ADDENDUM NO. 002 (Rev 01/2017)

ISSUE DATE: 03/12/2024

RE: GRAINGER HALL 2ND & 5TH FLOOR RENOVATION

PHASE 2 - 5^{TH} FLOOR OFFICE RENOVATION & PHASE 3 - 2^{ND} FLOOR NW CORNER RENOVATION

UNIVERSITY OF WISCONSIN-MADISON

610 WALNUT STREET MADISON, WISCONSIN

UWSA Project No. A-22-021 UW Madison Project No. 0140-2303

BID OPENING: MEP Bidders: 2:00 P.M., March 19, 2024

GPC Bidders: 2:00 P.M., April 02, 2024

FROM: **DESTREE DESIGN ARCHITECTS, INC.**

222 W. Washington Ave. #310

Madison, WI 53703 Phone: (608) 268.1499

TO: Prospective Bidders

This addendum forms a part of the Contract Documents and modifies the original Contract Documents dated **February 20, 2024** as noted below. Acknowledge receipt of this Addendum by inserting the number and issue date of this addendum in the blank space provided on the Bid Form. Failure to do so may subject the Bidder to disqualification.

This Addendum consists of **3 pages** and the attached documents: BID FORM – MECHANICAL, ELECTRICAL, PLUMBING, AND FIRE PROTECTION (MEP), Phase 2 Sheets E000, ES101, E401, E500 & Phase 3 Sheets A201, E000, ED101, ES101, E401, E500.

CHANGES TO BIDDING REQUIREMENTS:

- 1. **REPLACE:** The BID FORM MECHANICAL, ELECTRICAL, PLUMBING, AND FIRE PROTECTION (MEP) in the MEP Volume 1 specifications to be replaced with the attachment Bid Form to correct the second page of the form.
- 2. **REPLACE:** On sheet A-2 in the MEP INVITATION TO BIDDERS lines 34 & 35 to be replaced with the following. **Base Bid will be received as a single lump sum bid for: 2) Fire Protection (Fire Suppression); 3) Plumbing; 4) Mechanical (Heating, Ventilating, Air Conditioning); and 5) Electrical.**

CHANGES TO CONDITIONS OF THE CONTRACT:

1. N/A

CHANGES TO SPECIFICATIONS (DIVISIONS 2 THRU 33):

- 1. **REMOVE:** Specification 28 10 00, page 2, line 1, remove the following: Card Readers
- 2. **ADD:** Specification 28 10 00, page 2, line 13-14, add the following: -with wiring to head-end. Obtain pricing and models from UW Police (see below).
- 3. **ADD:** Specification 28 10 00, page 2, line 21, add the following: Panic Buttons with wiring to head-end
- 4. **ADD:** Specification 28 10 00, page 2, line 29, add the following: Final programming for access control and panic buttons.
- 5. **ADD:** Specification 28 10 00, page 2, line 35, add the following: Contact at UW Police Department for security devices is Patrick Bucci, Patrick.bucci@wisc.edu, 608-469-9877.

CHANGES TO DRAWINGS:

- 1. Phase 2 Drawings
 - a. Sheet E000
 - i. **REVISE:** The lighting fixture schedule has been updated with notes in regard to the size of the Mutto Light Fixture Size so that the larger 16.5" diameter fixture is to be used. See Sheet E000.
 - ii. **REVISE:** The lighting fixture schedule has been updated in regard to the size of the L1B. L1 and L2 fixtures. See Sheet E000.
 - b. Sheet ES101
 - i. **REVISE:** General Note 2. Correct spelling of "APPLIFIERS" to AMPLIFIERS. Then add the following after the period: PROVIDE SHOP DRAWINGS INDICATING CODE-COMPLIANT PLACEMENT OF NEW SPEAKERS, STROBES, PULL STATIONS AND OTHER REQUIRED DEVICES. See Sheet ES101.
 - c. Sheet E401
 - i. **REVISED:** Keyed Demolition Note 1. Note change to REMOVE AND REPLACE BUS AND BREAKERS TO REDUCE ARC FLASH PROTECTION REQUIREMENTS, COORDINATE WITH ONWER FOR OUTAGE SCHEDULE. See Sheet E401.
 - ii. **ADD:** Keyed New Work Notes. Add keynote 2, INSTALL PANEL BUS AND BREAKERS TO REDUCE ARC FLASH PROTECTION REQUIRMENTS. PROVIDE 14KA AIC RATING FOR PANEL. COORDINATE WITH OWNER FOR OUTAGE SCHEUDLE. See sheet E401.
 - d. Sheet E500
 - i. **ADD**: The required AIC rating added to the new panelboard schedules. See Sheet E500.
 - ii. **REVISED**: The panel note for panelboard 5/4Q has been removed. See Sheet E500.

2. Phase 3 Drawings

- a. Sheet A201.
 - i. **ADD:** Add keynote 9. Keynote to read, "GPC to demo the GWB ceiling as needed for the above ceiling plumbing and mechanical work. GPC to install GWB and paint the entire ceiling PT-7." See Sheet A201.
- b. Sheet E000
 - i. **REVISE:** The lighting fixture schedule has been updated with notes in regard to the size of the Mutto Light Fixture Size so that the larger 16.5" diameter fixture is to be used. See Sheet E000.
 - ii. **REVISE:** The lighting fixture schedule has been updated in regard to the size of the L1B, L1 and L2 fixtures. See Sheet E000.
- c. Sheet ED101
 - i. **REVISE:** Demolition Note 5 to be revised. Remove last sentence "SEE NEW WORK FOR PRECISE LOCATIONS." See Sheet ED101.
- d. Sheet ES101
 - i. **REVISE:** General Note 2. Correct spelling of "APPLIFIERS" to AMPLIFIERS. Then add the following after the period: PROVIDE SHOP DRAWINGS INDICATING CODE-COMPLIANT PLACEMENT OF NEW SPEAKERS, STROBES, PULL STATIONS AND OTHER REQUIRED DEVICES. See Sheet ES101.
- e. Sheet E401
 - i. **REVISED:** Keyed Demolition Note 1. Note change to REMOVE AND REPLACE BUS AND BREAKERS TO REDUCE ARC FLASH PROTECTION REQUIREMENTS, COORDINATE WITH ONWER FOR OUTAGE SCHEDULE.
 - ii. ADD: Keyed New Work Notes. Add keynote 2, INSTALL PANEL BUS AND BREAKERS TO REDUCE ARC FLASH PROTECTION REQUIRMENTS. PROVIDE 14KA AIC RATING FOR PANEL. COORDINATE WITH OWNER FOR OUTAGE SCHEUDLE. See Sheet E401.
- f. Sheet E500
 - i. **ADD**: The required AIC rating added to the new panelboard schedules. See Sheet E500.
 - ii. **ADD**: Panel notes for panelboards 2/H SECT1(DEMO) and 2H5/4Q (DEMO) has been added the schedules. See Sheet E500.

GENERAL QUESTIONS/CLARIFICATIONS:

- 1. Rooms 2243, 2462 and 4432 are mentioned on the ES prints in the key plans of 2nd and 5th floors. Those notations are related to GENERAL NOTES: 1 on both sheets. General note 1 mentions the headend locations of security panels may be outside of the project scope and to contact UW Police (see contact above) for clarification and access. This mentioning was to warn that security wiring may extend hundreds of feet outside of project scope and add some additional labor and material for that wiring.
- 2. For the L1B, L1 and L2 fixtures the size of them are all the same at 1.5" and have been updated accordingly on the plans.
- 3. The building's central freight elevator will be available for contractor use during construction. The freight elevator is located in the center of the main east-west corridor of the building and is approximately 175 +/- from the 5th floor area of work."
- 4. The single line drawings and panels schedules have been updated to address the question of whether the electrical distribution equipment is to be replaced or added to for the project.
- 5. The substitution request for Vetrotech Fire-Rated Aluminum Framed Entrances and Storefronts has not been accepted.
- 6. The substitution request for Speedflow Plus Electric Hand Dryer has not been accepted.
- 7. The substitution request for Scranton Phenolic Core Toilet Compartments has not been accepted.
- 8. The substitute request for Frasch Acoustical Panel Treatments has not been accepted.

END OF ADDENDUM

DESTREE DESIGN ARCHITECTS, INC. 222 W. Washington Ave. #310 Madison, WI 53703

Phone: (608) 268.1499

The University of Wisconsin - Madison 1860 Van Hise Hall, 1220 Linden Drive Madison, Wisconsin 53706

BID FORM – MECHANICAL, ELECTRICAL, PLUMBING, AND FIRE PROTECTION (MEP) (Rev 11/2022) THE BOARD OF REGENTS OF THE UNIVERSITY OF WISCONSIN SYSTEM

s.16.855 Wis. Stats.

GRAINGER HALL 2ND & 5TH FLOOR RENOVATION PHASE 2 – 5TH FLOOR OFFICE RENOVATION & PHASE 3 – 2ND FLOOR NW CORNER RENOVATION UNIVERSITY OF WISCONSIN - MADISON MADISON, WISCONSIN

UW-MADISON Project No. 0140-2303 / UWSA Project No. A-22-021

Mechanical, Electrical, Plumbing, and Fire Protection (MEP) Bid Opening: 2:00 P.M., March 19, 2024.

To: University of	of Wisconsin Syste	em Administration (UWSA)				(a joint venture)
We						(a partnership) (an individual)
vve					(Cros	s out inapplicable)
Of						
	Street	City		State	Zip	
above and to fu no later than ter and material re accordance with	rnish satisfactory : n (10) days after e quired for the cons n the Bidding Doct	tract with the General Prime separate 100% Performanc xecution of the subcontract struction of the project designments prepared by Destre he Owner and dated Febru	ce Bond and 100% with the General Fignated above, for ee Design Archite	Payment Prime Cont the prices	Bond in the ractor, and hereinafter	e amount specified to provide all labor set forth, in strict
(For use by Ge	neral Prime Contra	actor to offer subcontract to	the successful ME	P bidders	identified th	nrough UWSA)
	Contact name	:				
	Telephone Nu	mber				

IMPORTANT: BEFORE SUBMITTING YOUR BID, PLEASE VERIFY THAT:

- 1. You have been **certified by DOA as a qualified and responsible bidder** for the amount of your bid within the division(s) of work being bid.
- 2. You have entered all Bid amounts in numeric characters (Example: \$9,999);
- 3. You have acknowledged receipt of all addenda;
- 4. You have signed the Bid Form
- 5. You have **included a valid Bid Guarantee** for not less than 10% of the value of the bid as either:

Email address:

FAX Number:

- a) a Bid Bond signed by the contractor and surety, with a Power of Attorney attached, or
- b) a Cashier's Check or Bank Check pursuant to Wis. Stat. s. 779.14(1m)(c)2.b. and 779.14(1s). A Company or Personal Check will not be accepted.

	BID NO. 2 Fire Suppression Work fully complete as per Bidding Documents, for the sum of
(\$	Enter bid amount in numeric characters only (Example: \$9,999). See MEP Instructions to Bidders
	Letter bid amount in numeric characters only (Example: \$9,999). See MEP Instructions to Bidders 16 Submission of Base Bids' for detailed instructions.
	To Gubiniosion of Buse Bus for detailed metadatoris.
<u>PLUM</u>	BING
5405	
	BID NO. 3 Plumbing Work fully complete as per Bidding Documents, for the sum of
(\$	Enter bid amount in numeric characters only (Example: \$9,999). See MEP Instructions to Bidders
	Enter bid amount in numeric characters only (Example: \$9,999). See MEP Instructions to Bidders 16 Submission of Base Bids' for detailed instructions.
<u>HEAT!</u>	ING, VENTILATING AND AIR CONDITIONING
חאסר	DID NO. A Harding Vandilating Air Oard Harding Work falls account to a Didding Decount to the
DASE	BID NO. 4 Heating, Ventilating, Air Conditioning Work fully complete as per Bidding Documents, for the
(\$	Enter bid amount in numeric characters only (Example: \$9,999). See MEP Instructions to Bidders
	Enter bid amount in numeric characters only (Example: \$9,999). See MEP Instructions to Bidders 16 Submission of Base Bids' for detailed instructions.
ELEC ⁻	<u>TRICAL</u>
BASE	BID NO. 5 Electrical Work fully complete as per Bidding Documents for the sum of
	BID NO. 5 Electrical Work fully complete as per Bidding Documents for the sum of
BASE (\$	
	BID NO. 5 Electrical Work fully complete as per Bidding Documents for the sum of Enter bid amount in numeric characters only (Example: \$9,999). See MEP Instructions to Bidders 16 Submission of Base Bids' for detailed instructions.
(\$	Enter bid amount in numeric characters only (Example: \$9,999). See MEP Instructions to Bidders
(\$	Enter bid amount in numeric characters only (Example: \$9,999). See MEP Instructions to Bidders 16 Submission of Base Bids' for detailed instructions. BINED BASE BIDS OPTION
(\$	Enter bid amount in numeric characters only (Example: \$9,999). See MEP Instructions to Bidders 16 Submission of Base Bids' for detailed instructions. BINED BASE BIDS OPTION BID NO for(Division of Work), BID NO for(Division of Work) and
COME BASE BASE BASE BASE	Enter bid amount in numeric characters only (Example: \$9,999). See MEP Instructions to Bidders 16 Submission of Base Bids' for detailed instructions. BINED BASE BIDS OPTION BID NO for (Division of Work), BID NO for (Division of Work) and BID NO for (Division of Work) and
COME BASE BASE BASE BASE BASE	Enter bid amount in numeric characters only (Example: \$9,999). See MEP Instructions to Bidders 16 Submission of Base Bids' for detailed instructions. BINED BASE BIDS OPTION BID NO for (Division of Work), BID NO for (Division of Work) and BID NO for (Division of Work) and BID NO for (Division of Work) Work fully complete as per specifications and relating the submission of the submission of Work fully complete as per specifications and relating the submission of Work).
COME BASE BASE BASE BASE BASE	Enter bid amount in numeric characters only (Example: \$9,999). See MEP Instructions to Bidders 16 Submission of Base Bids' for detailed instructions. BINED BASE BIDS OPTION BID NO for(Division of Work), BID NO for(Division of Work) and

	r.	
	NDUM RECEIPT knowledge receipt of the follow	ng Addenda:
Addendum No		Date
		Date
Adder	dum No	Date
Adder	dum No	Date
THE F	POSSIBILITY OF INVALIDATING	
BY SI	GNING THIS BID FORM, THE I	SIDDER ATTESTS TO PERSONAL KNOWLEDGE OF THE FOLLOWING
1.	Bidder is <u>certified</u> by DOA a division(s) of work being bid	s a qualified and responsible bidder for the amount of the bid submitted, w
2.		a subcontract with the General Prime Contractor in accordance with Wis. of these Bidding Documents.
3.	forms in detail before submi directly or indirectly, entere	awings and specifications, carefully prepared the bid form, and has revieting bid; and bidder, or the agents, officers, or employees thereof, have not into any agreement, bid rigging, bid rotation, participated in any collunates restraint of free competitive bidding in connection with this bid.
4.	necessary materials, labor,	ned at the Bidder's own proper cost and expense, that the Bidder will futools, machinery, apparatus, and other means of construction in the pecifications, and at the time stated in the General Prime Contractor's N
		(Firm Name)
(Seal,	if bid is by a corporation)	(Bidder's Printed Name)
		By (Signature of Bidder)
Date:		(Signature at Ridder)

33

A, AMP	AMPERE	MMS	MANUAL MOTOR STARTER SWITCH
AC	ABOVE COUNTER	MOA	MULTI-OUTLET ASSEMBLY
AFF	ABOVE FINISHED FLOOR	MPS	MOTORIZED PROJECTION SCREEN
AIC	AMPERE INTERRUPTING CAPACITY	MTS	MOTOR RATED TOGGLE SWITCH
ACT	ACUOSTICAL CEILING TILE	MTR	MOTOR
AL	ALUMINUM	MC	MECHANICAL CONTRACTOR
ARCH	ARCHITECT, ARCHITECTURE	MFR	MANUFACTURER
ATS	AUTOMATIC TRANSFER SWITCH	MWS	MOTORIZED WINDOW SHADE
AUX	AUXILIARY	N/C	NORMALLY CLOSED
AV	AUDIO - VISUAL	N/O	NORMALLY OPEN
AP	ACCESS PANEL	NEC	NATIONAL ELECTRICAL CODE
ВС	BELOW COUNTER	NEMA	NATIONAL ELECTRICAL MFR'S ASSOC
BTM	ВОТТОМ	NF	NON-FUSED SAFETY SWITCH
С	CONDUIT	NIC	NOT IN CONTRACT
СВ	CIRCUIT BREAKER	nl	NIGHT LIGHT
CCTV	CLOSED CIRCUIT TELEVISION	NTS	NOT TO SCALE
CLG	CEILING	O.C.	ON CENTER
COFF	COFFEE MAKER	OL	OVERLOADS
CRT	CATHODE-RAY TUBE	Р	POLE
C/T	CURRENT TRANSFORMER	PF	POWER FACTOR
CU	COPPER	PH	PHASE
CTR	COUNTER	PNL	PANEL
DC	DIRECT CURRENT	PP	PUSH PLATE, AUTO DOOR OPERATOR
DED	DEDICATED	РВ	PULLBOX
DISC	DISCONNECT	PRI	PRIMARY
DO	DOOR OPERATOR, POWERED	P/T	POTENTIAL TRANSFORMER
DN	DOWN	PVC	POLYVINYL CHLORIDE
DW	DISHWASHER	PC	PLUMBING CONTRACTOR
EC	ELECTRICAL CONTRACTOR	RMC	RIGID METALLIC CONDUIT
ECB	ENCLOSED CIRCUIT BREAKER	REF	REFRIGERATOR
ELEC	ELECTRIC, ELECTRICAL	REQD	REQUIRED
EM	EMERGENCY	RVT	REDUCED VOLTAGE TRANSFORMER
EMT	ELECTRICAL METALLIC TUBING	S/N	SOLID NEUTRAL
EQ	EQUIPMENT	SPEC	SPECIFICATION
EWC	ELECTRIC WATER COOLER	SPKR	SPEAKER
ETR	EXISTING TO REMAIN	SP	SPARE
EX	EXISTING	SPD	SURGE PROTECTION DEVICE
EF	EXHAUST FAN	SW	SWITCH
EPO	EMERGENCY POWER OFF	SWBD	SWITCHBOARD
EXT	EXTERIOR	SWGR	SWITCHGEAR
FA	FIRE ALARM	SQFT	SQUARE FOOT
FLR	FLOOR	SS	STAINLESS STEEL
FVNR	FULL VOLTAGE NON-REVERSING	SC	SECURITY CONTRACTOR
FD	FIRE DEPARTMENT	TEL	TELEPHONE
FSD	FIRE SMOKE DAMPER	TERM	TERMINAL
F	FUSED SAFETY SWITCH	XFMR	TRANSFORMER
GFCI	GROUND FAULT CIRCUIT INTERRUPTER	TC	TIME CLOCK
G	GROUND FAULT CIRCUIT INTERRUPTER	TCP	TEMPERATURE CONTROL PANEL
ND, GRD	GROUND	TV	TELEVISION
GC	GENERAL CONTRACTOR	TYP	TYPICAL
GD	GARBAGE DISPOSAL, SINK MOUNTED	EU	UNDERGROUND ELECTRICAL
HOA	HAND-OFF-AUTOMATIC SWITCH	UG	UNDERGROUND
HP	HORSEPOWER	UH	UNIT HEATER
HV	HIGH VOLTAGE	UT	UNDERGROUND TELEPHONE
HC	HEATING CONTRACTOR	UOD	UNLESS OTHERWISE DENOTED
HD	HAND DRYER	V	VOLT
HVAC	HEATING, VENTILATING, AIR CONDITIONING	VA	VOLT AMPERES
IMC	INTERMEDIATE METALLIC CONDUIT	VFD	VARIABLE FREQUENCY DRIVE
JB	JUNCTION BOX	VOL	VOLUME
KV	KILOVOLT	VC	VENTILATION CONTRACTOR
KVA	KILOVOLT-AMPERE	W	WATT
KVAR	KILOVOLT-AMPERE REACTIVE	W/	WITH
KWH	KILOWATT HOUR	W/O	WITHOUT
KW	KILOWATT	WG	WIRE GUARD/PROTECTIVE SHIELDING
LV	LOW VOLTAGE	WP	WEATHERPROOF
MCC	MOTOR CONTROL CENTER	2S1W	2 SPEED SINGLE WINDING
MCP	MOTOR CIRCUIT PROTECTOR	2S2W	2 SPEED DOUBLE WINDING
МСВ	MAIN CIRCUIT BREAKER	TFA	TO FLOOR ABOVE
MICRO	MICROWAVE OVEN	TFB	TO FLOOR BELOW
MIN	MINIMUM	UCR	UNDERCOUNTER REFRIGERATOR
MISC	MISCELLANEOUS	DIV. 26	DIVISION 26 CONTRACTOR
MLO	MAIN LUGS ONLY	_,,,_,	
	MOLDED CASE SWITCH		

NOTE: THIS IS A COMPOSITE LIST OF ABBREVIATIONS, NOT ALL PERTAIN SPECIFICALLY TO THIS JOB.

GENERAL NEW WORK NOTES:

- 1) ALL BRANCH CIRCUITS SHALL HAVE EQUIPMENT GROUND CONDUCTORS.
- 2) THE ELECTRICAL CONTRACTOR SHALL PROVIDE, IF REQUIRED, ADJUSTMENTS (±) 6'-0" IN THE LOCATION OF ALL SYSTEM DEVICES, FIXTURES, OUTLETS, PANELS, ETC. IN ORDER TO EXPEDITE THE ELECTRICAL WORK. THE POSITION OF ALL WORK AS SHOWN IS INTENDED TO BE FIXED AND IN THE PROPER LOCATION. SUCH REQUIRED ADJUSTMENT SHALL BE DETERMINED BY THE A/E..
- 3) PROVIDE SEPARATE NEUTRAL FOR EACH BRANCH CIRCUIT PHASE CONDUCTOR.
- 4) SEE ARCHITECTURAL SHEETS FOR EXACT LOCATION OF DEVICES. DEVICES SHOWN ON ARCHITECTURAL ELEVATIONS. COORDINATE LOCATION OF DEVICES WITH ARCHITECT'S FIELD PERSON TO ENSURE PROPER LOCATION AND HEIGHT.
- 5) WHERE NEW DEVICES ARE SHOWN THE ELECTRICAL CONTRACTOR SHALL DO ALL CUTTING. THE GENERAL CONTRACTOR SHALL DO ALL PATCHING AND PAINTING OF EXISTING WALLS. THE ELECTRICAL CONTRACTOR SHALL FAMILIARIZE HIMSELF WITH EXISTING WALL CONSTRUCTION.
- 6) SMOKE DETECTORS SHALL BE MOUNTED A MINIMUM OF 6'-0". FROM EACH AIR SUPPLY DIFFUSER.

GENERAL ELECTRICAL DEMOLITION REQUIREMENTS:

- ELECTRICAL CONTRACTOR SHALL BE RESPONSIBLE FOR HIS OWN DEMOLITION, REMOVAL, CAPPING, STORING, ABANDONING, DISCONNECTING, RELOCATING AND RECONNECTION OF EXISTING ELECTRICAL EQUIPMENT AND MATERIAL. ALL CUTTING, PATCHING, REPAIRING, REPLACEMENT AND REFINISHING, SHALL MATCH THE EXISTING CONSTRUCTION AS NEARLY AS POSSIBLE.
- EXCEPT WHERE OTHERWISE SHOWN OR NOTED ON DRAWING "TO BE RETAINED, RELOCATED" OR HEREINAFTER NOTED, ALL EXISTING ELECTRICAL EQUIPMENT AND MATERIAL IN AREAS TO BE REMODELED/ALTERED SHALL BE REMOVED WHERE THEY INTERFERE WITH PROPOSED NEW CONSTRUCTION AND/OR INTERFERE WITH PROPOSED USAGE OF SPACE BY OWNER AS FOLLOWS:
- A) REMOVE ANY CONDUITS PROTRUDING ABOVE FINISHED FLOOR, CAP AND FINISH OVER WITH FLOOR MATERIAL TO MATCH EXISTING.
- B) REMOVE ALL LIGHT FIXTURES, RECEPTACLES, SWITCHES, ETC. AND ASSOCIATED WIRING. REMOVE ALL SURFACE MOUNTED CONDUIT/BOXES AND THEIR ASSOCIATED WIRING.
- REMOVE ALL CONCEALED RACEWAYS, BOXES AND WIRING FROM PARTITIONS BEING DEMOLISHED.
- D) REMOVE ALL EXISTING WIRING/CABLING FROM ALL EXISTING CONCEALED RACEWAYS IN PARTITION THAT ARE TO REMAIN.
- E) ANY FEEDERS, CONDUITS, BRANCH CIRCUITS, SIGNAL AND TELEPHONE CIRCUITS, ETC. PASSING THROUGH THE REMODELED AREAS TO SERVE (OR BE SERVED FROM) EXISTING ADJACENT, REMOTE OR SURROUNDING AREAS THAT ARE TO REMAIN, SHALL BE RETAINED AND KEPT OPERATIONAL AND SHALL BE REROUTED IN ALL CASES WHERE THEY INTERFERE WITH ANY NEW WORK OR USAGE TO BE ACCOMPLISHED IN THE REMODELED AREA.
- F) WHERE DEVICES ARE OMITTED FROM PRESENT BRANCH CIRCUITS, THE REMAINING DEVICES SHALL BE REWIRED, IF NEEDED AND AS REQUIRED, TO REMAIN ON THEIR RESPECTIVE CIRCUITS AND IN OPERATING CONDITION.
- 6) ELECTRICAL CONTRACTOR SHALL REFER TO ARCHITECTURAL DRAWINGS TO FAMILIARIZE HIMSELF WITH EXTENT OF ALTERATION/REMODELING WORK AND MORE SPECIFICALLY NOTE WHERE NEW PARTITIONING IS BEING INSTALLED, WHERE EXISTING PARTITIONING IS BEING REMOVED, WHERE CEILINGS ARE BEING REMOVED AND OR REPLACED, ETC.
- ALL WIRING (POWER, LIGHTING) NOT REUSED FOR REMODELING AREAS SHALL BE COMPLETELY REMOVED BACK TO ASSOCIATED PANELS.

	FIRE ALARM SYSTEM
SYMBOL	DESCRIPTION
FACP	FIRE ALARM CONTROL PANEL
FAAP	FIRE ALARM ANNUNCIATOR PANEL
BATT	REMOTE BATTERY CABINET
NAC	NOTIFICATION APPLIANCE CIRCUIT EXTENDER
AMP	AMPLIFIER CABINET, AUDIO RISER CABINET
	FIRE ALARM PULL STATION
M	FIRE ALARM MINI HORN
H	FIRE ALARM HORN/STROBE
s	FIRE ALARM SPEAKER
S∳-	FIRE ALARM SPEAKER/STROBE
S∳ _{WP}	FIRE ALARM SPEAKER/STROBE, EXTERIOR WEATHERPROOF
◎	CEILING MOUNTED FIRE ALARM SPEAKER/STROBE
®	CEILING MOUNTED FIRE ALARM SPEAKER
\bigcirc	CEILING MOUNTED FIRE ALARM STROBE
	FIRE ALARM STROBE, (##) IS CANDELA RATING
(S)	INTELLIGENT PHOTOELECTRIC SMOKE DETECTOR
Ø _{ER}	INTELLIGENT PHOTOELECTRIC SMOKE DETECTOR FOR ELEVATOR RECALL
H	INTELLIGENT 135F FIXED & RATE OF RISE HEAT DETECTOR
ØS AHU-x	INTELLIGENT PHOTOELECTRIC DUCT SMOKE DETECTOR
	ASSOCIATED VENTILATION EQUIPMENT FOR SHUT DOWN.
ММ	MONITOR MODULE
СМ	CONTROL MODULE
DH	MAGNETIC DOOR HOLDER
TS	SPRINKLER TAMPER SWITCH
FS	SPRINKLER FLOW SWITCH
R	FAN SHUTDOWN RELAY
RTS/I	REMOTE TEST SWITCH W/INDICATOR

TELECOMMUNICATIONS SYSTEMS								
SYMBOL	DESCRIPTION							
▼ ^X	DATA							
₹X	DATA ABOVE COUNTER							
AV	BACK BOX ONLY FOR AUDIO VISUAL EQUIPMENT							
▼ X	TELECOMMUNICATIONS ABOVE COUNTER							
▼ ^X	TELECOMMUNICATIONS, FLOOR MOUNTED							
\bigcirc X	TELECOMMUNICATIONS, CEILING MOUNTED							
WAP	WIRELESS ACCESS POINT (CEILING-MOUNTED DATA) - (2) DATA CABLES							
CR	CARD READER							
KP	KEY PAD							
CAM	CAMERA ROUGH IN - (1) DATA CABLE							
SCH	ROOM SCHEDULER - (1) DATA CABLE, COIL 10 FT ABOVE LOCATION							
ES	ELECTRIC STRIKE							
B	BELL							

X = NUMBER OF DATA/CONNECTORS NOTE: THIS IS A COMPOSITE LIST, NOT ALL SPECIFIC TO THIS PROJECT.

	POWER SYSTEMS
SYMBOL	DESCRIPTION
SWBD 1	LARGE ELECTRICAL EQUIPMENT WITH DESIGNATION - DRAWN TO SCALE
	DISTRIBUTION PANEL WITH DESIGNATION
65550	BRANCH PANEL WITH DESIGNATION
\(\)	MOTOR WITH DESIGNATION
	DISCONNECT SWITCH
J	JUNCTION BOX
РВ	PULL BOX
PT	POKE-THRU MODULAR FURNITURE FEED, POWER
□ x	EQUIPMENT CONNECTION
© X	EQUIPMENT CONNECTION - EMERGENCY — CONNECTION TYPES: REFER TO EQUIPMENT CONNECTION SCHEDULE(S)
PP (H	AUTOMATIC DOOR OPERATOR ACTIVATION PUSH PLATE
ЕРО 开	EMERGENCY POWER OFF STATION
1	DENOTES WALL MOUNTING
14 (FF) W 2C,2N+G	SYSTEM FURNITURE BASE FEED LOCATION (2) 2 GANG JUNCTION BOXES: (1) POWER, (1) LOW VOLTAGE
20.21110	MOUNTING CONFIGURATION: W - WALL PP - POWER POLE/SYSTEMS FURNITURE
	— CONDUCTOR QUANTITY
	#C = QTY PHASE CONDUCTORS #N = QTY NUETRAL CONDUCTORS G = EQUIPMENT GROUND
	— CIRCUIT NUMBER(S)
⊠ PP	POWER POLE

SYMBOL	DESCRIPTION
Ф	SIMPLEX RECEPTACLE
Ф	SIMPLEX RECEPTACLE ABOVE COUNTER
ф ××	DUPLEX RECEPTACLE DUPLEX RECEPTACLE TYPES: EWC - ELECTRIC WATER COOLER, PROVIDE GFCI BREAKER IN ELEC PANEL G - GROUND FAULT CIRCUIT INTERRUPTER TV - TELEVISION OUTLET T - TAMPER RESISTANT W - WEATHER RESISTANT PRJ - CEILING MOUNTED VIDEO PROJECTOR USB - USB CHARGING DEVICE, REFER TO SPEC FOR CONFIGURATION
#	DUPLEX RECEPTACLE ABOVE COUNTER
#	DOUBLE DUPLEX RECEPTACLE
FB	SYSTEM FLOORING - FLOOR MOUNTED DUPLEX RECEPTACLE BY FLOORING CONTRACTOR
ZB	SYSTEM FLOORING ZONE BOX - UNDER FLOOR SYSTEM MOUNTED BY FLOORING CONTRACTOR
+	CEILING MOUNTED DUPLEX RECEPTACLE
⊠ PP	POWER POLE
SR 0	RECEPTACLES IN SURFACE RACEWAY ASSEMBLY — RACEWAY DESIGNATION, SEE SURFACE RACEWAY SCHEDULE

		LIGHTING FIXTURES
	SYMBOL	DESCRIPTION
	O F1 23 a	FIXTURE TYPE CIRCUIT CONTROL DEVICE
	0	SURFACE/ RECESSED LINEAR MOUNT, NORMAL POWER
		SURFACE/ RECESSED LINEAR MOUNT, EMERGENCY POWER
		LINEAR WALL WASH, NORMAL POWER
		LINEAR WALL WASH, EMERGENCY POWER
		LINEAR PENDANT, NORMAL POWER
		LINEAR WALL MOUNTED, NORMAL POWER
	\vdash	SURFACE/SUSPENDED MOUNT, NORMAL POWER
	\vdash	SURFACE/SUSPENDED MOUNT, EMERGENCY POWER
\	0	SURFACE / RECESSED DOWNLIGHT, NORMAL POWER
)	•	SURFACE / RECESSED DOWNLIGHT, EMERGENCY POWER
	0>	SURFACE / RECESSED WALL WASH, NORMAL POWER
	•>	SURFACE / RECESSED WALL WASH, EMERGENCY POWER
	Ю	WALL MOUNTED SCONCE OR WALLPACK, NORMAL POWER
	⊢●	WALL MOUNTED SCONCE OR WALLPACK, EMERGENCY POWER
	₩	EXIT SIGN, CEILING MOUNTED - FACES AND ARROWS AS SHOWN
	\times	EXIT SIGN, WALL MOUNTED - FACES AND ARROWS AS SHOWN
	<u> \$</u>	BATTERY PACK EMERGENCY LIGHTING
	1	DENOTES WALL MOUNTING OF LIGHT

1		SWITCHES
_	SYMBOL	DESCRIPTION
	ко х	SINGLE POLE (LOWER CASE LETTER INDICATES SWITCH LEG) — SWITCH TYPES: 2 - DOUBLE POLE 3 - THREE WAY 4 - FOUR WAY D - DIMMER OS - OCCUPANCY SENSOR MWS - MOTORIZED WINDOW SHADE STATION
L	H X	LOW VOLTAGE LIGHTING CONTROL SYSTEM SWITCH (LOWER CASE LETTER INDICATES SWITCH LEG) SWITCH TYPES: 2B - 2 BUTTON (VIVE) 3BRL - 3 BUTTON WITH RAISE LOWER (VIVE)
	SC	SCENE CONTROL
	©S osa	OCCUPANCY SENSOR SWITCHING DESIGNATION
<u> </u>	(√s) osa	VACANCY SENSOR — SWITCHING DESIGNATION
	ER	EMERGENCY LIGHTING CONTROL RELAY, UL924 LISTED WITH 0-10V SHUNT
7	PS	PHOTOSENSOR
		ILING OCCUPANCY/VACANCY SENSORS SERVING VAV SERVED AREAS AUXILLIARY CONTACT FOR DDC OCCUPANCY SETBACK SIGNAL I.

LINE WEIGHT KEY

ALL ITEMS INDICATED BY A DARK SOLID LINE ARE NEW ALL ITEMS INDICATED BY A LIGHT SOLID LINE ARE EXISTING TO REMAIN ----- ALL ITEMS INDICATED BY A DARK DASHED LINE ARE EXISTING TO BE REMOVED OR RELOCATED.

														NG FIX TURE	SCHEDULE			
	FIXTURE	,			LAMP			BALLA	ST/DRIVER		MOUNTING MANUFACTURER							
ID	DESCRIPTION	DIFFUSER	WATTS	TYPE TEMP	CRI	LUMENS	TYPE	DIMTYPE	DIM RANGE	VOLTAGE	LOCATION	CONFIGURATION	SURFACE TYPE	HEIGHT	NAME	MODEL NUMBER S	SEE NOTE	COMMENTS
A1	2x2 LENSED TROFFER	ACRYLIC	33	LED 4000K	90	4563	ELD	0-10V	1-100%	MVOLT	CEILING	RECESSED	ACT	FLUSH WITH CEILING	LITHONIA	STAKS 2X2 AL03 SWW7		
C2			18	LED 4000K	84	310/FT	ELD	0-10V	1-100%	MVOLT	CEILING	SURFACE	CABINET	UNDER CABINET	SOLID STATE LUMINAIRES	UNLE-3-4K-WH POWER SUPPLY-UN100i-DIM		
D1	ADJUSTABLE DOWNLIGHT		11.4	LED 4000K	90	1000	ELD	0-10V	10-100%	MVOLT	CEILING	RECESSED	ACT	FLUSH WITH CEILING	GOTHAM	EVO4WW-WDIM-40/10-AR-LSS-MVOLT-GZ10-90CRI		
D2	ADJUSTABLE DOWNLIGHT			LED 4000K	1	1000	ELD	0-10V	10-100%	MVOLT	CEILING	RECESSED	ACT	FLUSH WITH CEILING	GOTHAM	EVO4-WDIM-40/10-AR-LSS-MD-MVOLT-GZ10-90CRI	·····	~~~~~~~~~~~~~~~~~~~~~~~~~~~~~~~~~~~~~~~
L1	SUSPENDED LINEAR LED DIRECT/INDIRECT CONTINUOUS RUN LENGTH	ACRYLIC LENS	5.66/FT	LED 4000K	90	700/FT	ELD	0-10V	1-100%	MVOLT	CEILING	SUSPENDED	VARIES	SEE DWG	LUMENWERX	VIA1.5P-DI-HLO-0.5D-HLO-SW-90-350-350-40-CONTINUOUS RUN*-UNV-D1-2C-EC-STS-W		
L1E	CONTINUOUS RUN LENGTH	ACRYLIC LENS	5.66/FT	LED 4000K	90	700/FT	ELD	0-10V	1-100%	MVOLT	CEILING	SUSPENDED	VARIES	SEE DWG	LUMENWERX	VIA1.5P-DI-HLO-0.5D-HLO-SW-90-350-350-40-CONTINUOUS RUN*-UNV-D1-2C-EC-STS-B		
L2	CONTINUOUS RUN LENGTH	ACRYLIC LENS		LED 4000K	90	700/FT	ELD	0-10V	1-100%	MVOLT	CEILING	RECESSED	VARIES	FLUSH WITH CEILING	LUMENWERX	VIA1.5P-D-HLO-0.5D-SW-90-350-350-40-CONTINUOUS RUN*-UNV-D1-1C-EC-MFM-W		FER TO FLOOR PLAN FOR CONTINUOUS I LENTHS WITH EMERGENCY SECTIONS.
P1	RING PEND LIGHT			LED 4000K	90	D-750/FT I-750/FT	ELD	0-10V	1-100%		CEILING	SUSPENDED		SEE DWG	LUMENWERX	CURV2RIP-DI-12FT-HLO-HLO-SW-90CRI-750LMF-750MF-40K-UNV-D1-1C-BAC-W-MC-##IN-B		
P2 <u>~~</u>	6" CYLINDER PENDANT		~~~~	LED 4000K		*******	ELD	0-10V	1-100%	MVOLT	CEILING	PENDANT		SEE DWG	GOTHAM	EVO6-40/10-AR-LSS-MVOLT-RGH-PCAN45XW-S8-DBL	******	······
Р3	MUTTO FLUID PENDANT LAMP		5	LED 3000K	90	260	ELD	0-10V	1-100%	120V	CEILING	PENDANT		SEE DWG	MUUTO	100301994	* TH	E LARGER OF THE FIXTURE TYPES TO BE USEI
P4	LOUIS POULSEN PENDANT		22	LED 3000K	80			0-10V	1-100%	MVOLT	CEILING	PENDANT		SEE DWG	LOUIS POULSEN	PH5-WHT-WHT		
P5			4.3	LED 3000K	80		ELD	0-10V	1-100%	MVOLT	CEILING	PENDANT		SEE DWG	MODERN FORMS	PD-82006-BK		
P6	DOUBLE BUBBLE PENDANT WITH CANOPY	,	4.3	LED 3000K	80		ELD	0-10V	1-100%	MVOLT	CEILING	PENDANT		SEE DWG	MODERN FORMS	PD-82006-BK	17" I	DIAMETER CANOPY BLACK FINISH
S1	48" LINEAR LED STRIP LIGHT	ACRYLIC LENS	31	LED 4000K	90		ELD	0-10V	10-100%	MVOLT	CEILING	SURFACE		CEILING	METALUX	4SNLED-LD5-46SL-UNV-EL7W-L940-CD1-U		
T1	SUSPENDED TRACK LIGHTING			LED 4000K	90		ELD	0-10V	10-100%	MVOLT	CEILING	SUSPENDED		SEE DWG	WAC	H-2020-940-BK-LENS-16-SPR		
W1	WALL SCONCE - GENERAL			LED 3000K	85		ELD	0-10V	10-100%	MVOLT	WALL	SURFACE	GWB	SEE DWG	MARSET	A701-001		
W2	WALL SCONCE			LED 4000K	90	2585	ELD	0-10V	10-100%	120V	WALL	SURFACE	GWB	SEE DWG	WAC	WS-35849		
X1	THERMOPLASTIC UNIVERSAL MOUNT LED EXIT SIGN RED LETTERS		2.3	LED			ELD			MVOLT	CEILING	SURFACE	ACT	TBD	CHLORIDE ISOLITE SURELITES	VE SERIES RL-AC-R-U-WH-MTEB APX SERIES	1,2	

ABBREVIATIONS:

- A. REFER TO INTERIOR LIGHTING SPECIFICATIONS FOR ADDITIONAL INFORMATION REGARDING FIXTURE, BALLAST OR DRIVER REQUIREMENTS AND INSTALLATION REQUIREMENTS.
- B. NOTED LUMEN QUANTITY IS DELIVERED LUMEN OUTPUT C. NOTED DIMMING RANGE INDICATES MINIMUM PARAMETERS. LUMINAIRES WITH GREATER DIMMING RANGE ARE PERMITED.
- D. FIXTURES NOTED IN THIS SCHEDULE ARE TO ESTABLISH A BASIS OF DESIGN. PRODUCTS OTHER THAN THOSE LISTED IN THE SCHEDULE ARE PERMITTED SUBJECT TO MEETING THE REQUIREMENTS OF THE SCHEDULED FIXTURE'S QUALITY, PERFORMANCE, ENERGY, AESTHETICS, DIMENSIONS, ETC...

E. PROVIDE EMERGENCY LIGHTING FIXTURES IN AREAS SHOWN ON DRAWINGS.

- ELD ELECTRONIC LED DRIVER OR POWER SUPPLY GWB - GYPSUM WALL BOARD, DRYWALL EPS - ELECTRONIC PROGRAM START FLUORESCENT BALLAST
- EPSD ELECTRONIC PROGRAM START STEP DIMMING BALLAST: 0/50/100 LMNS LUMENS DIM - DIMMING BF - BALLAST FACTOR
- ACT ACOUSTICAL CEILING TILE IN SUSPENDED GRID SYSTEM, ACCESSIBLE

TBD - TO BE DETERMINED MVOLT - 120 & 277 VOLT COMPATIBLE CFL - COMPACT FLUORESCENT MLV - MAGNETIC LOW VOLTAGE

0-10V - ZERO TO TEN VOLT DC DIMMING FEATURE FDB - FLUORESCENT DIMMING BALLAST CMU - CONCRETE MASONRY BLOCK

1. REFER TO FLOOR PLANS FOR CHEVRON QUANTITY, SIGN FACES AND DIRECTION. 2. REFER TO FLOOR PLANS FOR WALL OR CEILING MOUNTING CONFIGURATION.



Madison, WI 53703

architecture & design 222 West Washington Ave. Suite 310

ph: 608.268.1499 www.destreearchitects.com DESTREE DESIGN ARCHITECTS HOLDS ALL RIGHTS INCLUDING THE COPYRIGHT OF THIS DOCUMENT, AS WELL AS THE CONCEPTS AND DESIGNS INCORPORATED HEREIN AS AN INSTRUMENT OF SERVICE. AS PROPERTY OF DESTREE DESIGN ARCHITECTS IT IS NOT TO BE COPIED, DISTRIBUTED, OR USED IN WHOLE OR PART WITHOUT THE EXPRESS WRITTEN CONSENT OF DESTREE DESIGN ARCHITECTS.

1241 John Q Hammons Dr, Suite 503 Madison, Wisconsin 53717 **T** 608.833.7000 Email: info@henneman.com Website: http://www.henneman.com JOB NO. 22-10300B




		_	0,
Revis	ions:		
о.	Date:	Description	1:
$\hat{\Lambda}$	03/12/24	ADDENDU	M 2
		<u> </u>	

Graphic UW: MSN 0140-2303

UWSA: A-22-021 BD Туре

02/20/2024 Issued

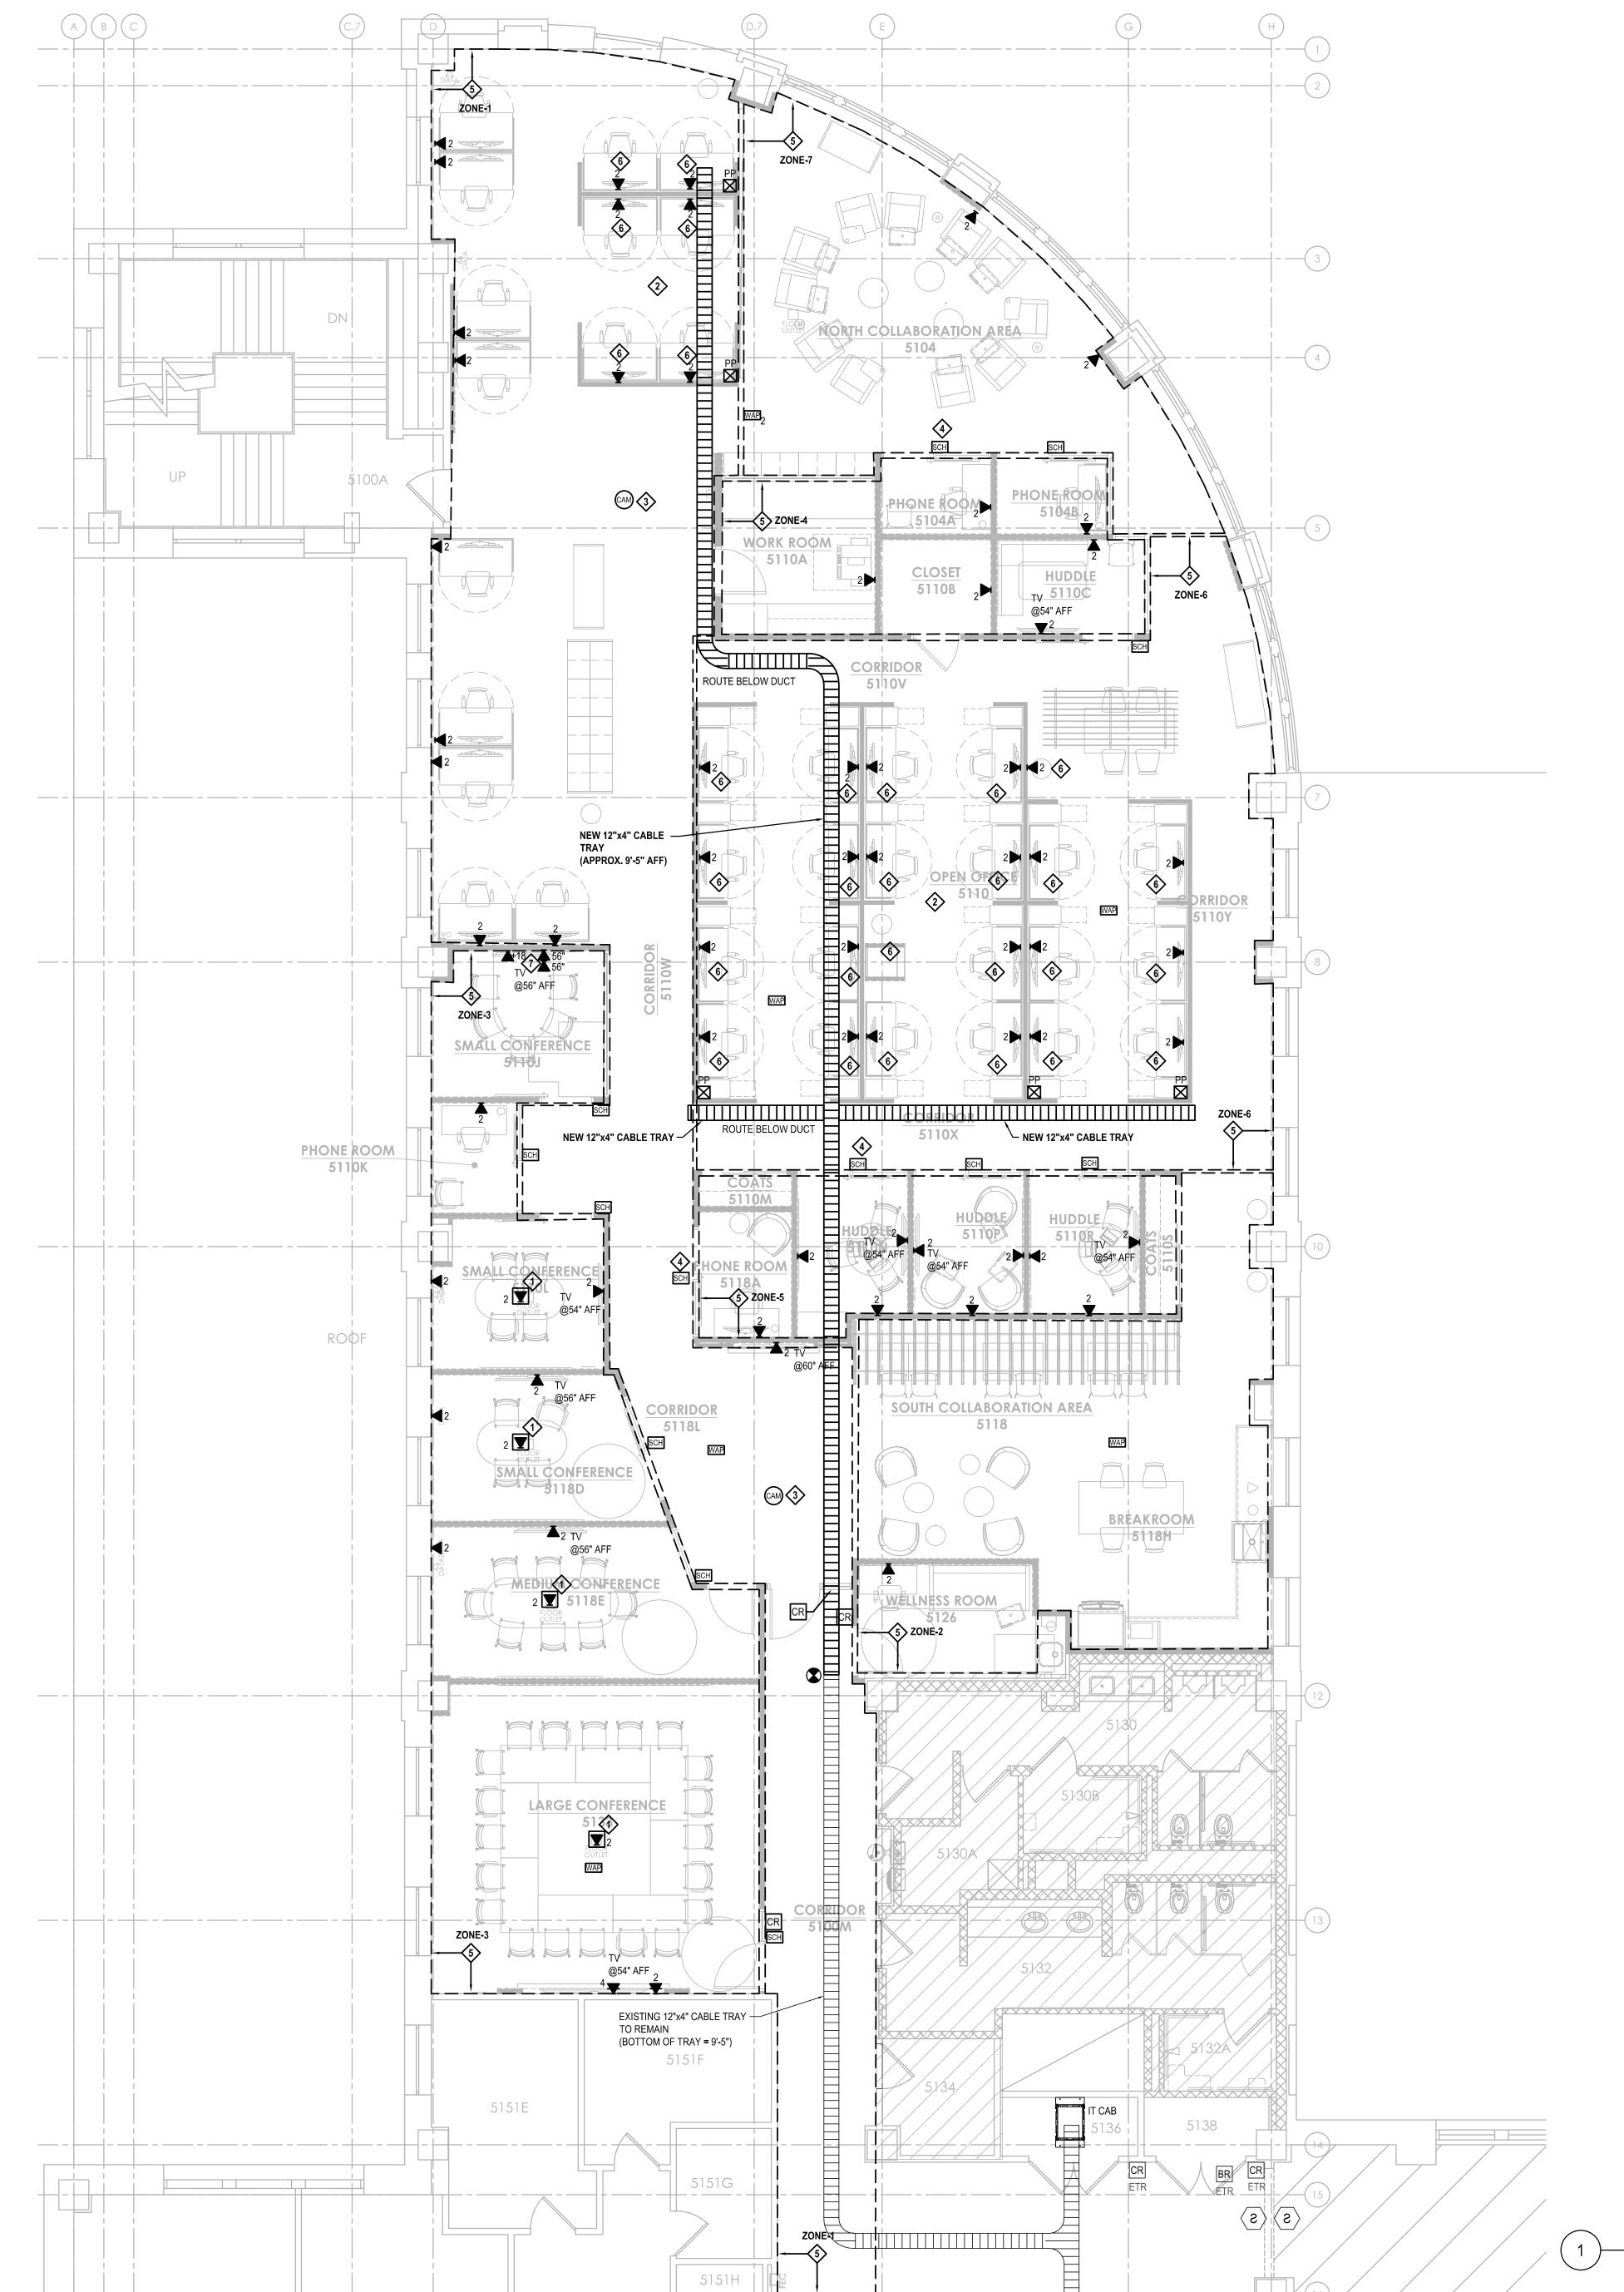

GENERAL NOTES:

1. NEW CARD READERS TO BE CONNECTED TO NEW HEAD END EQUIPMENT, PRIOR TO INSTALLING 4X4 BACK BOXES FOR CARD READERS, CONTACT UW POLICE DEPARTMENT SECURITY SYSTEMS SPECIALIST FOR INSTRUCTIONS ON HEAD-END CONTROL PANEL LOCATIONS, NEW PANEL MAY BE REQUIRED UP TO 500 FT OUTSIDE PROJECT BOUNDARY. SEE KEYPLAN THIS SHEET FOR APPROXIMATE

HEAD-END LOCATION. 2. REUSE FIRE ALARM AUDIO CIRCUITS TO THE EXTENT POSSIBLE.

PROVIDE NEW AUDIO CIRCUITS AND CABLING FROM EXISTING FACP. ASSUME NEW AMPLIFIERS ARE REQUIRED. PROVIDE SHOP DRAWINGS INDICATING CODE-COMPLIANT PLACEMENT OF NEW SPEAKERS, STROBES, PULL STATIONS AND OTHER REQUIRED DEVICES.

3. NEW FIRE ALARM CABLES TO 5TH FLOOR SHALL BE 2 HOUR RATED.

4. WAPS TO BE PROVIDED BY UW DOIT AND WILL REQUIRE 2 DATA CONNECTION BY ELECTRICAL CONTRACTOR. COORDINATE LOCATIONS WITH DOIT PROJECT REPRESENTATIVE. 5. PROVIDE ALL CONNECTORS, HARDWARE, TRANSFORMERS, POWER

SUPPLIES, RACK PANELS, INTERFACES, FASTENERS, WIRE HARNESSING MATERIALS, BUSHINGS AND ANY OTHER INCIDENTALS REQUIRED FOR COMPLETE AND PROPER FUNCTIONING OF THIS SYSTEM WHETHER SPECIFICALLY LISTED OR NOT. 6. PRIOR TO ROUGH-IN AT CAMERA LOCATIONS, THE CONTRACTOR SHALL DEMONSTRATE ALL CAMERA LOCATIONS FOR THE PURPOSES

FOR PARTICIPATION BY DFD, AGENCY STAFF AND ENGINEER. CONTACT KEVIN SOPHA, KEVIN.SOPHA@WISC.EDU, (608)284-0240. 7. THE CONTRACTOR MUST COORDINATE WAP ROUGH-IN LOCATIONS

OF MAKING FINAL CAMERA POSITION AND LENS ADJUSTMENTS. CONTRACTOR SHALL PROVIDE 14-DAY NOTICE (MINIMUM) TO ALLOW

8. SCHEDULERS WILL REQUIRE ONE (1) DATA CONNECTION. THE CABLE SHALL BE IDENTIFIED WITH THE ROOM IT SERVES AND NOT WITH THE CORRIDOR NUMBER.

WITH THE DOIT PROJECT REPRESENTATIVE.

9. FOR SOUND MASKING (WHITE NOISE) SYSTEM, PROVIDE SUBMITTALS INDICATING MANUFACTURERS RECOMMENDED SPEAKER LAYOUT, SPEAKER TYPE, ONE-LINE WIRING DIAGRAM AND ALL HEAD-END

EQUIPMENT. PROVIDE METHOD TO ADJUST SOUND LEVELS PER ZONE.

KEYED NEW WORK NOTES:

1 DATA TERMINATIONS TO BE IN FLOOR BOXES

2 DATA JACKS TO BE PROVIDED AND INSTALLED BY ELECTRICAL CONTRACTOR. DATA PORTS TO HAVE A BEZEL INTO WHICH THE DATA JACKS ARE TO BE SEATED. FURNITURE VENDOR TO SUPPLY KNOCKOUT WITH KEYSTONE OPENINGS.

3 CONTRACTOR TO PROVIDE DATA CABLES. OWNER TO FURNISH CAMERAS. CAMERAS TO BE INSTALLED BY CONTRACTOR.

4 PROVIDE ONE DATA CABLE FOR EACH ROOM SCHEDULER.

5 PROVIDE SOUND MASKING (WHITE NOISE) SYSTEM IN ZONED AREAS AS INDICATED. PROVIDE HEAD-END EQUIPMENT IN TELECOM ROOM 5136.

6 DATA TO BE PROVIDED IN THE SYSTEMS FURNITURE BY ELECTRICAL CONTRACTOR WITH KEYSTONE STYLE JACKS AND FACEPLATES.

7 PROVIDE MUDRINGS WITH AV BRUSH PLATES, ONE AT 18" AFF AND THE OTHER DATA BEHIND MONITOR.



architecture & design

DESTREE DESIGN ARCHITECTS HOLDS ALL RIGHTS INCLUDING THE

DESIGNS INCORPORATED HEREIN AS AN INSTRUMENT OF SERVICE. AS PROPERTY OF DESTREE DESIGN ARCHITECTS IT IS NOT TO BE

COPIED, DISTRIBUTED, OR USED IN WHOLE OR PART WITHOUT THE EXPRESS WRITTEN CONSENT OF DESTREE DESIGN ARCHITECTS.

1241 John Q Hammons Dr, Suite 503

Website: http://www.henneman.com

Madison, Wisconsin 53717

Email: info@henneman.com

T 608.833.7000

MADISON

O

WISC

OF

UNIVERSIT 21 N PARK STREET O MADISON

JOB NO. 22-10300B

COPYRIGHT OF THIS DOCUMENT, AS WELL AS THE CONCEPTS AND

222 West Washington Ave. Suite 310

Madison, WI 53703

www.destreearchitects.com

ph: 608.268.1499

No. Date: Description: ↑ 03/12/24 ADDENDUM 2

ROOM 4432 — (LOCATED ON 4TH FLOOR)

> UW: MSN 0140-2303 UWSA: A-22-021

BD Type

Date Issued 02/20/2024


ES101

5TH FLOOR NEW WORK PLAN - ELECTRICAL SYSTEMS

5TH FLOOR KEY PLAN




EXISTING 5TH FLOOR PANELS 5/4Q, 5/Q SEC 2, 5/Q SEC 1 PHOTO NO SCALE

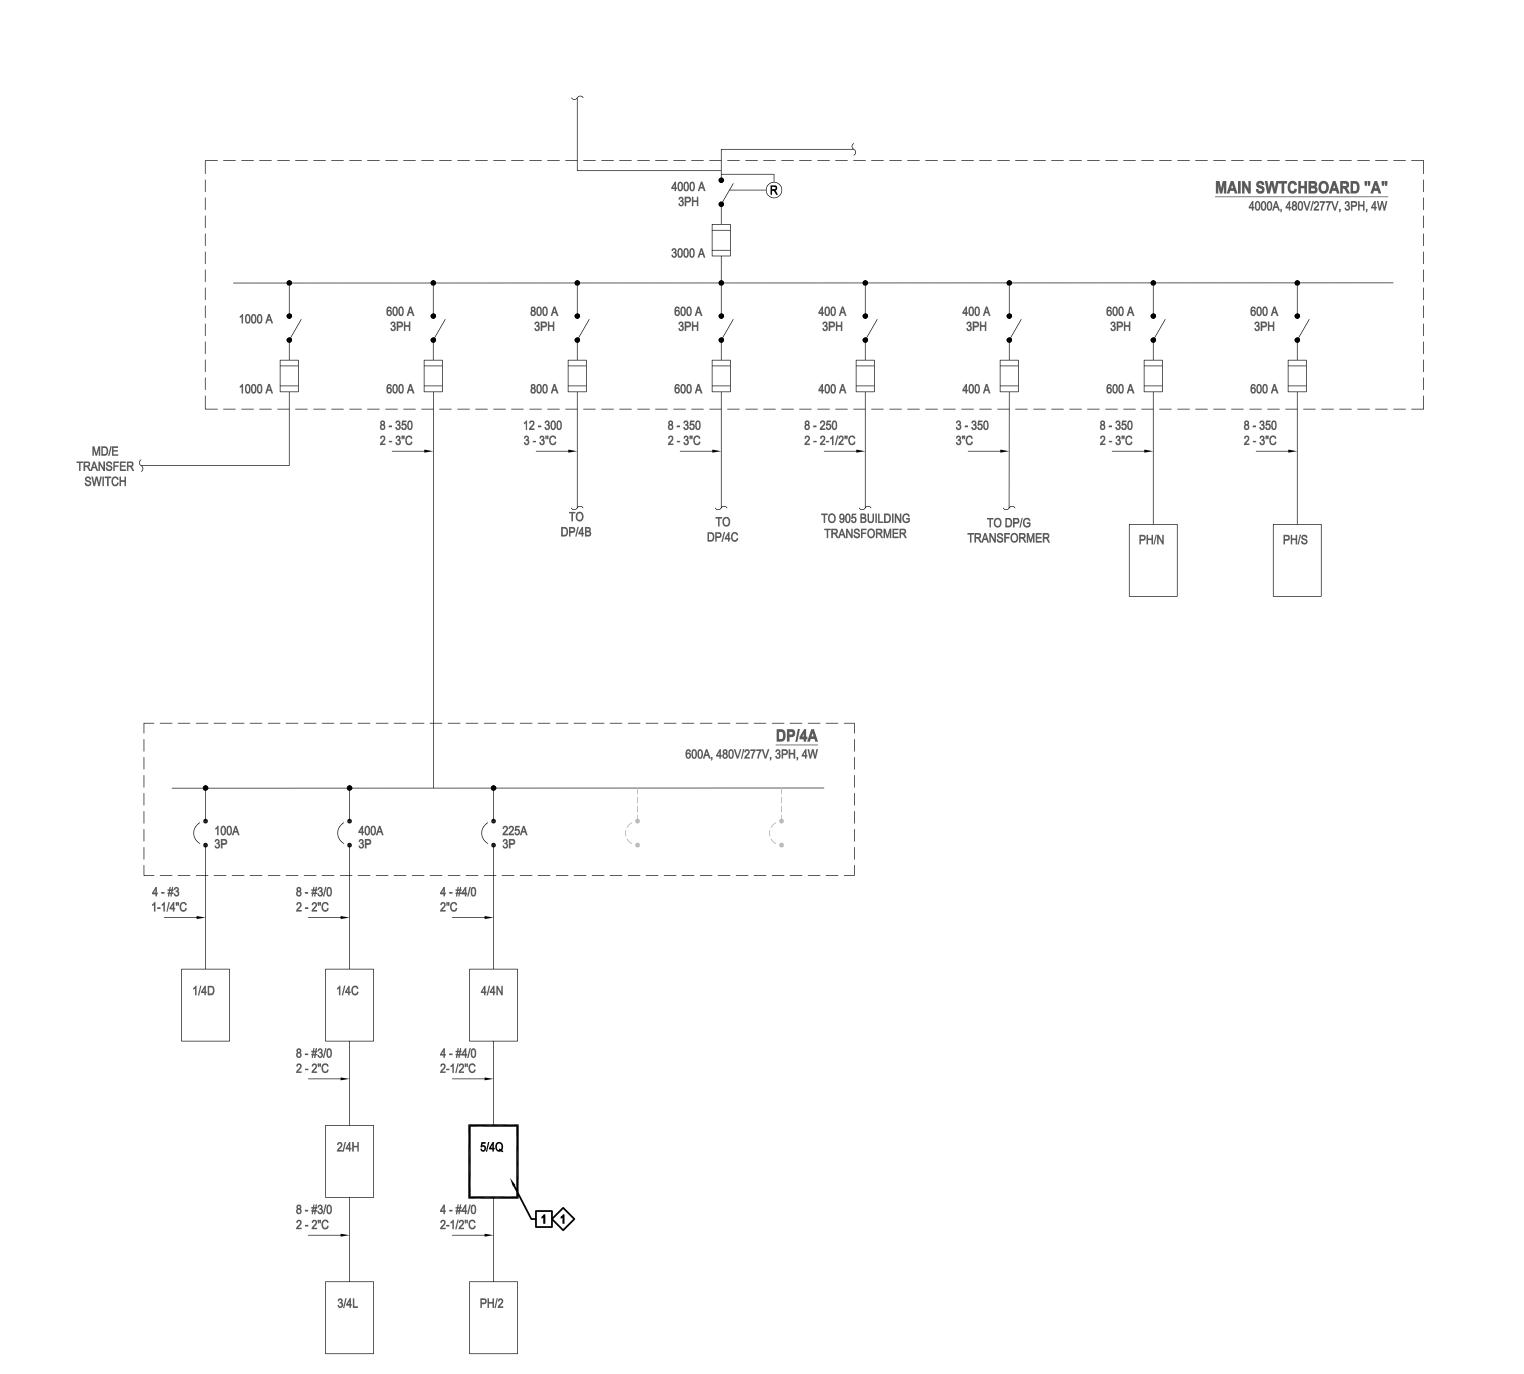



PARTIAL ONE LINE DIAGRAM

LINE WEIGHT KEY ALL ITEMS INDICATED BY A DARK SOLID LINE ARE NEW ALL ITEMS INDICATED BY A LIGHT SOLID LINE ARE EXISTING TO ----- ALL ITEMS INDICATED BY A DARK DASHED LINE ARE DEMO

ONE LINE DIAGRAMS								
SYMBOL	DESCRIPTION							
MCC-1	ELECTRICAL EQUIPMENT WITH DESIGNATION							
	AUTOMATIC TRANSFER SWITCH							
	MANUAL TRANSFER SWITCH							
	CIRCUIT BREAKER							
	DRAW-OUT POWER CIRCUIT BREAKER							
	CONTACTOR							
— /-	SWITCH							
	FUSE							
	FUSED SWITCH							
H 3	POTENTIAL TRANSFORMER							
$-\infty$	CURRENT TRANSFORMER							
\\\\\\\\\\\\\\\\\\\\\\\\\\\\\\\\\\\\\\	TRANSFORMER							
M	METER							
Y	INCOMING SERVICE							
	BUS BAR							
-(100/4)-	FEEDER DESIGNATION							
Δ	DELTA							
ĻĒ	WYE							
<u></u>	GROUND							
SPD	SURGE PROTECTIVE DEVICE							

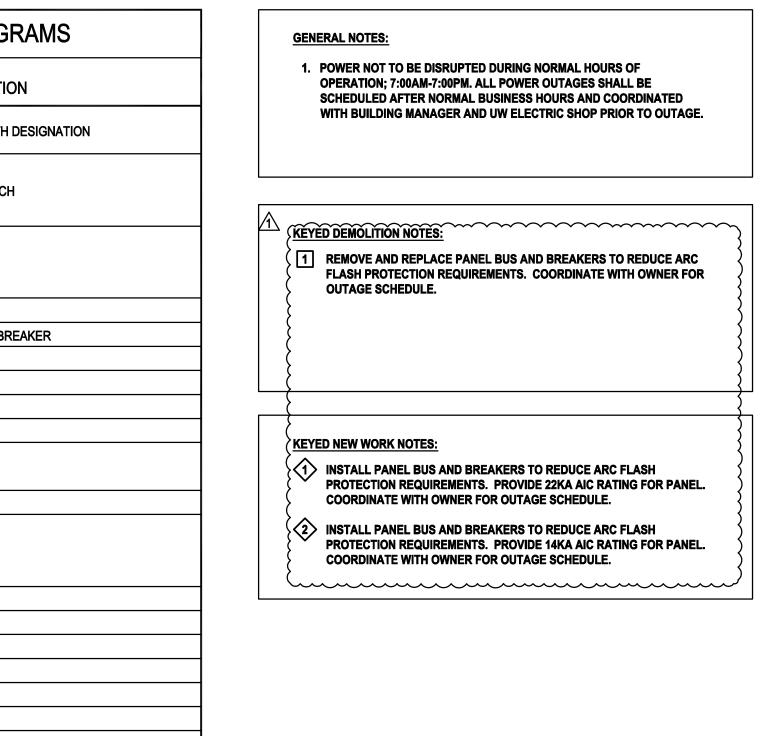

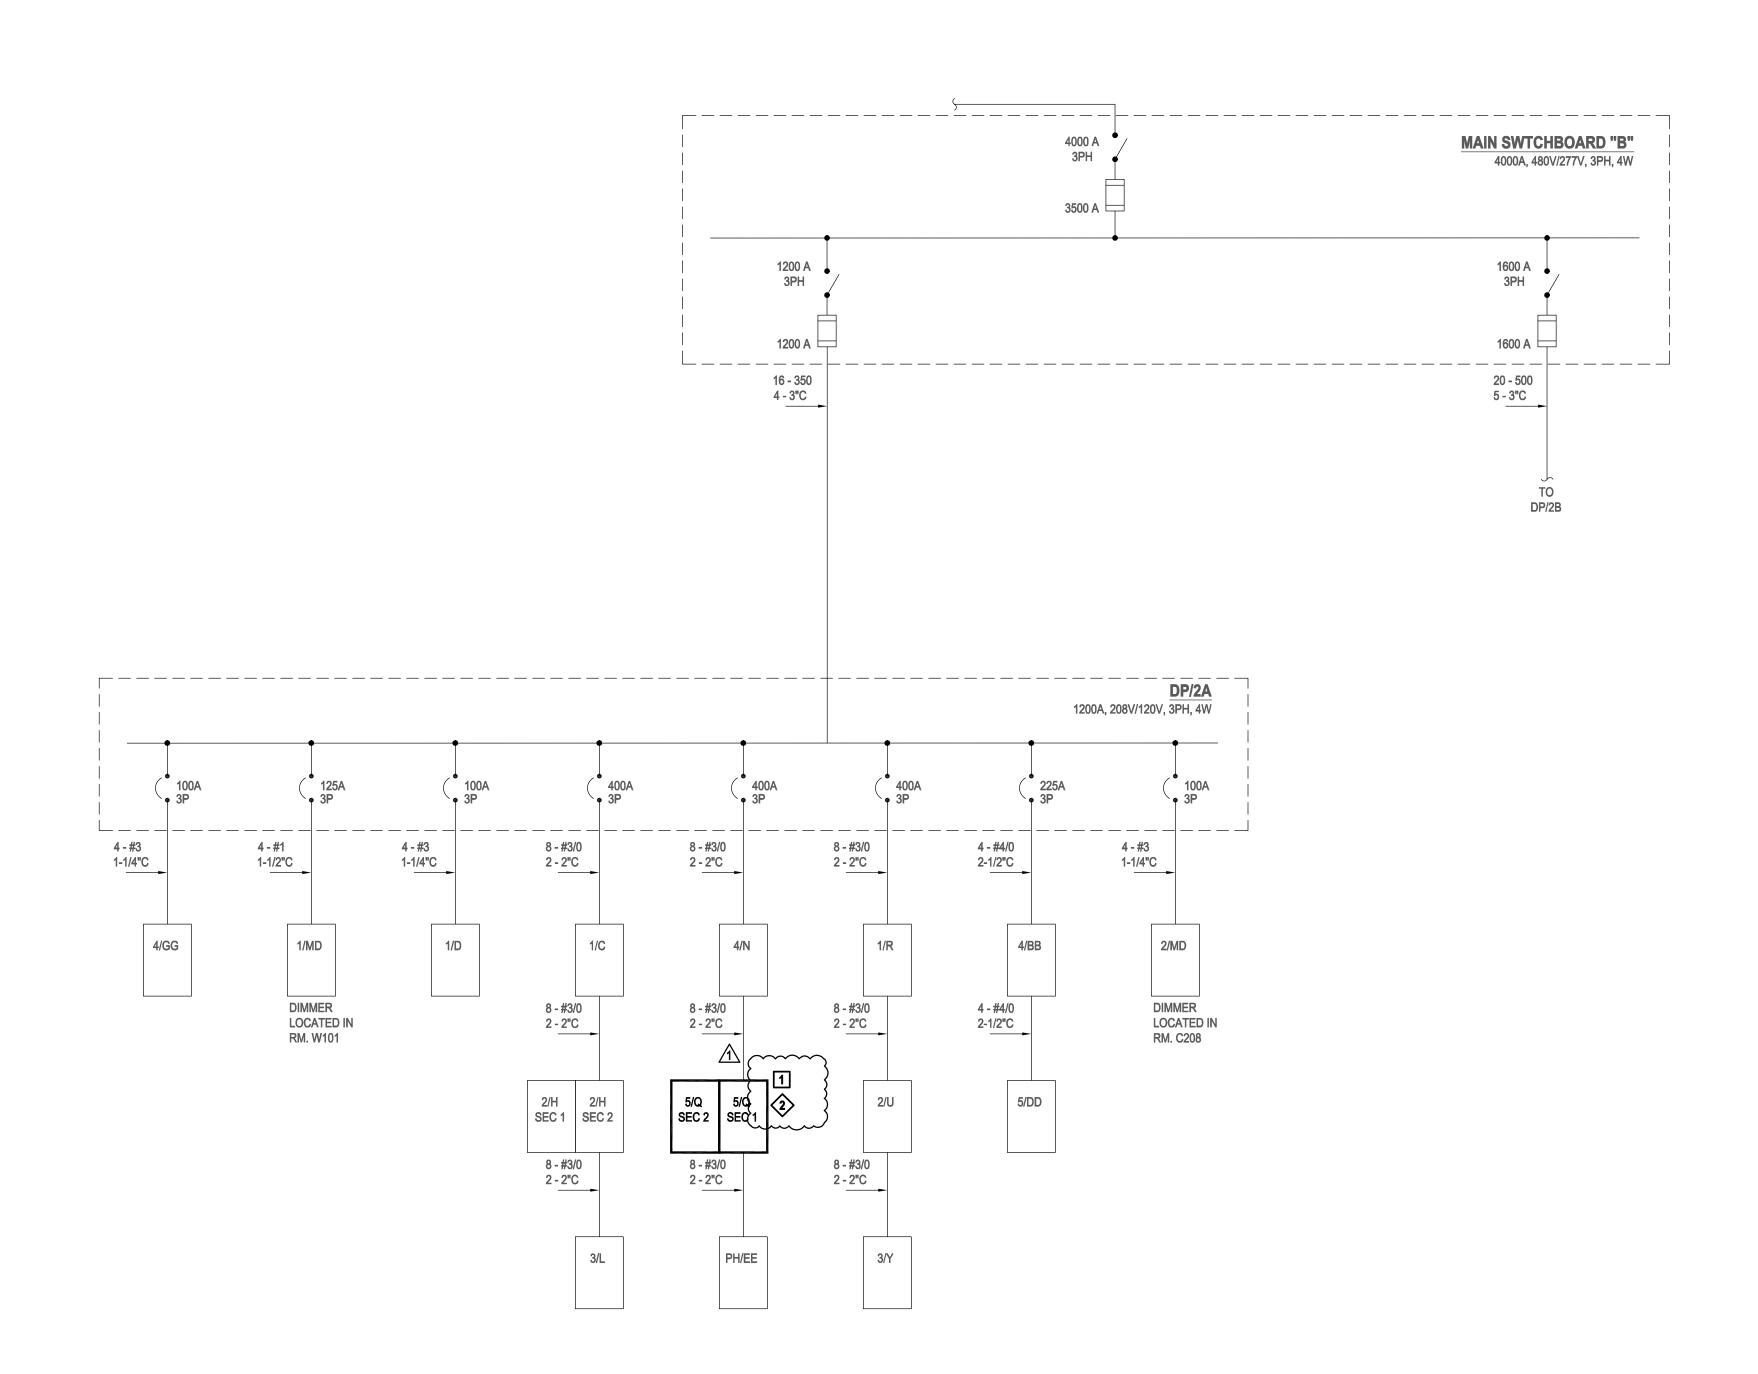

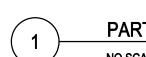

PARTIAL ONE LINE DIAGRAM NO SCALE



222 West Washington Ave. Suite 310 Madison, WI 53703 ph: 608.268.1499 www.destreearchitects.com DESTREE DESIGN ARCHITECTS HOLDS ALL RIGHTS INCLUDING THE COPYRIGHT OF THIS DOCUMENT, AS WELL AS THE CONCEPTS AND DESIGNS INCORPORATED HEREIN AS AN INSTRUMENT OF SERVICE, AS PROPERTY OF DESTREE DESIGN ARCHITECTS IT IS NOT TO BE COPIED, DISTRIBUTED, OR USED IN WHOLE OR PART WITHOUT THE EXPRESS WRITTEN CONSENT OF DESTREE DESIGN ARCHITECTS.

Madison: 1241 John Q Hammons Dr, Suite 503 Madison, Wisconsin 53717 T 608.833.7000 Email: info@henneman.com Website: http://www.henneman.com JOB NO. 22-10300B

MADISON **WISCONSIN OF**



03/12/24 | ADDENDUM 2 UWSA: A-22-021

UW: MSN 0140-2303

E401

Sheet Number

PANELBOARD NAME	VO	LTA	GE.		PHASE	WIRE	BUS SI	ZE		٨	MAIN	AIC RATING
5/Q SECT 1 (DEMO)	2	208	/120		3	4	225		1	١	ИCВ	10KA
LOCATION	FEE	DF	ROM		SOURCE	OCATION	# OF C	(TS		MC	DUNT	NEMA ENCLOSURE
RM 5138	D)P/2	Α				42			SUF	RFACE	TYPE 1
LOAD	CB ACCESS.	POLE	BKR AMP	CKT#	VA	PHASE	VA	CKT#	BKR AMP	POLE	CB ACCESS.	LOAD
RECPTS RMS 5110E 5110I, 5110H		1	20	1	0	Α	0	2	20	1		RECPTS RMS 5115, 5121 & 5151 ISO GR
RECPTS RMS 5110H & 5110D ISO GR		1	20	3	0	В	0	4	20	1		RECPTS RMS 5115 & 5100J
UNIT HEATER STAIR A		1	20	5	0	С	0	6	20	1		RECPTS RM 5121
RECPTS RMS 51110, 5110G, 51115A, 5115, & 5100J		1	20	7	0	Α	0	8	-	-		SPACE
RECPTS RMS 5110F, 5110G		1	20	9	0	В	0	10	20	1	v	RECPTS RM 5120
RECPTS RMS 5110 & 5110G ISO GR		1	20	11	0	С	0	12	20	1		RECPTS RM 5120
RECPTS RMS 5120 & 5110A		1	20	13	0	Α	0	14	20	1		RECPTS RM 5120A & B
RECPTS RM 5110A & 5110B		1	20	15	0	В	0	16	20	1		MOVIE SCREENS RM 5120
RECPTS RM 5120		1	20	17	0	С	0	18	20	1		LITES RM 5120
RECPTS RMS 5110I, 5110D		1	20	19	0	Α	0	20	20	1		LITES RM 5120
RECPTS RMS 5110D, 5110C		1	20	21	0	В	0	22	20	1		LITES RM 5120
RECPTS RM 5110DM 5110C, 5110B		1	20	23	0	С	0	24	12	-		SPACE
LITES RM 5121		1	20	25	0	Α	0	26	-	77		SPACE
LITES RM 5110A		1	20	27	0	В	0	28	-	+:		SPACE
LITES RMS 5110I, 5120 NORTH		1	20	29	0	С	0	30	-	-		SPACE
RECPTS RMS 5110A, 5110I & 5120		1	20	31	0	Α	0	32	-	-		SPACE
NEW COPY MACHINE ROOM 5110		1	20	33	0	В	0	34	-	-		SPACE
SPACE		-	-	35	0	С	0	36	-	2		SPACE
SPACE	Î	-	-	37	0	Α	0	38	-	25		SPACE
SPACE		-	-	39	0	В	0	40	-	-		SPACE
SPACE		-	-	41	0	С	0	42	-	-		SPACE
PANEL OPTIONS:			50		PT-VA@	per NEC	-	TO			LOAD VA =	0
					STD-VA@	100%	-				JSTED VA=	0
					OSPVA@						ND AMPS =	0
	l				AREVA@		-				EXIST. KW =	0
PANEL NOTES:			-	_	R-VA@	100%		LR			R LOAD VA =	0
BUCKET 1 OF 2					N-VA@	100%	=	1		# O	F ELEV(S) =	0
SIEMENS PANELBOARD					/-VA @	per NEC	-	ш.	OF IZIT	011	EN EQUID	•
CAT#BG42MB4225SBM					EQ-VA@	100%	-				EN EQUIP =	0
					GEQ-VA@	100%	-				PANEL(S) =	0
					OR-VA@ VA@	100% 100%					H FACTOR =	0

PANELBOARD NAME	VO	LTA	GE		PHASE	WRE	BUS SIZ	ZE		1	MAIN	AIC RATING
5/Q SECT 2 (DEMO)		208	/120		3	4	225			1	MLO	10KA
LOCATION	FEE	DΕ	ROM		SOURCE L	OCATION	# OF CK	TS		M	TNUC	NEMA ENCLOSURE
RM 5138)P/2	A				42			SUI	RFACE	TYPE 1
LOAD	CB ACCESS.	POLE	BKR	CKT#	VA	PHASE	VA	CKT#	BKR AMP	POLE	CB ACCESS.	LOAD
RECPTS RMS 5151F, 5151G, ISO GR		1	20	1	0	А	0	2	20	1		RECPT RM 5124
RECPTS RMS 5151F, 5151EM 5151G		1	20	3	0	В	0	4	20	1		RECPT RM 5124
RECPTS RM 5136		1	20	5	0	С	0	6	20	1		RECPT RM 5124 MICROWAVE OVEN
RECPT RM 5124 REF FREEZER		1	20	7	0	Α	0	8	20	1		RECPTS RMS 5130, 5132
LITES RM 5130B, 5132A		1	20	9	0	В	0	10	20	1		RECPTS WATER COOLER RMS 5130, 5132
LITES ELEV LOBBY 5100L		1	20	11	0	С	0	12	20	1		CABINET UNIT HEARER RMS 5130, 5132
SPACE		-	-	13	0	Α	0	14	30	2		
RECPT RM5124 COFFEE MACHINE		1	20	15	0	В	0	16	-	-		COFFEE MAKER RM 5124
SPACE		-	- 2	17	0	С	0	18	20	1		RECPTS IDF-5136
SPACE		-	-	19	0	Α	0	20	20	1		RECPTS IDF-5136
SPACE		3	-	21	0	В	0	22		-		SPACE
SPACE				23	0	С	0	24	120	-		SPACE
SPACE		-	-	25	0	Α	0	26		-		SPACE
SPACE		-		27	0	В	0	28	(*)	-		SPACE
SPACE		-	-	29	0	С	0	30	:e::	-		SPACE
SPACE		-	-	31	0	Α	0	32	-	-		SPACE
SPACE		-	-	33	0	В	0	34	· **	-		SPACE
SPACE		-	2	35	0	С	0	36	20	-		SPACE
SPACE		-	2	37	0	Α	0	38	24	-		SPACE
SPACE		-	-	39	0	В	0	40	-	-		SPACE
SPACE				41	0	С	0	42		-		SPACE
PANEL OPTIONS:			RI	ECEF	PT-VA@	per NEC	157	TO	TAL C	AL(C LOAD VA =	0
			LIGH	HTS S	STD-VA@	100%	(*)		1	√ DJ	USTED VA =	0
			LIGH	TS H	OSPVA@	per NEC	(=)		D	EM	AND AMPS =	0
			LIGH'	TS W	/AREVA@	per NEC	8 4 5	AD	JUST	ED	EXIST. KW=	0
PANEL NOTES:	1		and the second second second		R-VA@	100%	# 2 9	LR	G MO	TOF	R LOAD VA =	0
BUCKET 2 OF 2					EN-VA@	100%	(2)			# O	F ELEV(S) =	0
SIEMENS PANELBOARD			>	(-RA)	/-VA@	per NEC						
CAT # BG42ML4225STM			HEA	TING	EQ-VA@	100%	-	# (OF KIT	СН	EN EQUIP =	0
			COC	LINC	G EQ-VA@	100%	87.5	SI	JB-FE	ED	PANEL(S) =	
			ELE	EVAT	OR-VA@	100%	151	25%	GRO	WTI	H FACTOR =	0
			1	MISC	VA@	100%	3 .7 1	93-	TOTAL	DE	SIGN AMPS	0

PANELBOARD NAME	VO	LTA	GE		PHASE	WRE	BUS SIZ	ZE			MAIN	AIC RATING
5/4Q (DEMO)		180	/277		3	4	100			١	//CB	10KA
LOCATION	FEE	DF	ROM		SOURCE	LOCATION	# OF CK	TS		MC	DUNT	NEMA ENCLOSURE
RM. 5138	D	P/4	Α				42			SUF	RFACE	TYPE 1
LOAD	CB ACCESS.	POLE	BKR	CKT#	VA	PHASE	VA	CKT#	BKR	POLE	CB ACCESS.	LOAD
LTS RMS 5194, 5186, 5184, 5176, 5172, 5166		1	20	1	0	А	0	2	20	1		LTS RMS 5151D, 5151B, 5151A, 5151C, 5 5151F
_TS RMS 5193, 5191E, 5191A, 5191D, 5181C, 5181B, 5181D		1	20	3	0	В	0	4	20	1		LTS RMS 5100K 5100J 5151G, 5130A, 57 5136, 5134, 5132, 5130, 5124
LTS RMS 5181M 5181B, 5171, 5151K, 5161, 5151L, 5151J		1	20	5	0	С	0	6	20	1		LITES RM 5120
LITES RMS 5115, 5110G, 5110F, 5110E		1	20	7	0	Α	0	8	20	1		SPARE
LITES RMS 5115A, 5110, 5110I, 5110H, 5110D, 5110C, 5110B, 5110A		1	20	9	0	В	0	10	20	1		SPARE
SPARE		1	20	11	0	С	0	12	20	1		SPARE
SPARE		1	20	13	0	Α	0	14	-	1		SPACE
SPACE		1	-	15	0	В	0	16	-	1		SPACE
SPACE		1	-	17	0	С	0	18	-	1		SPACE
SPACE		1	-	19	0	Α	0	20	-	1		SPACE
SPACE		1	-	21	0	В	0	22	-	1		SPACE
SPACE		1	-	23	0	С	0	24	-	1		SPACE
SPACE		1	-	25	0	Α	0	26	-	1		SPACE
SPACE		1	-	27	0	В	0	28	-	1		SPACE
SPACE		1	-	29	0	С	0	30	-	1		SPACE
SPACE		1	-	31	0	Α	0	32	-	1		SPACE
SPACE		1	-	33	0	В	0	34	-	1		SPACE
SPACE		1	-	35	0	С	0	36	-	1		SPACE
SPACE		1	-	37	0	Α	0	38	-	1		SPACE
SPACE		1	-	39	0	В	0	40	-	1		SPACE
SPACE		1		41	0	С	0	42	-	1		SPACE
ANEL OPTIONS:			RI	CEF	PT-VA@	per NEC	7.7	TO			LOAD VA =	0
			LIGH	HTS S	@ AV-DT8	100%	-		A	/DJI	JSTED VA =	0
					OSPVA@		-				ND AMPS =	0
			LIGH'	TS W	AREVA@	per NEC	-				EXIST. KW=	0
PANEL NOTES:			M	ОТО	R-VA@	100%	12	LR	G MO	TOF	R LOAD VA =	0
SIEMENS PANELBOARD					N-VA@	100%	2		1	# O	FELEV(S) =	0
CAT # H442MB4100SBM					′-VA @	per NEC	-					
			HEA	TING	EQ-VA@	100%	-	# (OF KIT	CHI	EN EQUIP =	0
			COC	LING	EQ-VA@	100%	<u> </u>	SI	JB-FE	ED	PANEL(S) =	
			ELE	VAT	OR-VA@	100%		25%	GRO	WTH	FACTOR =	0
			1	/ISC	-VA@	100%	-		TOTAL	DE	SIGN AMPS	0

PANELBOARD NAME	\/O	LTA	GF		PHASE	WIRE	BUS SIZ	7F		Λ	MAIN I	AIC RATING
5/Q SECT 1 (NEW)	174.00	C-12/1/20100	/120		3	4	225				ACB	14KA
LOCATION			ROM		SOURCE		# OF CK	TS			DUNT	(NEMA ENCLOSURE
RM 5138)P/2			COUNCE	LOOKHON	42	SURFACE				TYPE 1
1100100	1	_		#			- 12	#	_			\\\\\\\\\\\\\\\\\\\\\\\\\\\\\\\\\\\\\\
LOAD	CB ACCESS.	POLE	BKR AMP	CKT#	VA	PHASE	VA	CKT#	BKR AMP	POLE	CB ACCESS.	LOAD
RECPTS 5110		1	20	1	1,980	Α	1,440	2	20	1		RECPTS 5110
RECPTS 5110		1	20	3	2,160	В	1,440	4	20	1		RECPTS RMS 5110J,K
UNIT HEATER STAIR A		1	20	5	0	С	1,620	6	20	1		RECPTS 5110W
RECPTS 5104, A,B,5110C		1	20	7	1,980	Α	1,440	8	20	1		RECPTS 5110
RECPTS 5110A,5110B		1	20	9	1,800	В	1,440	10	20	1		RECPTS RM 5120
RECPTS RMS 5110		1	20	11	1,440	С	1,440	12	20	1		RECPTS 5110
CORRIDOR 5110Y		1	20	13	1,440	Α	1,260	14	20	1		RECPTS 5118
RECPTS 5110L		1	20	15	1,800	В	1,800	16	20	1		RECPTS 5118H, 5100M
RECPTS 5118A, 5110M,N		1	20	17	1,620	С	1,923	18	20	1		LITES RM 5110M,N,P,R,L, 5118,D,E,5126
RECPTS 5110P,R	·	1	20	19	1,620	Α	1,923	20	20	1		LITES RM 5125,5100M
RECPT 5118D,E	1	1	20	21	1,980	В	0	22	20	1		SHADES RM 5133, 5110J
RECPT 5133		1	20	23	1,980	С	0	24	-	-		SPACE
RECPT 5126	1	1	20	25	900	Α	0	26	-	-		SPACE
LITES RM 5110,A,B,V,W5104,A,B,C		1	20	27	1,923	В	0	28	-	-		SPACE
SPARE	1	1	20	29	0	С	0	30	-	-		SPACE
SPARE		1	20	31	0	Α	0	32	-	-		SPACE
SPARE	1	1	20	33	0	В	0	34	-	-		SPACE
SPACE		-	-	35	0	С	0	36	-	-		SPACE
SPACE		-	-	37	0	Α	0	38	-	-		SPACE
SPACE		-	_	39	0	В	0	40	-	-		SPACE
SPACE		-	-	41	0	С	0	42	-	-		SPACE
PANEL OPTIONS:			R	ECEF	T-VA@	per NEC	20,840	TO			LOAD VA =	37,449
					STD-VA@	100%	5,769		-	ADJI	JSTED VA=	26,609
					OSPVA@		-	. T	D	EMA	ND AMPS =	74
			LIGH	TS W	/AREVA@	per NEC	-	AD	JUST	ED I	EXIST. KW=	0
PANEL NOTES:					R-VA@	100%	-	LR			R LOAD VA =	0
BUCKET 1 OF 2					EN-VA@	100%	~			# O	FELEV(S) =	0
					/-VA@	per NEC	-					
					EQ-VA@	100%	-		2.00 min 10 min		EN EQUIP =	0
					GEQ-VA@	100%	-				PANEL(S) =	
					OR-VA@	100%	-	S			H FACTOR =	18
				MISC.	VA@	100%			TOTAL	. DE	SIGN AMPS	74

											A	0 - 0 - 0 0
PANELBOARD NAME	VO	LTA	IGE		PHASE	WIRE	BUS SIZ	ZE		N	MAIN	AIC RATING
5/Q SECT 2 (NEW)		208	/120		3	4	225			١	MLO	14KA
LOCATION	FEE	DΕ	ROM		SOURCE	LOCATION	# OF CK	TS		M	TAUC	NEMA ENCLOSURE
RM 5138)P/2	2A				42			SUI	RFACE	TYPE 1
LOAD	CB ACCESS.	POLE	BKR	CKT#	VA	PHASE	VA	CKT#	BKR	POLE	CB ACCESS.	LOAD
RECPTS RMS 5151F, 5151G, ISO GR		1	20	1	0	Α	0	2	20	1		RECPT RM 5126
RECPTS RMS 5151F, 5151EM 5151G		1	20	3	0	В	0	4	20	1		SPARE
RECPTS RM 5136		1	20	5	0	С	0	6	20	1		SPARE
SOUND MASKING PANEL		1	20	7	0	Α	0	8	20	1		RECPTS RMS 5130, 5132
LITES RM 5130B, 5132A		1	20	9	0	В	0	10	20	1		RECPTS WATER COOLER RMS 5130, 5132
LITES ELEV LOBBY 5100L		1	20	11	0	С	0	12	20	1		CABINET UNIT HEARER RMS 5130, 5132
SPACE		-	-	13	0	Α	0	14	30	2		SDADE
SPARE		1	20	15	0	В	0	16	1-0	-		SPARE
SPACE		-	-	17	0	С	0	18	20	1		RECPTS IDF-5136
SPACE		-	2	19	0	Α	0	20	20	1		RECPTS IDF-5136
SPACE		-	-	21	0	В	0	22	-	-		SPACE
SPACE		-	-	23	0	С	0	24	1.70	-		SPACE
SPACE		-	-	25	0	Α	0	26	1.5	-		SPACE
SPACE		-	-	27	0	В	0	28	-	-		SPACE
SPACE		-	-	29	0	С	0	30	-	-		SPACE
SPACE		-	-	31	0	Α	0	32	-	-		SPACE
SPACE		-	~	33	0	В	0	34	8=8	-		SPACE
SPACE		-	=	35	0	С	0	36	-	-		SPACE
SPACE		=	-	37	0	Α	0	38	-	-		SPACE
SPACE		-	- 8	39	0	В	0	40		-		SPACE
SPACE		5	-5	41	0	С	0	42				SPACE
PANEL OPTIONS:					PT-VA@	per NEC	_35	TC			C LOAD VA =	0
					STD-VA@	100%		_			USTED VA =	0
					OSPVA@						AND AMPS =	0
	1				/AREVA@	•					EXIST. KW=	- X
PANEL NOTES:	1				R-VA@	100%		LF			R LOAD VA =	0
BUCKET 2 OF 2					EN-VA@	100%		\vdash		# O	F ELEV(S) =	0
					/-VA@	per NEC		┞				
					EQ-VA@	100%		_			EN EQUIP =	0
					G EQ-VA@	100%		_			PANEL(S) =	
					OR-VA@	100%		_			H FACTOR =	0
				VISC	VA@	100%	1999	1	IUIAL	- DE	SIGN AMPS	0

PANELBOARD NAME	VO	LTA	GE		PHASE	WIRE	BUS SI	ZE		N	MAIN	AIC RATING
5/4Q (NEW)	4	180	/277	ž.	3	4	100	-534-54	MCB			22KA
LOCATION			ROM		SOURCE	OCATION	# OF CKTS		MOUNT			> NEMAENCLOSURE {
RM. 5138	D	DP/4A				42		SURFACE			TYPE1	
LOAD	CB ACCESS.			CKT#	VA	PHASE	VA	CKT#	BKR	POLE	CB ACCESS.	LOAD
LTS RMS 5194, 5186, 5184, 5176, 5172, 5166		1	20	1	0	Α	0	2	20	1	â ·	LTS RMS 5151D, 5151B, 5151A, 5151C, 515 5151F
TS RMS 5193, 5191E, 5191A, 5191D, 5181C, 5181B, 5181D		1	20	3	0	В	0	4	20	1		LTS RMS 5100K 5100J 5151G, 5130A, 513 5136, 5134, 5132, 5130
LTS RMS 5181M 5181B, 5171, 5151K, 5161, 5151L, 5151J		1	20	5	0	С	0	6	20	1	8	SPARE
SPARE		1	20	7	0	Α	0	8	20	1		SPARE
SPARE		1	20	9	0	В	0	10	20	1	8	SPARE
SPARE		1	20	11	0	С	0	12	20	1		SPARE
SPARE		1	20	13	0	Α	0	14		1		SPACE
SPACE		1	-	15	0	В	0	16	-	1	E	SPACE
SPACE		1	-	17	0	С	0	18	-	1	k	SPACE
SPACE		1	•	19	0	Α	0	20	-	1		SPACE
SPACE		1	•	21	0	В	0	22	-	1		SPACE
SPACE		1	•	23	0	С	0	24	-	1	4	SPACE
SPACE		1	•	25	0	Α	0	26	-	1		SPACE
SPACE		1		27	0	В	0	28		1		SPACE
SPACE		1		29	0	С	0	30	7	1		SPACE
SPACE		1	1000	31	0	A	0	32	(**)	1	9	SPACE
SPACE		1	-	33	0	В	0	34	-	1		SPACE
SPACE		1		35	0	С	0	36	-	1		SPACE
SPACE		1	•	37	0	A	0	38	-	1		SPACE
SPACE		1		39	0	В	0	40	•	1	*	SPACE
SPACE		1	-	41	0	C	0	42	-	1	1 0 1 0 1 0	SPACE
PANEL OPTIONS:					PT-VA@	per NEC		10			LOAD VA =	0
					STD-VA@	100%	-	1			JSTED VA=	0
			LICH	TOM	OSPVA@	per NEC	-	AF			ND AMPS =	0
PANEL NOTES:	ł				/AREVA@						EXIST. KW=	0
PANEL NUTES:					R-VA@	100%	-	LF	1200-200		R LOAD VA =	0
\					EN-VA@	100% per NEC	72	1—		# U	F ELEV(S) =	0
}		2			Y-VA@ GEQ-VA@	100%		# /) E KIT	СП	EN EQUIP =	0
· · · · · · · · · · · · · · · · · · ·		3			G EQ-VA@	100%					PANEL(S) =	
					OR-VA@	100%					FACTOR =	0
					VA@	100%	- 17				SIGN AMPS	



DESTREE
architecture & design

222 West Washington Ave. Suite 310
Madison, WI 53703
ph: 608.268.1499
www.destreearchitects.com



Madison:
1241 John Q Hammons Dr, Suite 503
Madison, Wisconsin 53717
T 608.833.7000
Email: info@henneman.com
Website: http://www.henneman.com
JOB NO. 22-10300B

UNIVERSITY OF WISCONSIN - MADISON 21 N PARK STREET SUITE #6101 MADISON, WI 53715



GRAINGER HALL 2ND & 5TH FLOOR RENOVATION


PHASE 2 - 5TH FLOOR OFFICE RENOVATION

UNIVERSITY OF WISCONSIN - MADISON


975 UNIVERSITY AVENUE

MADISON, WI 53706


Sheet Number E500

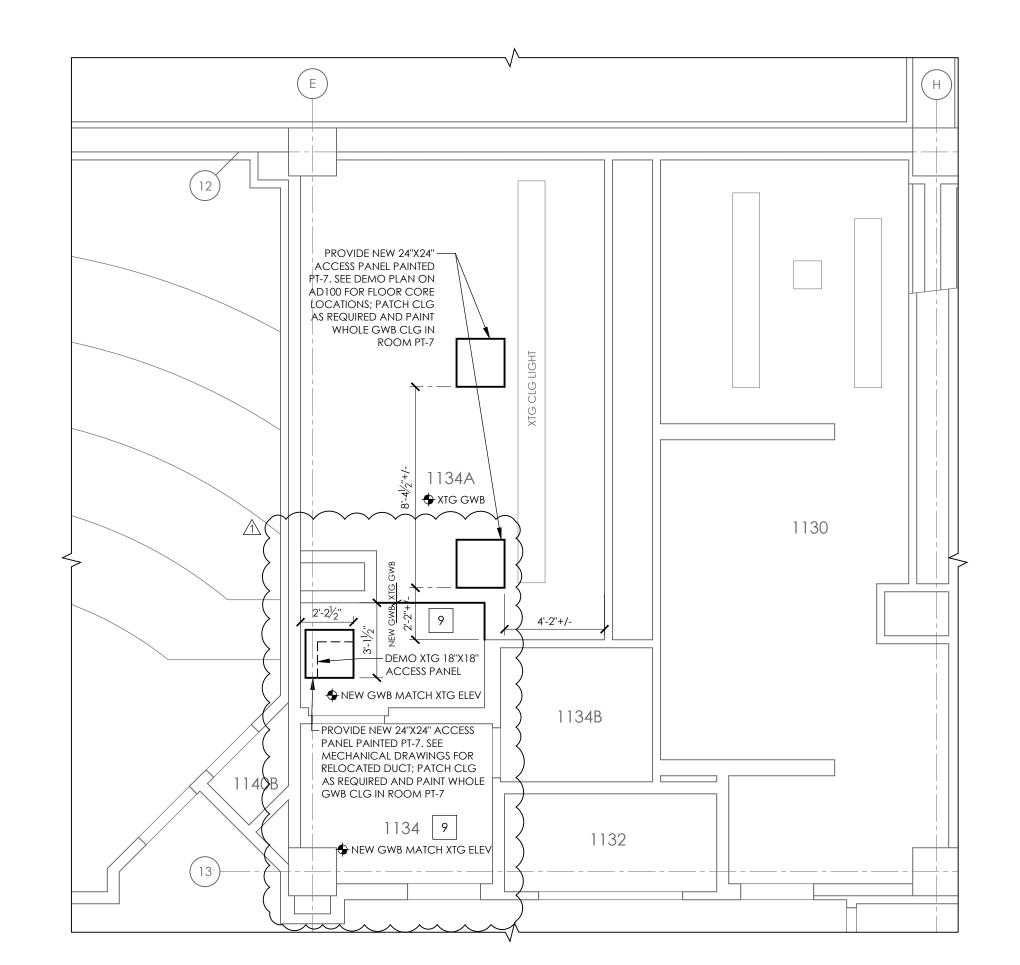




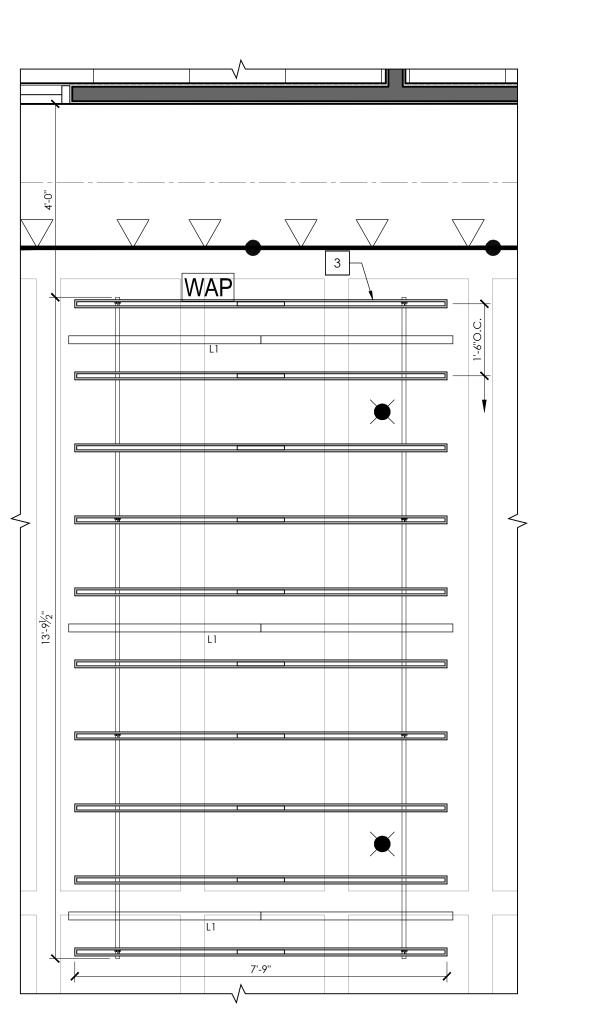

 $3\frac{\text{ENLARGED RCP AT CEILING ELEMENT AS-3}}{1/2" = 1'-0"}$

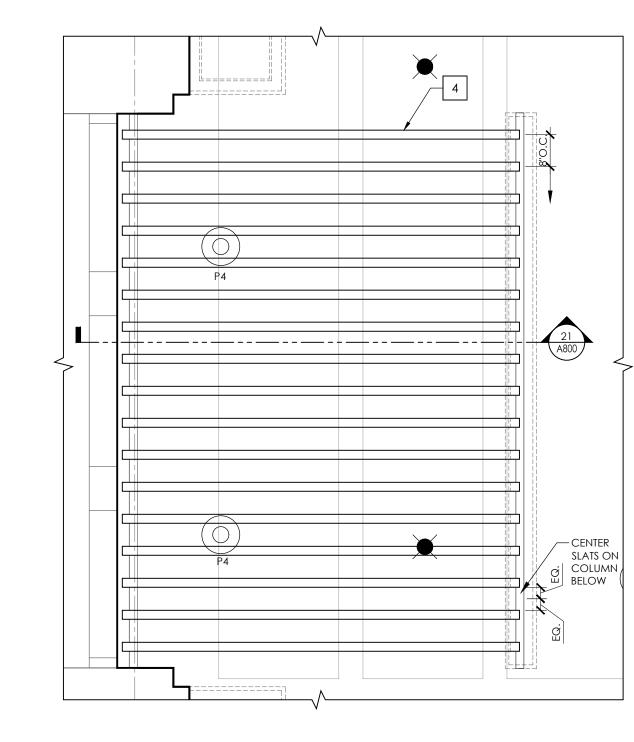

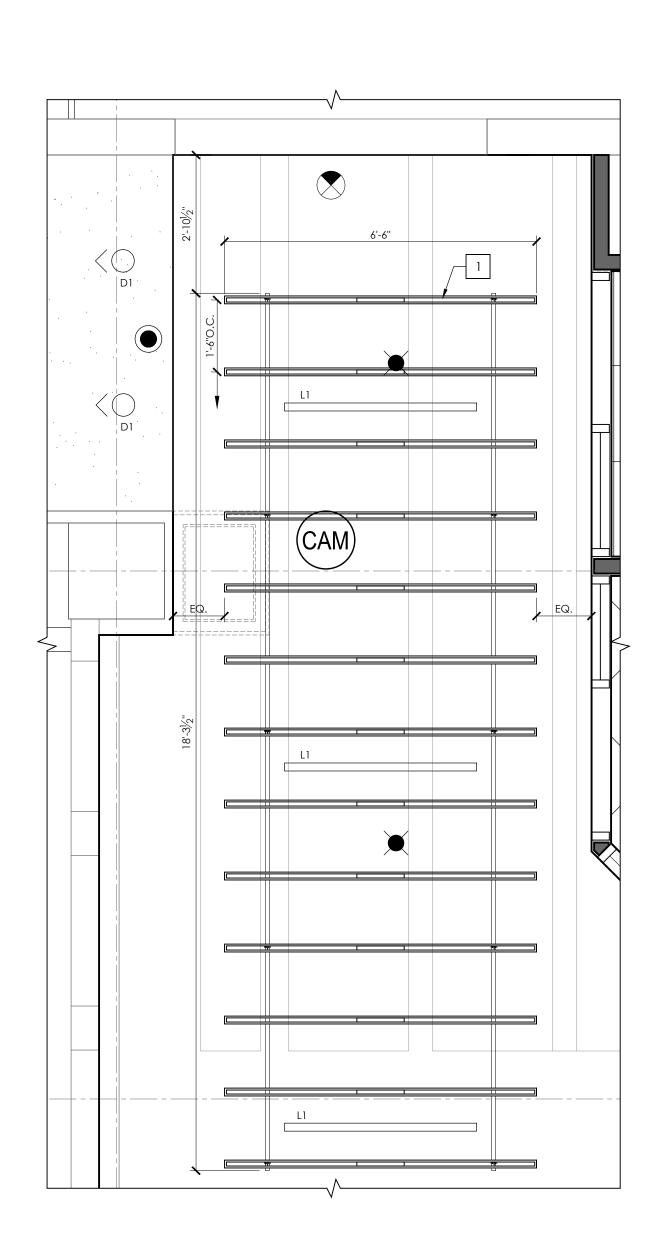

ENLARGED RCP AT CEILING ELEMENT AS-1

1/2" = 1'-0"

O" 6" 1' 2' 3'

GENERAL RCP NOTES

- 1. REFLECTED CEILING PLAN IS FOR LAYOUT PURPOSES ONLY, COORDINATE FINAL LOCATIONS WITH ALL DISCIPLINES.
- 2. SEE TITLE SHEET FOR ADDITIONAL PROJECT NOTES & SHEET INDEX. 3. ALL CEILING GRIDS SHALL BE CENTERED IN SPACE AS SHOWN (UNO).
- 4. CENTER ALL LIGHT FIXTURES, OCCUPANCY SENSORS, SPRINKLER HEADS, ETC. 222 West Washington Ave. Suite 310 IN CEILING TILE (UNO). 5. ALL XTG SOFFITS TO REMAIN TO BE PAINTED PT-11 UNLESS OTHERWISE NOTED.
- 6. ALL EXPOSED DUCTWORK, SPRINKLER PIPES, AND OTHER PIPES IN EXPOSED CEILING AREAS TO BE PREPPED FOR PAINT AND PAINTED PT-12. SEE FINISH
- 7. SEE ELECTRICAL SHEETS FOR ELECTRICAL & LIGHTING INFORMATION. 8. SEE FIRE PROTECTION SHEETS FOR SPRINKLER SYSTEM INFORMATION.

9. SEE MECHANICAL/HVAC SHEETS FOR MECHANICAL INFORMATION.

10. G.P.C TO COORDINATE WITH MECHANICAL CONTRACTOR TO TEMPORARIL REMOVE AND RE-INSTALL EXISTING CEILING OUTSIDE OF PROJECT SCOPE FOR NEW WORK. SEE MECHANICAL DRAWINGS FOR LOCATIONS. 11. LIGHT FIXTURES IN EXPOSED CEILING AREAS TO BE CENTERED ON JOIST ABOVE UNLESS NOTED OTHERWISE. ALL LIGHTING TO BE ON DIMMERS.

KEYNOTES

- 1 AS-1 SUSPENDED FROM EXPOSED CLG 9'-4" A.F.F
- 2 AS-2 SUSPENDED FROM EXPOSED CLG 9'-4" A.F.F
- 3 AS-3 SUSPENDED FROM EXPOSED CLG 8'-7" A.F.F
- 4 SLAT SYSTEM, SEE ASSOCIATED INTERIOR ELEVATIONS AND DETAILS
- 5 RECESSED PROJECTOR, SEE ASSOCIATED DETAIL
- REPAIR XTG GWB SOFFIT, PAINT GWB PT-11 AND MATCH GWB TEXTURE OF XTG SOFFIT
- 7 GWB AT COVE LIGHT CONDITIONS IN ROOM TO BE PAINTED PT-6

PAINT THE ENTIRE CEILING PT-7.

- 8 NEW GWB AT XTG FRAMING PAINTED PT-6 GPC TO DEMO THE GWB CEILING AS NEEDED FOR THE ABOVE CEILING PLUMBING AND MECHANICAL WORK. GPC TO INSTALL NEW GWB AND

RCP LEGEND

4" WALL WASHER - SEE ELECTRICAL DRAWINGS

SEE ELECTRICAL DRAWINGS

- 4" LED RECESSED CAN LIGHT SEE ELECTRICAL DRAWINGS
- LINEAR WALL SCONCE MOUNTED PER ASSOCIATED
- INTERIOR ELEVATIONS SEE ELECTRICAL DRAWINGS
- LED WALL SCONCE, MOUNTED 8" TO C.O. FIXTURE FROM B.O. GWB SKYLIGHT SOFFIT - SEE ELECTRICAL DRAWINGS
- SUSPENDED LINEAR LED; MOUNTED 9'-3" A.F.F. UNLESS OTHERWISE NOTED - SEE REFLECTED CEILING PLAN ELECTRICAL DRAWINGS

LED WALL SCONCE, MOUNTED 3'-4" A.F.F TO B.O. FIXTURE -

- RECESSED DIRECT INDIRECT LINEAR LED SEE ELECTRICAL DRAWINGS
- CYLINDER PENDANT LIGHT, MOUNTED 10'-0" A.F.F. TO B.O.
- FIXTURE SEE ELECTRICAL DRAWINGS
- SEE REFLECTED CEILING PLAN AND ELECTRICAL
- DECORATIVE PENDANT LIGHT, MOUNTED 6'-0" A.F.F. TO B.O. FIXTURE - SEE ELECTRICAL DRAWINGS
- DECORATIVE PENDANT LIGHT, MOUNTED 5'-10" A.F.F. TO CENTER OF FIXTURE - SEE ELECTRICAL DRAWINGS
- LED LIGHT CLOSET LIGHT SEE ELECTRICAL DRAWINGS
- UNDER CABINET LIGHT SEE ELECTRICAL DRAWINGS
- TRACK LIGHTING; MOUNTING HEIGHT VARIES SEE
 - OCCUPANCY SENSOR SEE ELECTRICAL DRAWINGS


 - WIRELESS ACCESS POINT SEE ELECTRICAL DRAWINGS
 - SPRINKLER HEAD SEE FIRE SUPPRESSION DRAWINGS





WHITE NOISE MACHINE - SEE ELECTRICAL DRAWINGS

O.F.O.I MICROPHONE - SEE ELECTRICAL DRAWINGS

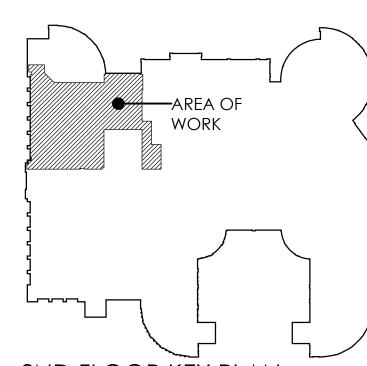



Madison, WI 53703 ph: 608.268.1499 www.destreearchitects.com ESTREE DESIGN ARCHITECTS HOLDS ALL RIGHTS INCLUDING TH DPYRIGHT OF THIS DOCUMENT, AS WELL AS THE CONCEPTS AND DESIGNS INCORPORATED HEREIN AS AN INSTRUMENT OF SERVICE AS PROPERTY OF DESTREE DESIGN ARCHITECTS IT IS NOT TO BE COPIED. DISTRIBUTED. OR USED IN WHOLE OR PART WITHOUT TH XPRESS WRITTEN CONSENT OF DESTREE DESIGN ARCHITECTS.

Engineering

Henneman

1241 John Q Hammons Dr, Suite 503 Madison, Wisconsin 53717

T 608.833.7000

Email: info@henneman.com

Website: http://www.henneman.com

JOB NO. 22-10300C

OF E

WISCONSIN




DECORATIVE PENDANT LIGHT, MOUNTING HEIGHT VARIES

LED COVE LIGHT - SEE ELECTRICAL DRAWINGS


EXIT SIGN - SEE ELECTRICAL DRAWINGS


ROUGH-IN FOR FUTURE CAMERA - SEE ELECTRICAL

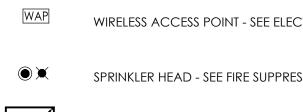



SUPPLY AIR DUCT - SEE MECHANICAL DRAWINGS

CLG SPEAKER O.F.O.I BY OWNERS REP AVI

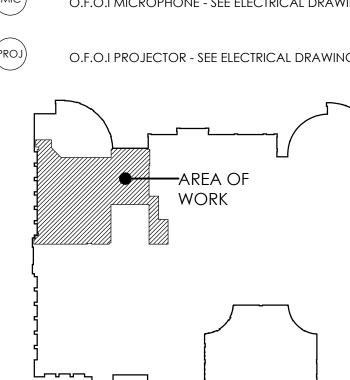

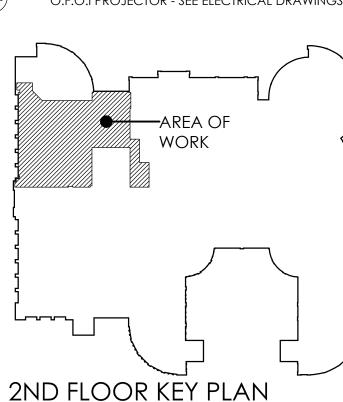

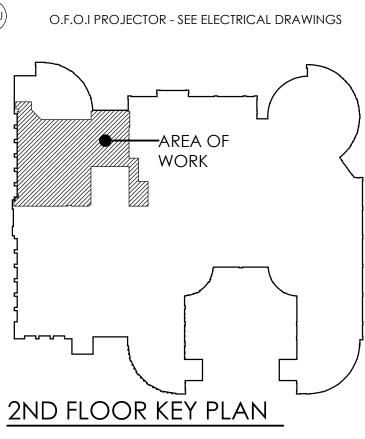

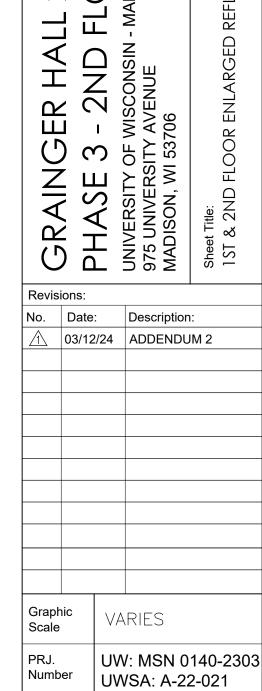

Туре

Issued

Sheet Number

02/20/2024

\(\)

	ELECTRICAL A	BBRE	/IATIONS
A, AMP	AMPERE	MMS	MANUAL MOTOR STARTER SWITCH
AC	ABOVE COUNTER	MOA	MULTI-OUTLET ASSEMBLY
AFF	ABOVE FINISHED FLOOR	MPS	MOTORIZED PROJECTION SCREEN
AIC	AMPERE INTERRUPTING CAPACITY	MTS	MOTOR RATED TOGGLE SWITCH
ACT	ACUOSTICAL CEILING TILE	MTR	MOTOR
AL	ALUMINUM	МС	MECHANICAL CONTRACTOR
ARCH	ARCHITECT, ARCHITECTURE	MFR	MANUFACTURER
ATS	AUTOMATIC TRANSFER SWITCH	MWS	MOTORIZED WINDOW SHADE
AUX	AUXILIARY	N/C	NORMALLY CLOSED
AV	AUDIO - VISUAL	N/O	NORMALLY OPEN
AP	ACCESS PANEL	NEC	NATIONAL ELECTRICAL CODE
ВС	BELOW COUNTER	NEMA	NATIONAL ELECTRICAL MFR'S ASSOC.
втм	воттом	NF	NON-FUSED SAFETY SWITCH
С	CONDUIT	NIC	NOT IN CONTRACT
СВ	CIRCUIT BREAKER	nl	NIGHT LIGHT
CCTV	CLOSED CIRCUIT TELEVISION	NTS	NOT TO SCALE
CLG	CEILING	o.c.	ON CENTER
COFF	COFFEE MAKER	OL	OVERLOADS
CRT	CATHODE-RAY TUBE	Р	POLE
C/T	CURRENT TRANSFORMER	PF	POWER FACTOR
CU	COPPER	PH	PHASE
CTR	COUNTER	PNL	PANEL
DC	DIRECT CURRENT	PP	PUSH PLATE, AUTO DOOR OPERATOR
DED	DEDICATED	PB	PULLBOX
DISC	DISCONNECT	PRI	PRIMARY
DO	DOOR OPERATOR, POWERED	P/T	POTENTIAL TRANSFORMER
DN	DOWN	PVC	POLYVINYL CHLORIDE
DW	DISHWASHER	PC	PLUMBING CONTRACTOR
EC	ELECTRICAL CONTRACTOR	RMC	RIGID METALLIC CONDUIT
ECB	ENCLOSED CIRCUIT BREAKER	REF	REFRIGERATOR
ELEC	ELECTRIC, ELECTRICAL	REQD	REQUIRED
EM	EMERGENCY	RVT	REDUCED VOLTAGE TRANSFORMER
EMT	ELECTRICAL METALLIC TUBING	S/N	SOLID NEUTRAL
		1	

EQ EQUIPMENT

EF EXHAUST FAN

EXT EXTERIOR

FLR FLOOR

GND, GRD GROUND

FA FIRE ALARM

ELECTRIC WATER COOLER

EMERGENCY POWER OFF

FVNR FULL VOLTAGE NON-REVERSING

FIRE DEPARTMENT

FIRE SMOKE DAMPER FUSED SAFETY SWITCH

FURNITURE BASE FEED

GROUND FAULT CIRCUIT INTERRUPTER

GROUND FAULT CIRCUIT INTERRUPTER

GARBAGE DISPOSAL, SINK MOUNTED

HEATING, VENTILATING, AIR CONDITIONING

INTERMEDIATE METALLIC CONDUIT

HAND-OFF-AUTOMATIC SWITCH

HEATING CONTRACTOR

HORSEPOWER

HD HAND DRYER

KV KILOVOLT

KW KILOWATT

HIGH VOLTAGE

JUNCTION BOX

KILOVOLT-AMPERE

KILOWATT HOUR

LOW VOLTAGE

MCB MAIN CIRCUIT BREAKER

MICRO MICROWAVE OVEN

MISC MISCELLANEOUS MLO MAIN LUGS ONLY

MINIMUM

KILOVOLT-AMPERE REACTIVE

MOTOR CONTROL CENTER

MOTOR CIRCUIT PROTECTOR

EXISTING TO REMAIN

EXISTING

EWC

ETR

EPO

FSD

HVAC

JB

KVA

KWH

MCC

MIN

SPEC SPECIFICATION

SURGE PROTECTION DEVICE

SPKR SPEAKER

SP SPARE

SW SWITCH

SWBD SWITCHBOARD

SQFT SQUARE FOOT

SS STAINLESS STEEL

SC SECURITY CONTRACTOR

TCP TEMPERATURE CONTROL PANEL

TELEVISION

UNDERGROUND

UOD UNLESS OTHERWISE DENOTED

VFD VARIABLE FREQUENCY DRIVE

VC VENTILATION CONTRACTOR

WEATHERPROOF

2S1W 2 SPEED SINGLE WINDING

2S2W 2 SPEED DOUBLE WINDING

DIV. 26 DIVISION 26 CONTRACTOR

UCR UNDERCOUNTER REFRIGERATOR

TFA TO FLOOR ABOVE

TFB TO FLOOR BELOW

UNDERGROUND TELEPHONE

WIRE GUARD/PROTECTIVE SHIELDING

UNIT HEATER

SWGR SWITCHGEAR

TEL TELEPHONE

XFMR TRANSFORMER

TC TIME CLOCK

TERM TERMINAL

TYP TYPICAL

V VOLT

VA VOLT AMPERES

VOL VOLUME

W WATT

W/ WITH

W/O WITHOUT

SPD

MCS MOLDED CASE SWITCH NOTE: THIS IS A COMPOSITE LIST OF ABBREVIATIONS, NOT ALL PERTAIN SPECIFICALLY TO THIS JOB.

GENERAL NEW WORK NOTES:

- 1) ALL BRANCH CIRCUITS SHALL HAVE EQUIPMENT GROUND CONDUCTORS.
- 2) THE ELECTRICAL CONTRACTOR SHALL PROVIDE, IF REQUIRED, ADJUSTMENTS (±) 6'-0" IN THE LOCATION OF ALL SYSTEM DEVICES, FIXTURES, OUTLETS, PANELS, ETC. IN ORDER TO EXPEDITE THE ELECTRICAL WORK. THE POSITION OF ALL WORK AS SHOWN IS INTENDED TO BE FIXED AND IN THE PROPER LOCATION. SUCH REQUIRED ADJUSTMENT SHALL BE DETERMINED BY THE A/E..
- 3) PROVIDE SEPARATE NEUTRAL FOR EACH BRANCH CIRCUIT PHASE CONDUCTOR.

FAMILIARIZE HIMSELF WITH EXISTING WALL CONSTRUCTION.

- 4) SEE ARCHITECTURAL SHEETS FOR EXACT LOCATION OF DEVICES. DEVICES SHOWN ON ARCHITECTURAL ELEVATIONS. COORDINATE LOCATION OF DEVICES WITH ARCHITECT'S FIELD PERSON TO ENSURE PROPER LOCATION AND HEIGHT.
- 5) WHERE NEW DEVICES ARE SHOWN THE ELECTRICAL CONTRACTOR SHALL DO ALL CUTTING. THE GENERAL CONTRACTOR SHALL DO ALL PATCHING AND PAINTING OF EXISTING WALLS. THE ELECTRICAL CONTRACTOR SHALL
- 6) SMOKE DETECTORS SHALL BE MOUNTED A MINIMUM OF 6'-0". FROM EACH AIR SUPPLY DIFFUSER.

GENERAL ELECTRICAL DEMOLITION REQUIREMENTS:

- ELECTRICAL CONTRACTOR SHALL BE RESPONSIBLE FOR HIS OWN DEMOLITION, REMOVAL, CAPPING, STORING, ABANDONING, DISCONNECTING, RELOCATING AND RECONNECTION OF EXISTING ELECTRICAL EQUIPMENT AND MATERIAL. ALL CUTTING, PATCHING, REPAIRING, REPLACEMENT AND REFINISHING, SHALL MATCH THE EXISTING CONSTRUCTION AS NEARLY AS POSSIBLE.
- EXCEPT WHERE OTHERWISE SHOWN OR NOTED ON DRAWING "TO BE RETAINED, RELOCATED" OR HEREINAFTER NOTED, ALL EXISTING ELECTRICAL EQUIPMENT AND MATERIAL IN AREAS TO BE REMODELED/ALTERED SHALL BE REMOVED WHERE THEY INTERFERE WITH PROPOSED NEW CONSTRUCTION AND/OR INTERFERE WITH PROPOSED USAGE OF SPACE BY OWNER AS FOLLOWS:
- A) REMOVE ANY CONDUITS PROTRUDING ABOVE FINISHED FLOOR, CAP AND FINISH OVER WITH FLOOR MATERIAL TO MATCH EXISTING.
- B) REMOVE ALL LIGHT FIXTURES, RECEPTACLES, SWITCHES, ETC. AND ASSOCIATED WIRING. REMOVE ALL SURFACE MOUNTED CONDUIT/BOXES AND THEIR ASSOCIATED WIRING.
- REMOVE ALL CONCEALED RACEWAYS, BOXES AND WIRING FROM PARTITIONS BEING DEMOLISHED.
- D) REMOVE ALL EXISTING WIRING/CABLING FROM ALL EXISTING CONCEALED RACEWAYS IN PARTITION THAT ARE TO REMAIN.
- E) ANY FEEDERS, CONDUITS, BRANCH CIRCUITS, SIGNAL AND TELEPHONE CIRCUITS, ETC. PASSING THROUGH THE REMODELED AREAS TO SERVE (OR BE SERVED FROM) EXISTING ADJACENT, REMOTE OR SURROUNDING AREAS THAT ARE TO REMAIN, SHALL BE RETAINED AND KEPT OPERATIONAL AND SHALL BE REROUTED IN ALL CASES WHERE THEY INTERFERE WITH ANY NEW WORK OR USAGE TO BE ACCOMPLISHED IN THE REMODELED AREA.
- F) WHERE DEVICES ARE OMITTED FROM PRESENT BRANCH CIRCUITS. THE REMAINING DEVICES SHALL BE REWIRED, IF NEEDED AND AS REQUIRED, TO REMAIN ON THEIR RESPECTIVE CIRCUITS AND IN OPERATING CONDITION.
- 6) ELECTRICAL CONTRACTOR SHALL REFER TO ARCHITECTURAL DRAWINGS TO FAMILIARIZE HIMSELF WITH EXTENT OF ALTERATION/REMODELING WORK AND MORE SPECIFICALLY NOTE WHERE NEW PARTITIONING IS BEING INSTALLED, WHERE EXISTING PARTITIONING IS BEING REMOVED, WHERE CEILINGS ARE BEING REMOVED AND OR REPLACED, ETC.
- ALL WIRING (POWER, LIGHTING) NOT REUSED FOR REMODELING AREAS SHALL BE COMPLETELY REMOVED BACK TO ASSOCIATED PANELS.

SYMBOL	DESCRIPTION
FACP	FIRE ALARM CONTROL PANEL
FAAP	FIRE ALARM ANNUNCIATOR PANEL
BATT	REMOTE BATTERY CABINET
NAC	NOTIFICATION APPLIANCE CIRCUIT EXTENDER
AMP	AMPLIFIER CABINET, AUDIO RISER CABINET
	FIRE ALARM PULL STATION
M	FIRE ALARM MINI HORN
$\mathbb{H} \diamondsuit$	FIRE ALARM HORN/STROBE
S	FIRE ALARM SPEAKER
S O	FIRE ALARM SPEAKER/STROBE
S ♦ WP	FIRE ALARM SPEAKER/STROBE, EXTERIOR WEATHERPROOF
⊕	CEILING MOUNTED FIRE ALARM SPEAKER/STROBE
®	CEILING MOUNTED FIRE ALARM SPEAKER
\bigcirc	CEILING MOUNTED FIRE ALARM STROBE
	FIRE ALARM STROBE, (#) IS CANDELA RATING
S	INTELLIGENT PHOTOELECTRIC SMOKE DETECTOR
Ø _{ER}	INTELLIGENT PHOTOELECTRIC SMOKE DETECTOR FOR ELEVATOR RECALL
H	INTELLIGENT 135F FIXED & RATE OF RISE HEAT DETECTOR
ØS AHU-x	INTELLIGENT PHOTOELECTRIC DUCT SMOKE DETECTOR
	— ASSOCIATED VENTILATION EQUIPMENT FOR SHUT DOWN.
ММ	MONITOR MODULE
СМ	CONTROL MODULE
DH	MAGNETIC DOOR HOLDER
TS	SPRINKLER TAMPER SWITCH
FS	SPRINKLER FLOW SWITCH
R	FAN SHUTDOWN RELAY
RTS/I	REMOTE TEST SWITCH W/INDICATOR

TELE	COMMUNICATIONS SYSTEMS
SYMBOL	DESCRIPTION
▼X	DATA
₹X	DATA ABOVE COUNTER
$\overset{AV}{ abla}$	BACK BOX ONLY FOR AUDIO VISUAL EQUIPMENT
▼ X	TELECOMMUNICATIONS ABOVE COUNTER
▼ ^X	TELECOMMUNICATIONS, FLOOR MOUNTED
\bigcirc X	TELECOMMUNICATIONS, CEILING MOUNTED
WAP	WIRELESS ACCESS POINT (CEILING-MOUNTED DATA) - (2) DATA CABLES
CR	CARD READER
KP	KEY PAD
CAM	CAMERA ROUGH IN - (1) DATA CABLE
SCH	ROOM SCHEDULER - (1) DATA CABLE, COIL 10 FT ABOVE LOCATION
ES	ELECTRIC STRIKE
□₿	BELL

X = NUMBER OF DATA/CONNECTORS NOTE: THIS IS A COMPOSITE LIST, NOT ALL SPECIFIC TO THIS PROJECT.

	POWER SYSTEMS
SYMBOL	DESCRIPTION
SWBD 1	LARGE ELECTRICAL EQUIPMENT WITH DESIGNATION - DRAWN TO SCALE
	DISTRIBUTION PANEL WITH DESIGNATION
6888	BRANCH PANEL WITH DESIGNATION
9	MOTOR WITH DESIGNATION
	DISCONNECT SWITCH
<u>J</u>	JUNCTION BOX
РВ	PULL BOX
PT	POKE-THRU MODULAR FURNITURE FEED, POWER
□ x	EQUIPMENT CONNECTION
• × <u> </u>	EQUIPMENT CONNECTION - EMERGENCY — CONNECTION TYPES: REFER TO EQUIPMENT CONNECTION SCHEDULE(S)
PP (→	AUTOMATIC DOOR OPERATOR ACTIVATION PUSH PLATE
ЕРО 开	EMERGENCY POWER OFF STATION
1	DENOTES WALL MOUNTING
14 FF W 2C,2N+G	SYSTEM FURNITURE BASE FEED LOCATION (2) 2 GANG JUNCTION BOXES: (1) POWER, (1) LOW VOLTAGE
20.20+6	MOUNTING CONFIGURATION: W - WALL PP - POWER POLE/SYSTEMS FURNITURE
	CONDUCTOR QUANTITY #C = QTY PHASE CONDUCTORS #N = QTY NUETRAL CONDUCTORS G = EQUIPMENT GROUND
	CIRCUIT NUMBER(S)
⊠ PP	POWER POLE

	RECEPTACLES
SYMBOL	DESCRIPTION
Ф	SIMPLEX RECEPTACLE
Ф	SIMPLEX RECEPTACLE ABOVE COUNTER
₩X	DUPLEX RECEPTACLE
	 DUPLEX RECEPTACLE TYPES: EWC - ELECTRIC WATER COOLER, PROVIDE GFCI BREAKER IN ELEC PANE G - GROUND FAULT CIRCUIT INTERRUPTER TV - TELEVISION OUTLET T - TAMPER RESISTANT W - WEATHER RESISTANT PRJ - CEILING MOUNTED VIDEO PROJECTOR USB - USB CHARGING DEVICE, REFER TO SPEC FOR CONFIGURATION
 	DUPLEX RECEPTACLE ABOVE COUNTER
#	DOUBLE DUPLEX RECEPTACLE
FB	SYSTEM FLOORING - FLOOR MOUNTED DUPLEX RECEPTACLE BY FLOORING CONTRACTOR
ZB	SYSTEM FLOORING ZONE BOX - UNDER FLOOR SYSTEM MOUNTED BY FLOORING CONTRACTOR
#	CEILING MOUNTED DUPLEX RECEPTACLE
⊠ PP	POWER POLE
SR 0	RECEPTACLES IN SURFACE RACEWAY ASSEMBLY — RACEWAY DESIGNATION, SEE SURFACE RACEWAY SCHEDULE

	LIGHTING FIXTURES
SYMBOL	DESCRIPTION
O F1 - 23 - a	— FIXTURE TYPE — CIRCUIT — CONTROL DEVICE
0	SURFACE/ RECESSED LINEAR MOUNT, NORMAL POWER
	SURFACE/ RECESSED LINEAR MOUNT, EMERGENCY POWER
Â	LINEAR WALL WASH, NORMAL POWER
	LINEAR WALL WASH, EMERGENCY POWER
	LINEAR PENDANT, NORMAL POWER
	LINEAR WALL MOUNTED, NORMAL POWER
$\vdash \!$	SURFACE/SUSPENDED MOUNT, NORMAL POWER
$\vdash \!$	SURFACE/SUSPENDED MOUNT, EMERGENCY POWER
0	SURFACE / RECESSED DOWNLIGHT, NORMAL POWER
•	SURFACE / RECESSED DOWNLIGHT, EMERGENCY POWER
0>	SURFACE / RECESSED WALL WASH, NORMAL POWER
•>	SURFACE / RECESSED WALL WASH, EMERGENCY POWER
Ю	WALL MOUNTED SCONCE OR WALLPACK, NORMAL POWER
⊢●	WALL MOUNTED SCONCE OR WALLPACK, EMERGENCY POWER
&	EXIT SIGN, CEILING MOUNTED - FACES AND ARROWS AS SHOWN
\tilde{\Phi}	EXIT SIGN, WALL MOUNTED - FACES AND ARROWS AS SHOWN
■ 🕏	BATTERY PACK EMERGENCY LIGHTING
Ţ	DENOTES WALL MOUNTING OF LIGHT

		SWITCHES
	SYMBOL	DESCRIPTION
	1€9 X	SINGLE POLE (LOWER CASE LETTER INDICATES SWITCH LEG) — SWITCH TYPES: 2 - DOUBLE POLE 3 - THREE WAY 4 - FOUR WAY D - DIMMER OS - OCCUPANCY SENSOR MWS - MOTORIZED WINDOW SHADE STATION
	H-X	LOW VOLTAGE LIGHTING CONTROL SYSTEM SWITCH (LOWER CASE LETTER INDICATES SWITCH LEG) SWITCH TYPES: 2B - 2 BUTTON (VIVE) 3BRL - 3 BUTTON WITH RAISE LOWER (VIVE)
	SC	SCENE CONTROL
	©§ osa	OCCUPANCY SENSOR — SWITCHING DESIGNATION
	⊘ osa	VACANCY SENSOR — SWITCHING DESIGNATION
	ER	EMERGENCY LIGHTING CONTROL RELAY, UL924 LISTED WITH 0-10V SHUNT
_		ILING OCCUPANCY/VACANCY SENSORS SERVING VAV SERVED AREAS AUXILLIARY CONTACT FOR DDC OCCUPANCY SETBACK SIGNAL

LINE WEIGHT KEY

ALL ITEMS INDICATED BY A DARK SOLID LINE ARE NEW ALL ITEMS INDICATED BY A LIGHT SOLID LINE ARE EXISTING TO REMAIN ----- ALL ITEMS INDICATED BY A DARK DASHED LINE ARE EXISTING TO BE REMOVED OR RELOCATED.

	FIXTURE				L	AMP			BALLA	ST/DRIVER			MOUNT	ING			MANUFACTURER		
ID	DESCRIPTION	DIFFUSE	R WATT	S TYP	PE TEMP	CRI	LUMENS	TYPE	DIM TYPE	DIM RANGE	VOLTAGE	LOCATION	CONFIGURATION	TYPE	HEIGHT	NAME	MODEL NUMBER	SEE NOTE	COMMENTS
C1	LED COVE LIGHT		7.8/F	T LE	D 4000K	90	750/FT	ELD	0-10V	1-100%	24VDC	CEILING	SURFACE	GYP	UNDER SOFFIT	PINNACLE ARCHITECTURAL LIGHTING	C-940MO-XX-CV-U-FSD-1-FSG		SEE DRAWING FOR FIXTURE LENGTH
C1-M	LED COVE LIGHT MARKER BOARE		7.8/F	T LEC	D 4000K	90	750/FT	ELD	0-10V	1-100%	24VDC	CEILING	SURFACE	GYP	UNDER SOFFIT	PERFEKT	WW-SL-375-90=40-MAL-1-W-UNV-DP-S(L)		SEE DRAWING FOR FIXTURE LENGTH R LENGHTS OF MARKER BOARD 22 FT
C2	UNDER CABINET LIGHT		18	LEC	D 4000K	84	310/FT	ELD	0-10V	1-100%	MVOLT	CEILING	SURFACE	CABINET	UNDER CABINET	SOLID STATE LUMINAIRES	UNLE-3-4K-WH POWER SUPPLY-UN100i-DIM		
D1	4" APERATURE RECESSED ROUND LED WALL WASH ADJUSTABLE DOWNLIGHT		11.4	LEC	D 4000K	90	1000	ELD	0-10V	10-100%	MVOLT	CEILING	RECESSED	ACT	FLUSH WITH CEILING	GOTHAM	EVO4WW-WDIM-40/10-AR-LSS-MVOLT-GZ10-90CRI		
D2	4" APERATURE RECESSED ROUND LED DOWNLIGHT		9		D 4000K	90	1000	ELD	0-10V	10-100%	MVOLT	CEILING	RECESSED	ACT	FLUSH WITH CEILING	GOTHAM	EVO4-WDIM-40/10-AR-LSS-MD-MVOLT-GZ10-90CRI		***************************************
L1	SUSPENDED LINEAR LED DIRECT/INDIRECT CONTINUOUS RUN LENGTH	ACRYLIC L	ENS 5.66/F	T LE	D 4000K	90	700/FT	ELD	0-10V	1-100%	MVOLT	CEILING	SUSPENDED	VARIES	SEE DWG	LUMENWERX	VIA1.5P-DI-HLO-0.5D-HLO-SW-90-350-350-40-CONTINUOUS RUN*-UNV-D1-2C-EC-STS-W		
L2	RECESSED LINEAR LED DIRECT CONTINUOUS RUN LENGTH	ACRYLIC L	ENS 5.66/F	T LE	D 4000K	90	700/FT	ELD	0-10V	1-100%	MVOLT	CEILING	RECESSED	VARIES	SEE DWG	LUMENWERX	VIA1.5P-D-HLO-0.5D-SW-90-350-350-40-CONTINUOUS RUN*-UNV-D1-1C-EC-MFM-W		* REFER TO FLOOR PLAN FOR CONTIN RUN LENTHS WITH EMERGENCY SECT
P2	6" CYLINDER PENDANT	——————————————————————————————————————	~~~~		D 4000K		~~~	ELD	0-10V	1-100%	MVOLT	CEILING	PENDANT	~~~~	SEE DWG	GOTHAM	EVO6-40/10-AR-LSS-MVOLT-RGH-PCAN45XW-S8-DWHG	••••	
Р3	MUTTO FLUID PENDANT LAMP		5	LE	D 3000K	90	260	ELD	0-10V	1-100%	120V	CEILING	PENDANT		SEE DWG	MUUTO	100301994		* THE LARGER OF THE FIXTURE TYPES
P4	LOUIS POULSEN PENDANT		22	LEI	3000K	80		ELD	0-10V	1-100%		CEILING	PENDANT		SEE DWG	LOUIS POULSEN	PH5-WHT-WHT		
P5	DOUBLE BOUBLE PENDANT		4.3	LEC	D 3000K	80		ELD	0-10V	1-100%	MVOLT	CEILING	PENDANT		SEE DWG	MODERN FORMS	PD-82006-BK		
S1	48" LINEAR LED STRIP LIGHT	ACRYLIC L	ENS 31	LEC	D 4000K	90		ELD	0-10V	10-100%	MVOLT	CEILING	SURFACE		CEILING	METALUX	4SNLED-LD5-46SL-UNV-EL7W-L940-CD1-U		
T1	SUSPENDED TRACK LIGHTING			LEC	D 4000K	90		ELD	0-10V	10-100%	MVOLT	CEILING	SUSPENDED		84" AFF	WAC	H-2020-940-WT-LENS-16-SPR		
W2	WALL SCONCE			LEC	D 4000K	90	2585	ELD	0-10V	10-100%	120V	WALL	SURFACE	GWB	60" AFF	WAC	WS-35849		
W3	WALL SCONCE			LEC	D 3000	90	2585	ELD	0-10V	10-100%	120V	WALL	SURFACE	GWB	VARIES	LUMENWERX	HEX2WASYA-HLO-LED-90-1000-40-5FT-UNV-1-W		
X1	THERMOPLASTIC UNIVERSAL MOUNT LED EXIT SIGN RED LETTERS		2.3	LE	D			ELD			MVOLT	CEILING	SURFACE	ACT	TBD	CHLORIDE ISOLITE SURELITES	VE SERIES RL-AC-R-U-WH-MTEB APX SERIES	1,2	

GENERAL NOTES: A. REFER TO INTERIOR LIGHTING SPECIFICATIONS FOR ADDITIONAL INFORMATION REGARDING FIXTURE, BALLAST OR DRIVER REQUIREMENTS AND INSTALLATION REQUIREMENTS.

B. NOTED LUMEN QUANTITY IS DELIVERED LUMEN OUTPUT

C. NOTED DIMMING RANGE INDICATES MINIMUM PARAMETERS. LUMINAIRES WITH GREATER DIMMING RANGE ARE PERMITED.

D. FIXTURES NOTED IN THIS SCHEDULE ARE TO ESTABLISH A BASIS OF DESIGN. PRODUCTS OTHER THAN THOSE LISTED IN THE SCHEDULE ARE PERMITTED SUBJECT TO MEETING THE REQUIREMENTS OF THE SCHEDULED FIXTURE'S QUALITY, PERFORMANCE, ENERGY, AESTHETICS, DIMENSIONS, ETC... E. PROVIDE EMERGENCY LIGHTING FIXTURES IN AREAS SHOWN ON DRAWINGS.

1. REFER TO FLOOR PLANS FOR CHEVRON QUANTITY, SIGN FACES AND DIRECTION.

ABBREVIATIONS: ELD - ELECTRONIC LED DRIVER OR POWER SUPPLY GWB - GYPSUM WALL BOARD, DRYWALL EPS - ELECTRONIC PROGRAM START FLUORESCENT BALLAST EPSD - ELECTRONIC PROGRAM START STEP DIMMING BALLAST: 0/50/100 LMNS - LUMENS DIM - DIMMING BF - BALLAST FACTOR

TBD - TO BE DETERMINED ACT - ACOUSTICAL CEILING TILE IN SUSPENDED GRID SYSTEM, ACCESSIBLE MVOLT - 120 & 277 VOLT COMPATIBLE CFL - COMPACT FLUORESCENT MLV - MAGNETIC LOW VOLTAGE

0-10V - ZERO TO TEN VOLT DC DIMMING FEATURE FDB - FLUORESCENT DIMMING BALLAST CMU - CONCRETE MASONRY BLOCK

architecture & design

222 West Washington Ave. Suite 310 Madison, WI 53703 ph: 608.268.1499

www.destreearchitects.com

DESTREE DESIGN ARCHITECTS HOLDS ALL RIGHTS INCLUDING THE COPYRIGHT OF THIS DOCUMENT, AS WELL AS THE CONCEPTS AND DESIGNS INCORPORATED HEREIN AS AN INSTRUMENT OF SERVICE. AS PROPERTY OF DESTREE DESIGN ARCHITECTS IT IS NOT TO BE COPIED, DISTRIBUTED, OR USED IN WHOLE OR PART WITHOUT THE EXPRESS WRITTEN CONSENT OF DESTREE DESIGN ARCHITECTS.

1241 John Q Hammons Dr, Suite 503 Madison, Wisconsin 53717 **T** 608.833.7000 Email: info@henneman.com Website: http://www.henneman.com

JOB NO. 22-10300C


DIS


UNIX 21 N PAF MADISON

2ND OOR

No. Date: Description: 103/12/24 ADDENDUM 2 Graphic Scale PRJ. UW: MSN 0140-2303 Number UWSA: A-22-021

BD Туре 02/20/2024 Issued

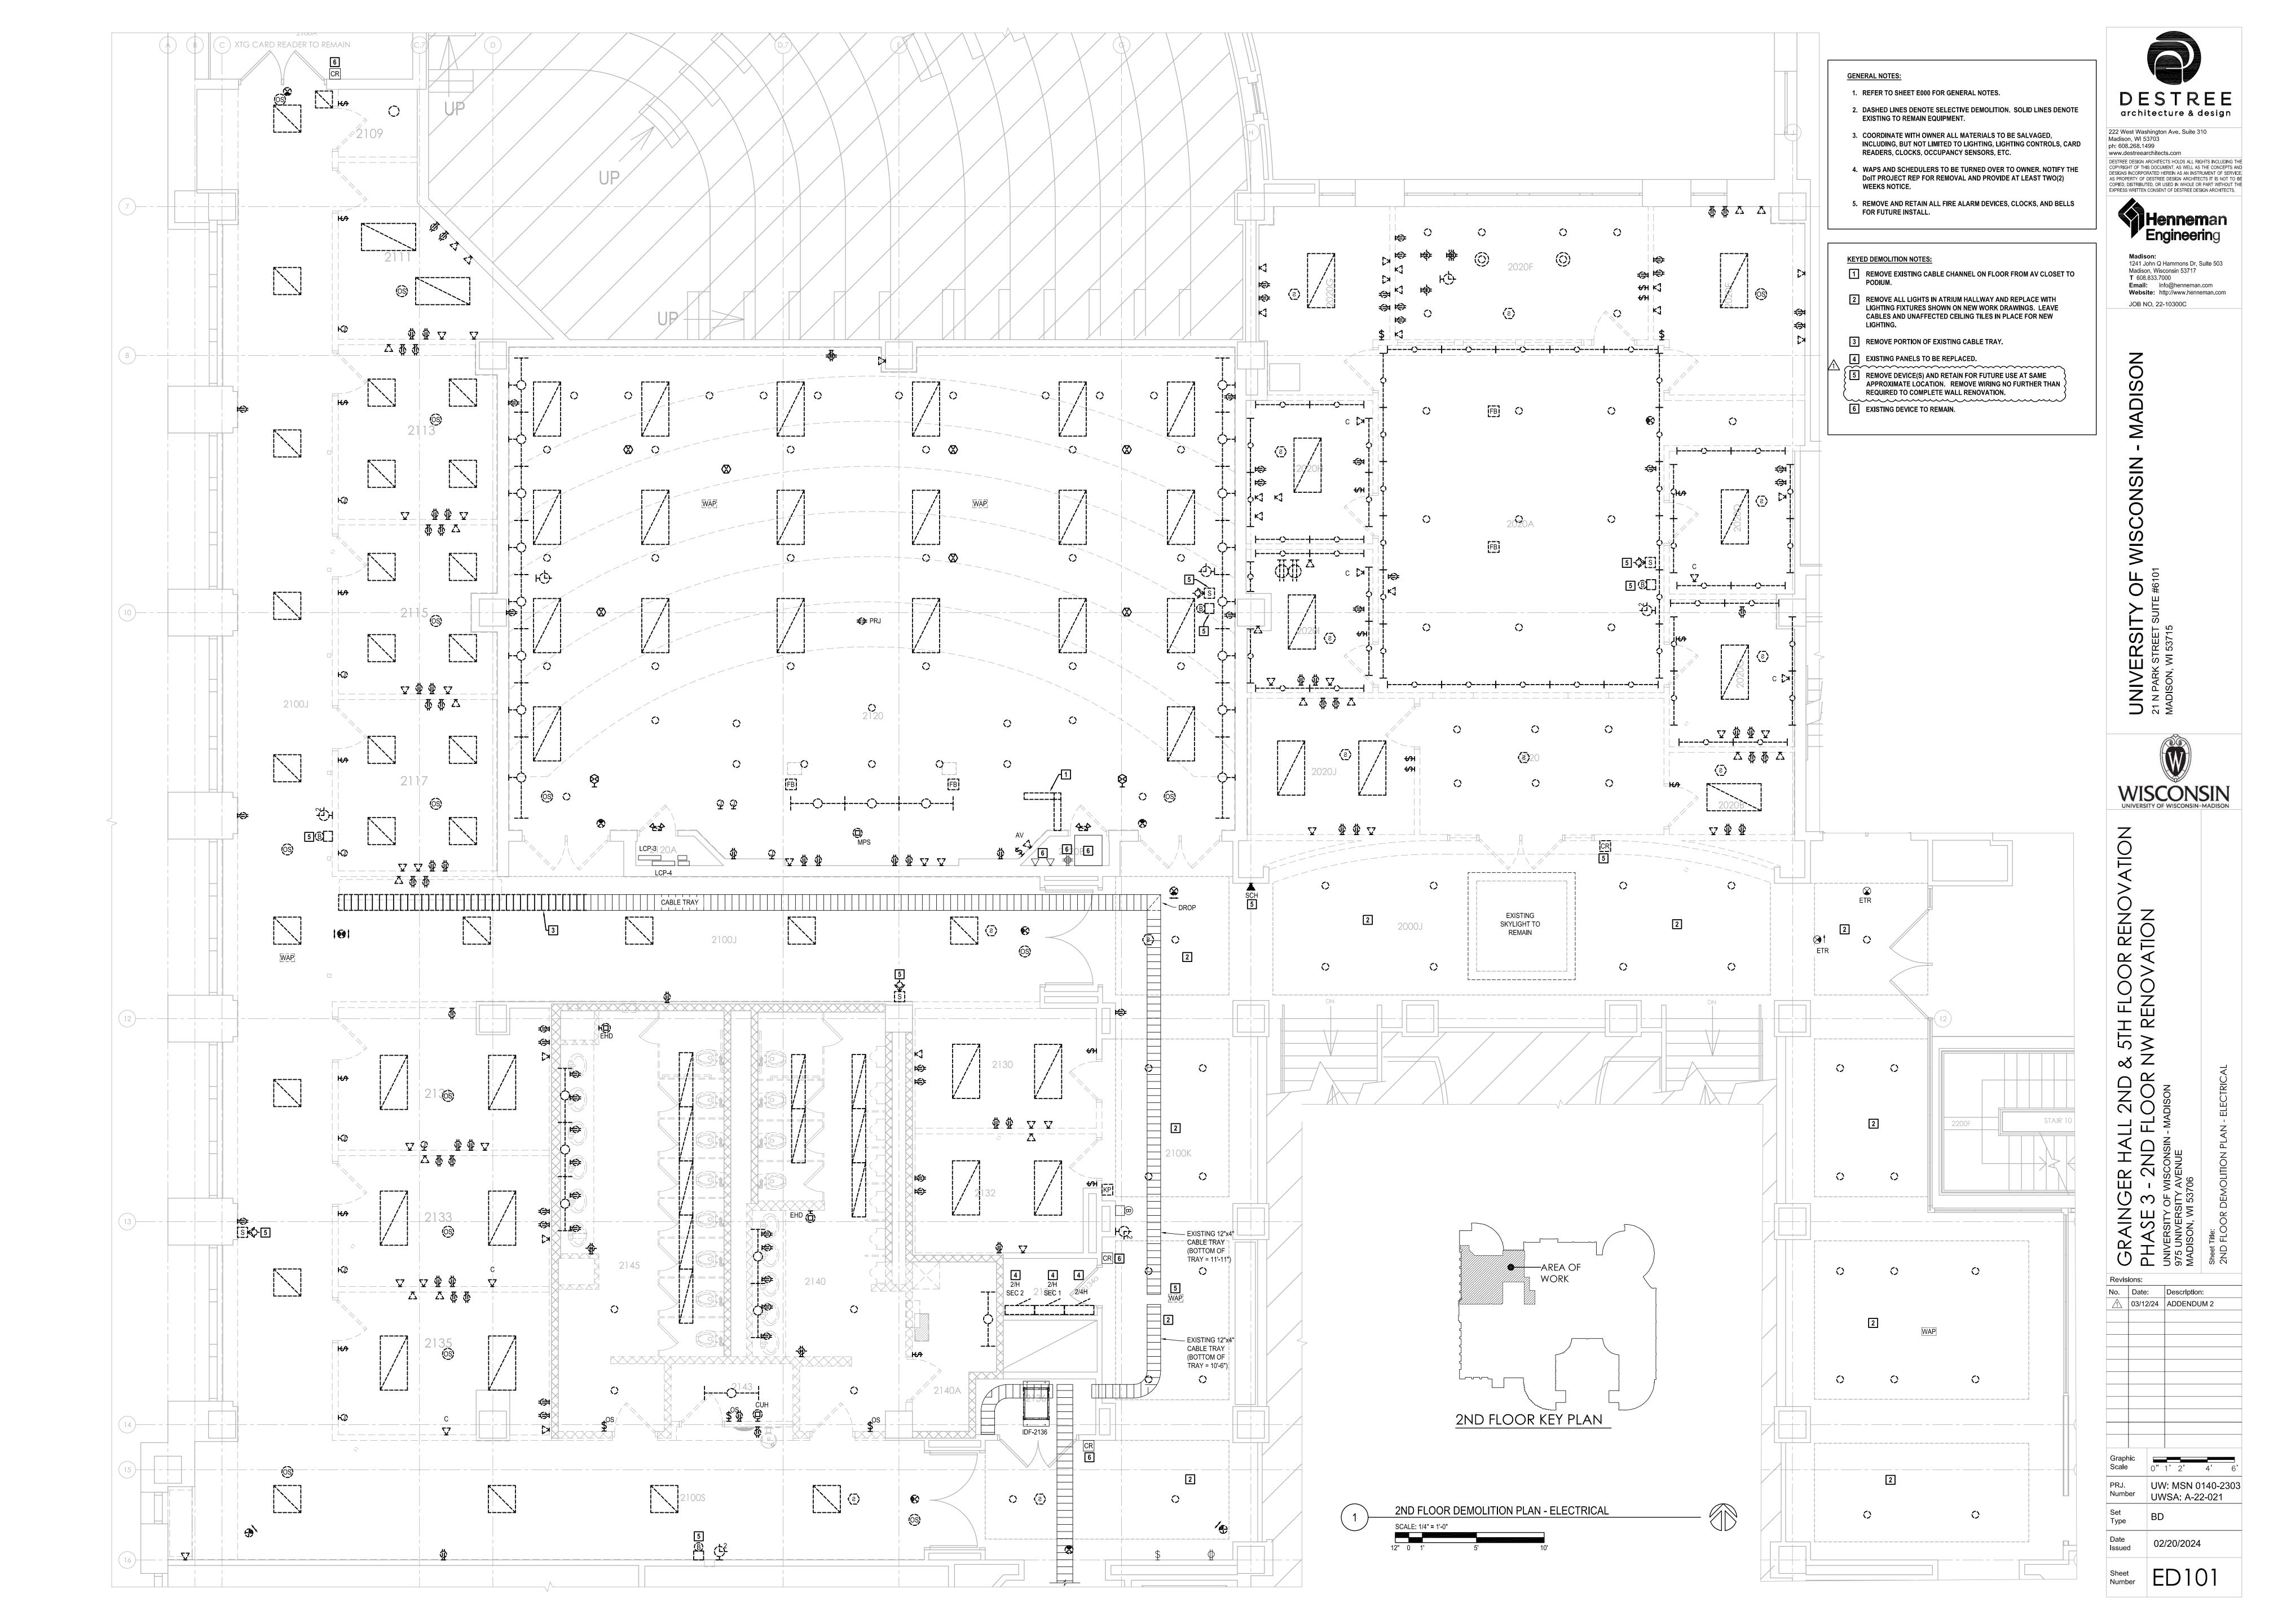

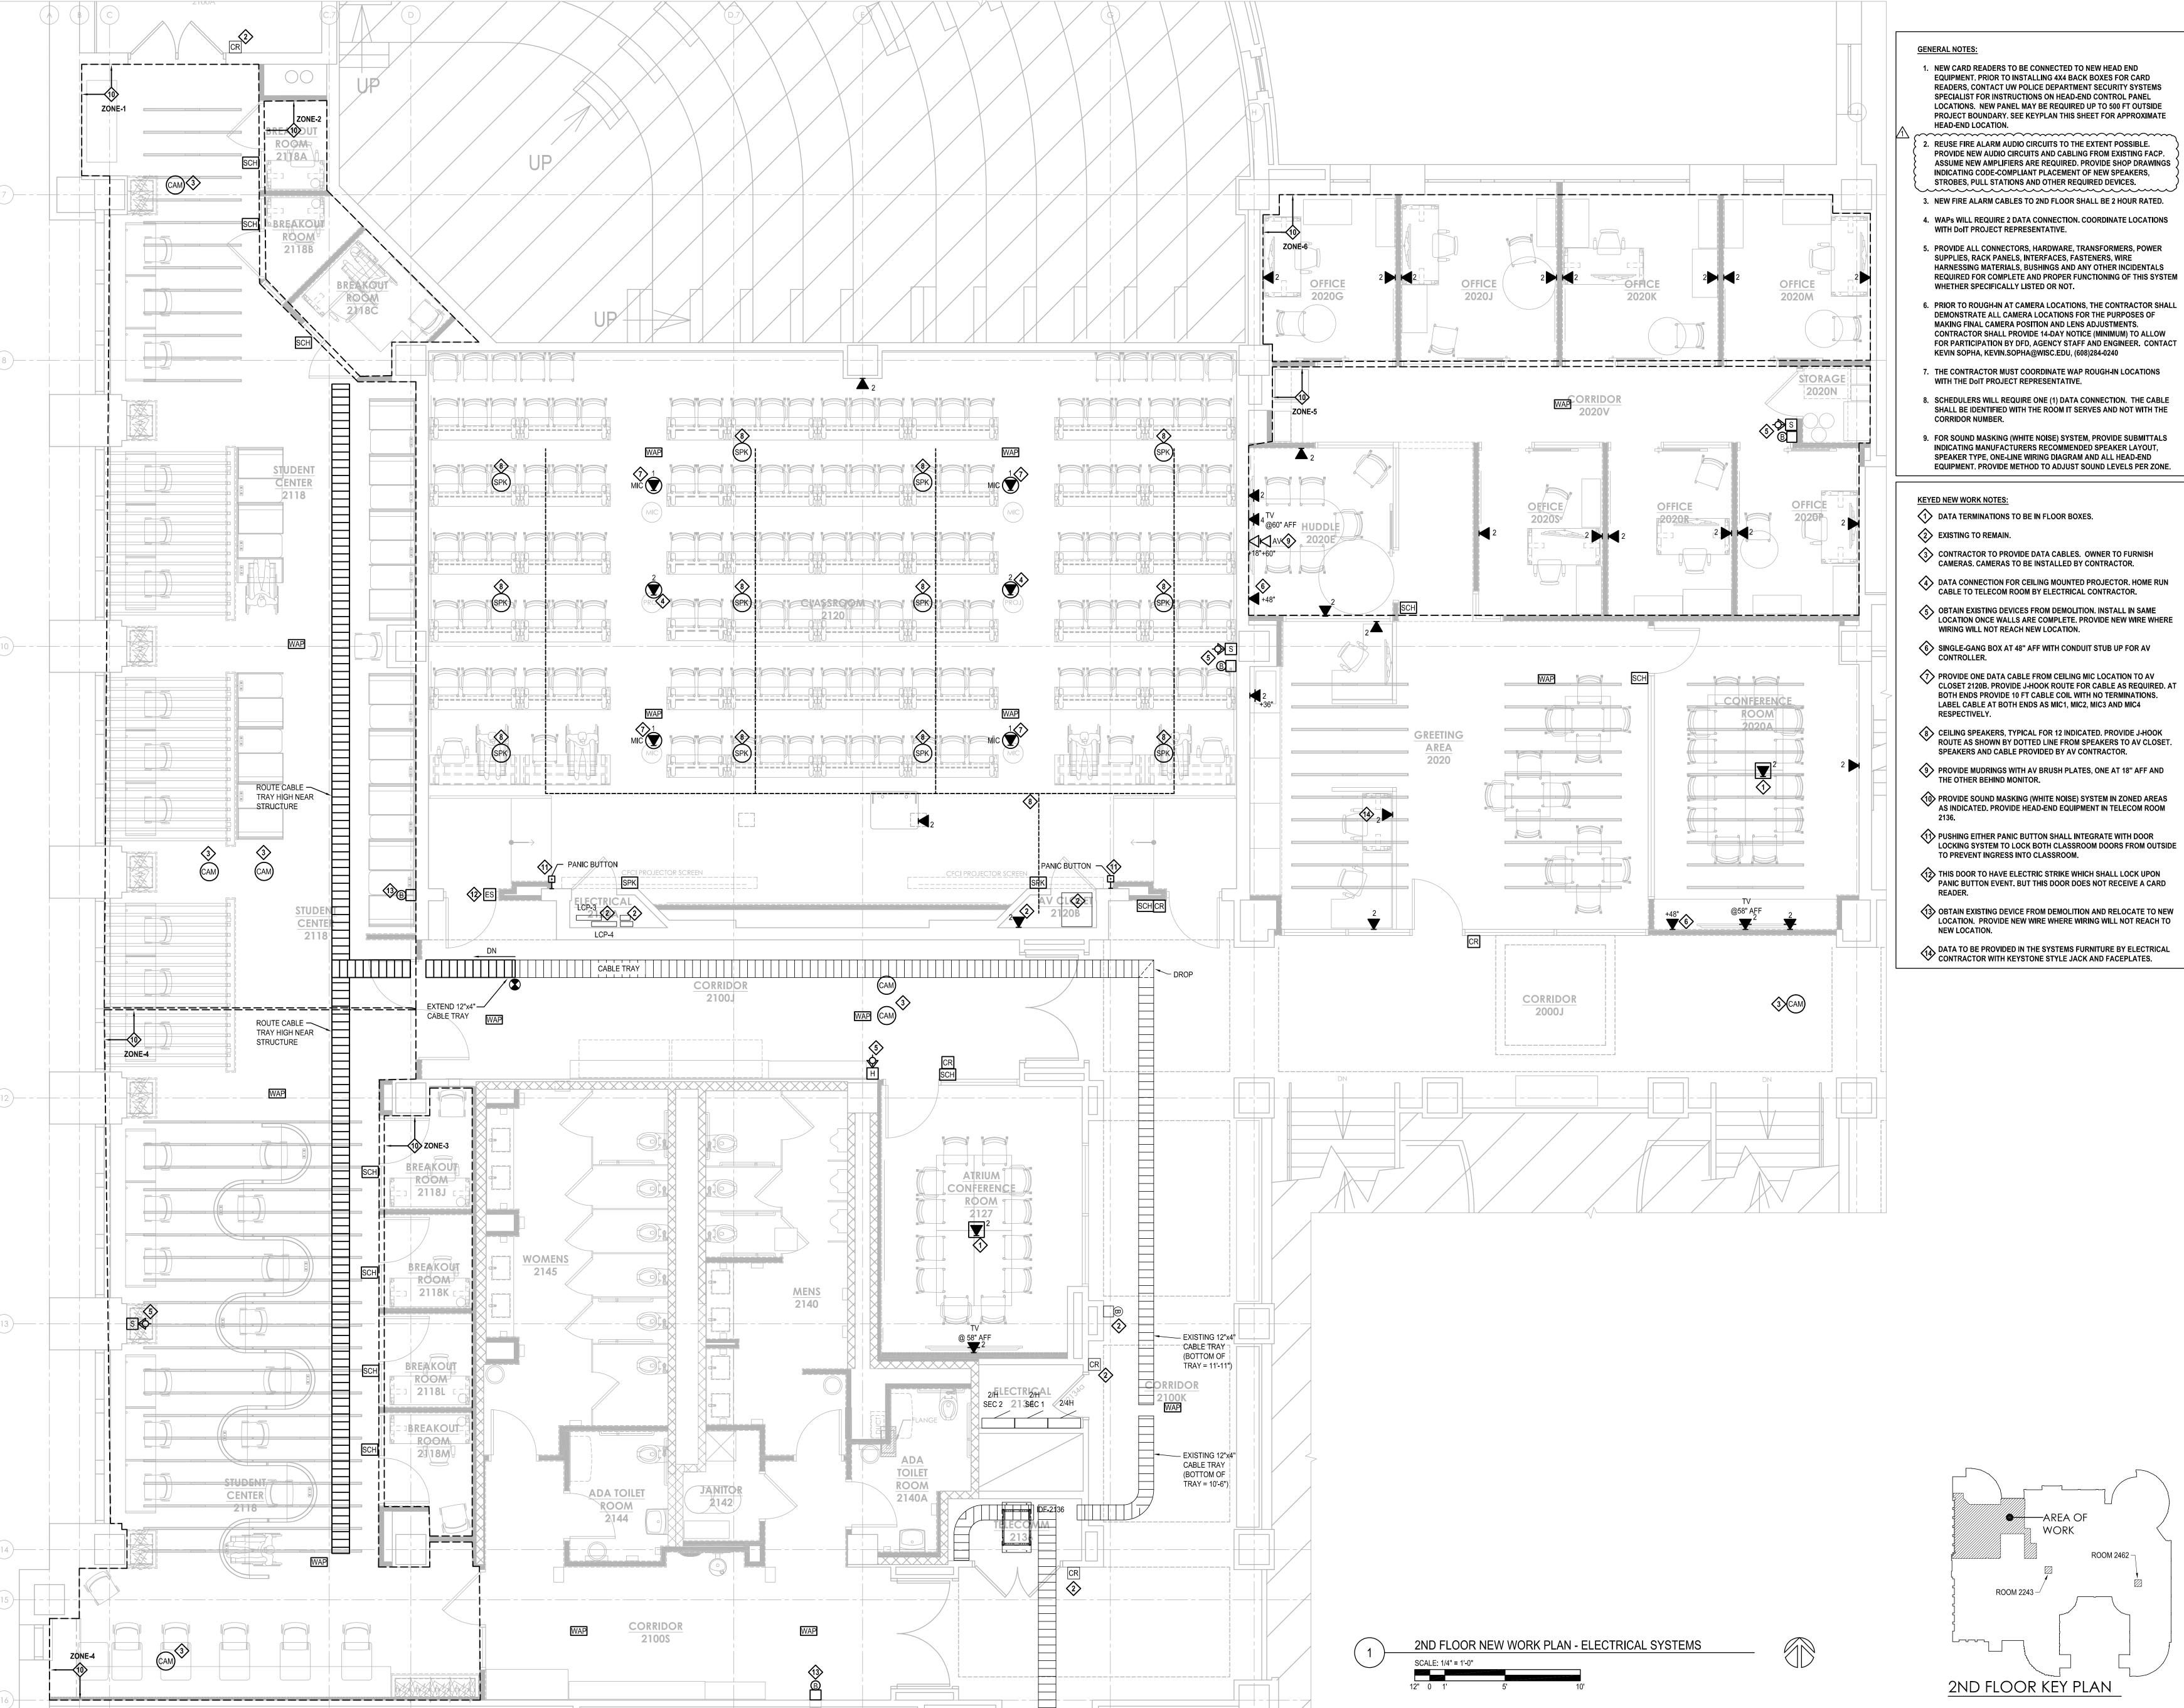

architecture & design

222 West Washington Ave. Suite 310 Madison, WI 53703 ph: 608.268.1499 www.destreearchitects.com DESTREE DESIGN ARCHITECTS HOLDS ALL RIGHTS INCLUDING THE OPYRIGHT OF THIS DOCUMENT, AS WELL AS THE CONCEPTS AND DESIGNS INCORPORATED HEREIN AS AN INSTRUMENT OF SERVICE. AS PROPERTY OF DESTREE DESIGN ARCHITECTS IT IS NOT TO BE

O

0

N PAF



COPIED, DISTRIBUTED, OR USED IN WHOLE OR PART WITHOUT THE EXPRESS WRITTEN CONSENT OF DESTREE DESIGN ARCHITECTS.

1241 John Q Hammons Dr, Suite 503 Madison, Wisconsin 53717 **T** 608.833.7000 Email: info@henneman.com Website: http://www.henneman.com JOB NO. 22-10300C


Revisions: No. Date: Description: △ 03/12/24 ADDENDUM 2 UW: MSN 0140-2303 UWSA: A-22-021

02/20/2024

ES101




EXISTING 2ND FLOOR PANELS 2/4H, 2/4H SEC 1, 2/4H SEC 2 PHOTO

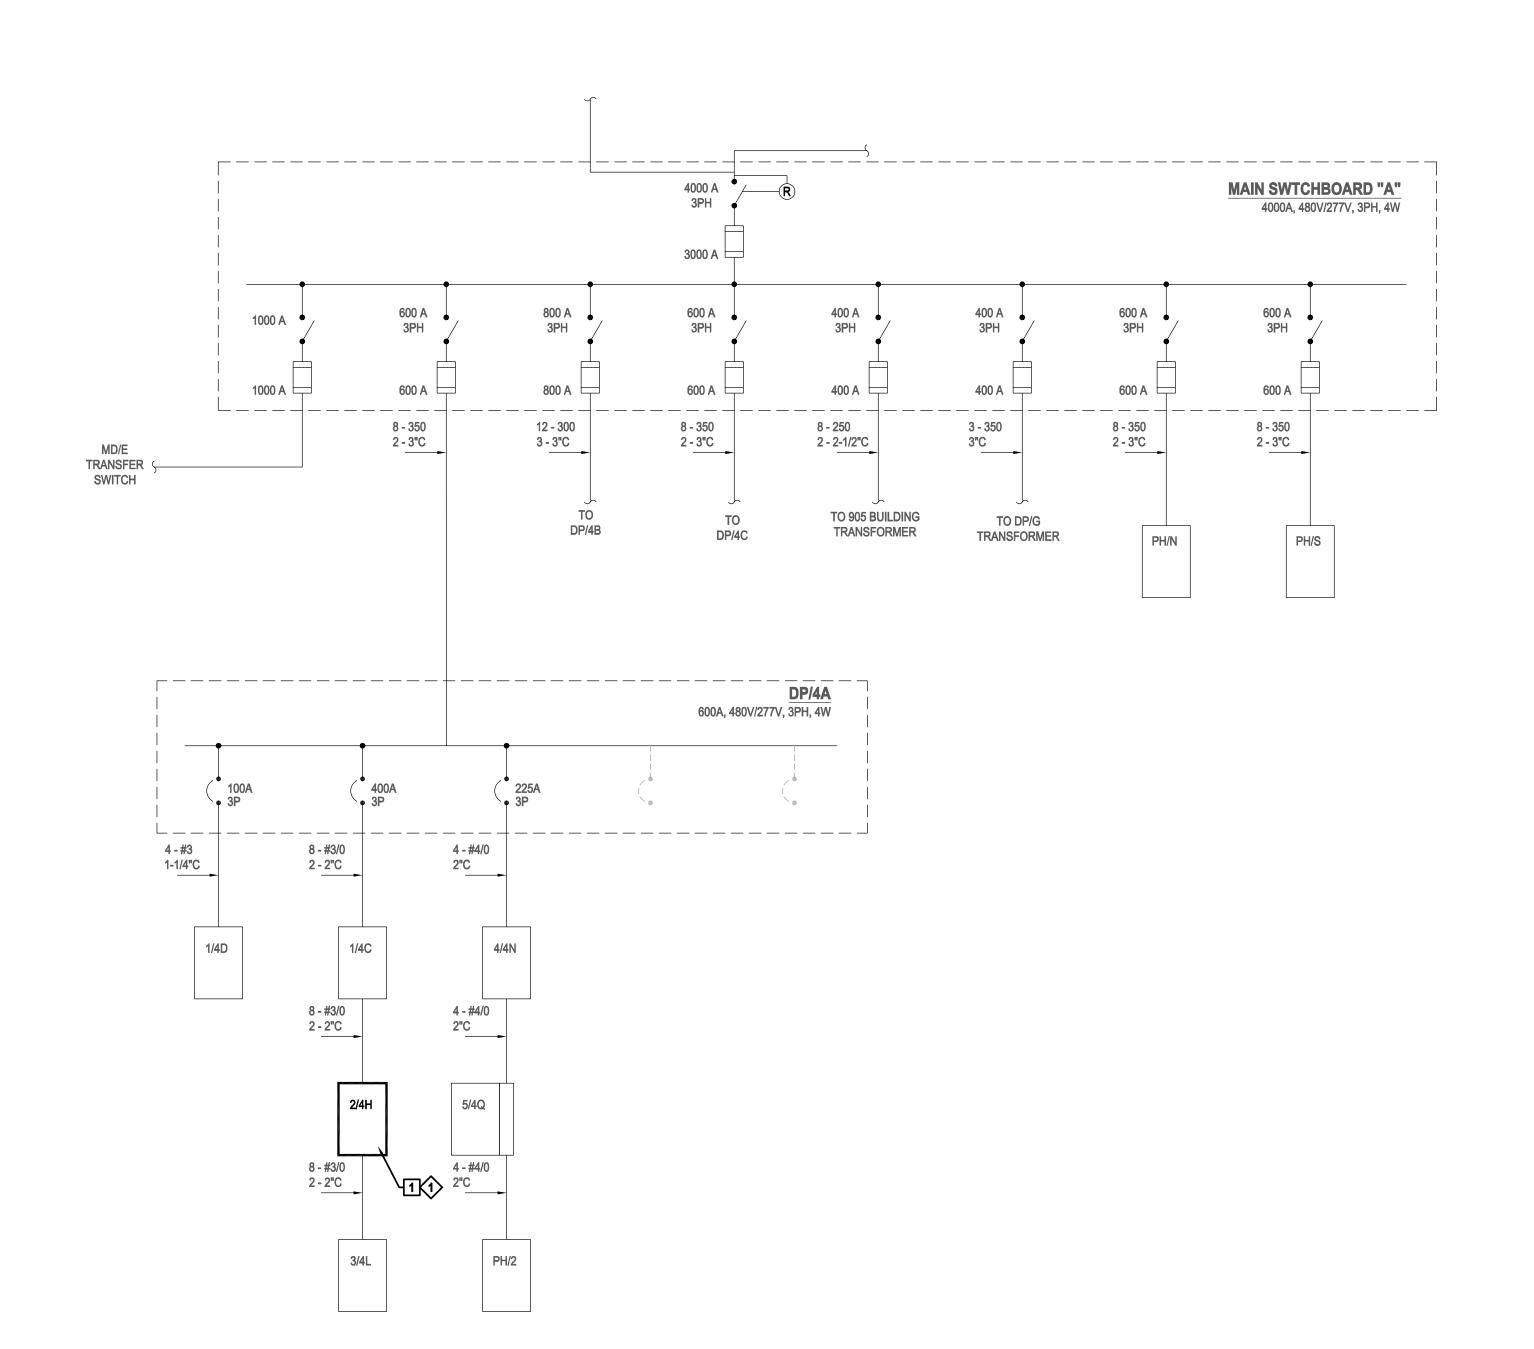





LINE WEIGHT KEY ----- ALL ITEMS INDICATED BY A DARK SOLID LINE ARE NEW ALL ITEMS INDICATED BY A LIGHT SOLID LINE ARE EXISTING TO ALL ITEMS INDICATED BY A DARK DASHED LINE ARE DEMO

	ONE LINE DIAGRAMS
SYMBOL	DESCRIPTION
MCC-1	ELECTRICAL EQUIPMENT WITH DESIGNATION
0 0	AUTOMATIC TRANSFER SWITCH
	MANUAL TRANSFER SWITCH
_	CIRCUIT BREAKER
₩	DRAW-OUT POWER CIRCUIT BREAKER
———	CONTACTOR
_	SWITCH
	FUSE
─	FUSED SWITCH
H 1	POTENTIAL TRANSFORMER
$-\infty$	CURRENT TRANSFORMER
\\\\\\\\\\\\\\\\\\\\\\\\\\\\\\\\\\\\\\	TRANSFORMER
M	METER
Y	INCOMING SERVICE
	BUS BAR
	FEEDER DESIGNATION
Δ	DELTA
Y≟	WYE
<u></u>	GROUND
SPD	SURGE PROTECTIVE DEVICE

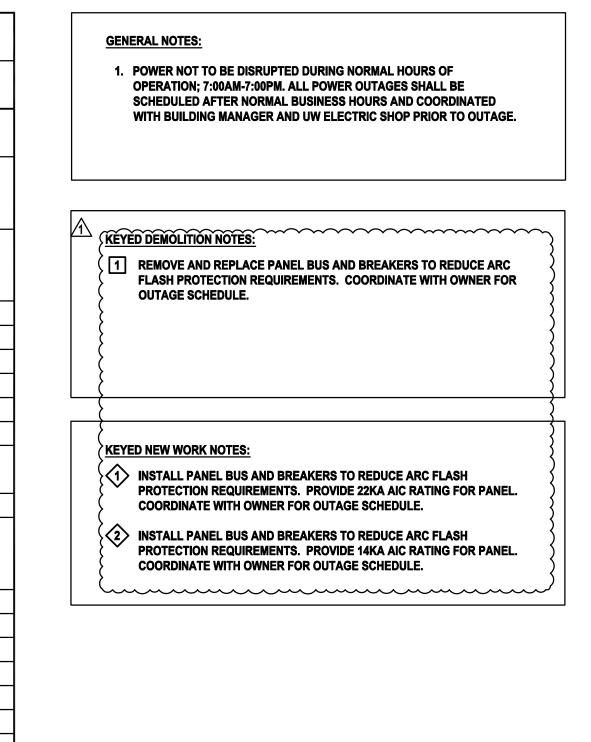

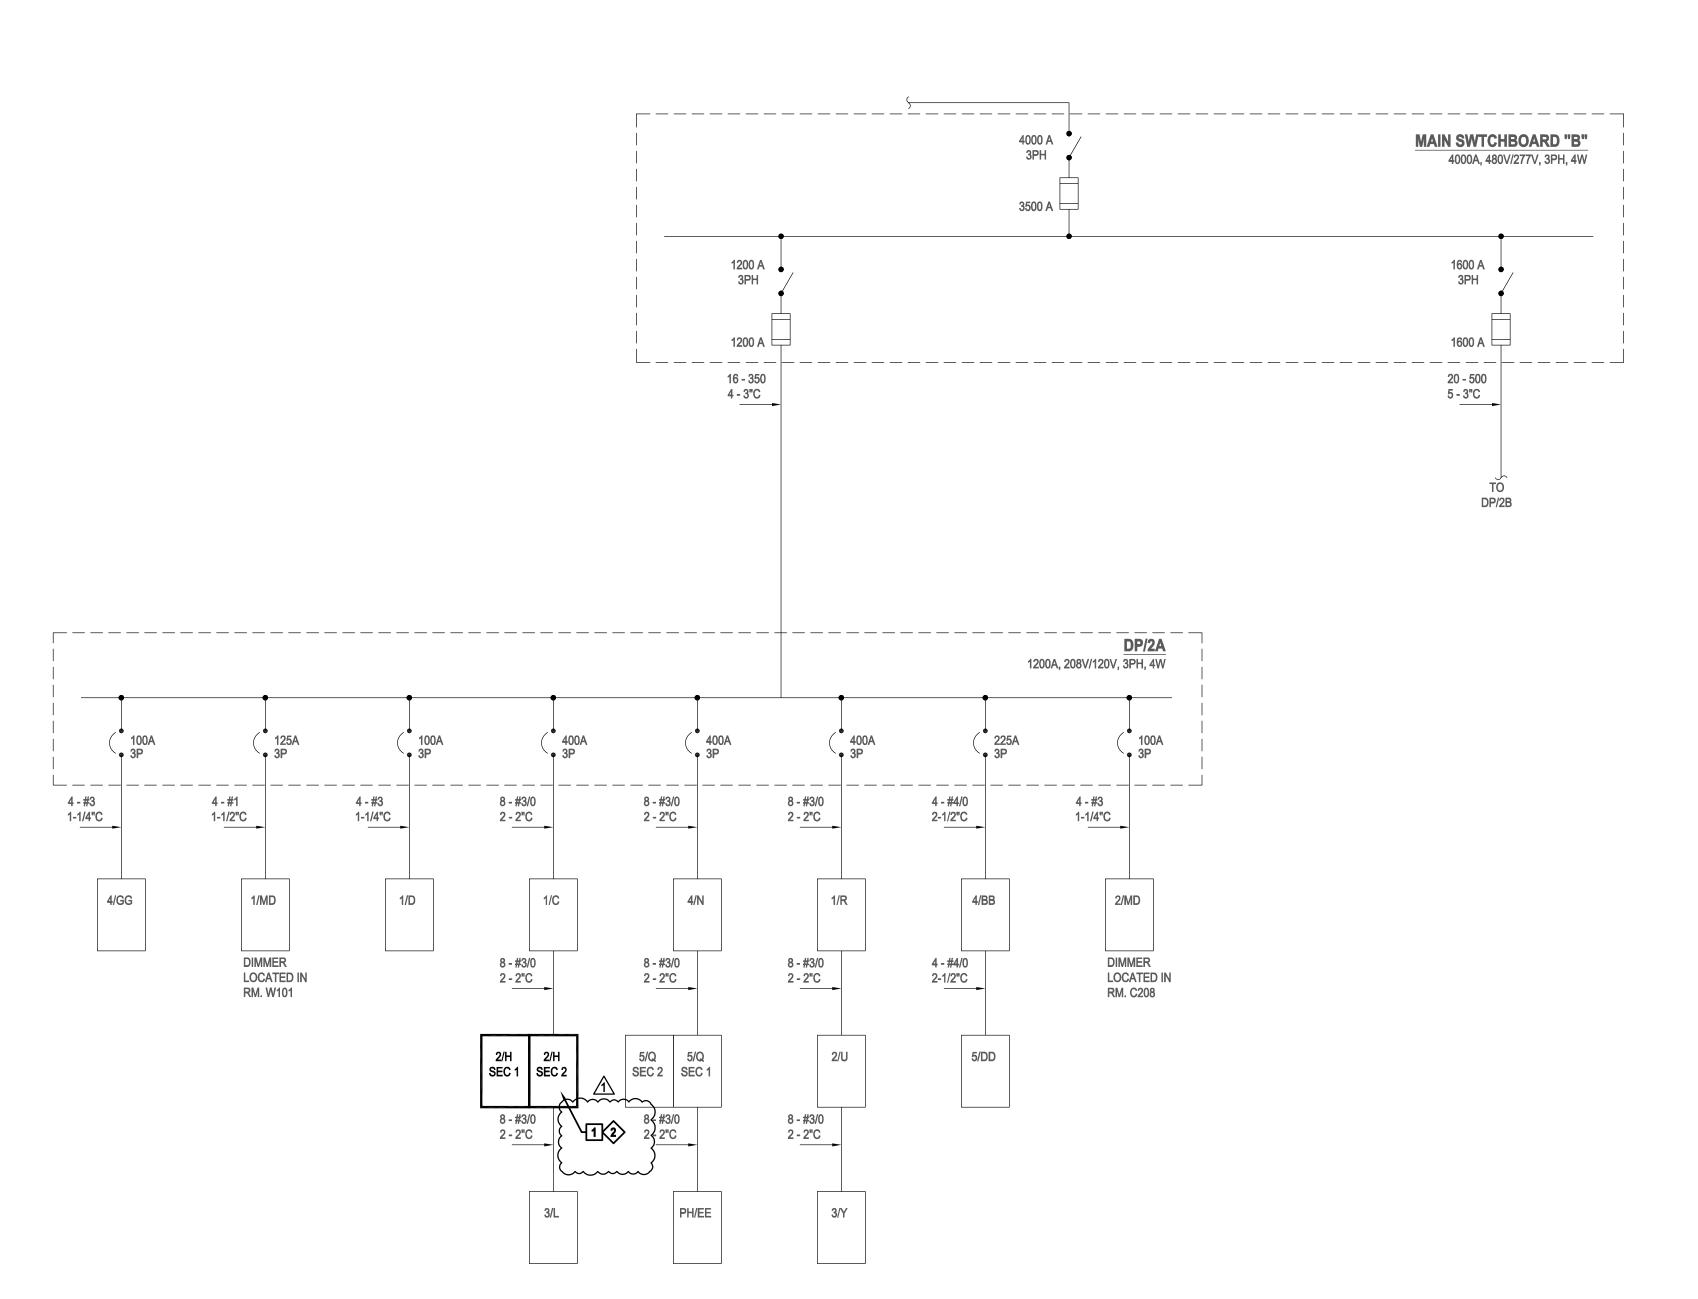

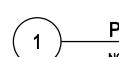

architecture & design 222 West Washington Ave. Suite 310 Madison, WI 53703 ph: 608.268.1499 www.destreearchitects.com DESTREE DESIGN ARCHITECTS HOLDS ALL RIGHTS INCLUDING THE COPYRIGHT OF THIS DOCUMENT, AS WELL AS THE CONCEPTS AND

DESIGNS INCORPORATED HEREIN AS AN INSTRUMENT OF SERVICE.
AS PROPERTY OF DESTREE DESIGN ARCHITECTS IT IS NOT TO BE
COPIED, DISTRIBUTED, OR USED IN WHOLE OR PART WITHOUT THE
EXPRESS WRITTEN CONSENT OF DESTREE DESIGN ARCHITECTS.

Madison: 1241 John Q Hammons Dr, Suite 503 Madison, Wisconsin 53717 T 608.833.7000 Email: info@henneman.com Website: http://www.henneman.com JOB NO. 22-10300C

MADISON **WISCONSIN** OF #6101



	Date	:	Description:
	03/12	2/24	ADDENDUM 2
ph le	nic	NT	S
J. nb	er		/: MSN 0140-2303 /SA: A-22-021
е		BD	

E401

PANELBOARD NAME	VO	LTA	GE		PHASE	WIRE	BUS S	ZE		V	ΛΑΙΝ	AIC RATING
2/H SECT 1 (DEMO)		208	/120		3	4	225			1	MLO	10KA
LOCATION	FEE	DΕ	ROM		SOURCE	OCATION	# OF Ch	(TS		M	TNUC	NEMA ENCLOSURE
RM 2134)P/2	Α		RM1	134	42			SU	RFACE	TYPE 1
LOAD	CB ACCESS.	POLE	BKR AMP	CKT#	VA	PHASE	VA	CKT#	BKR	POLE	CB ACCESS.	LOAD
LITES RM 2165		1	20	1	0	Α	0	2	20	1		RECPTS RM 2113,2111, ISO GR
LITES RM 2100L, 2159		1	20	3	0	В	0	4	20	1		RECPTS RM 2117, 2115, 2113, 212
LITES RM 2167		1	20	5	0	С	0	6	30	1		RECPTS RMS 2120, 2100J & 211
RECEPTS IDF-2136		1	20	7	0	Α	0	8	20	1		RECEPTS IDF-2136
HAND DRYER RM 2145		2	20	9	0	В	0	10	20	2		HAND DRYER RM 2140
HAND DRIER RIVI 2145			-	11	0	С	0	12	-	-	,	HAND DRIER RW 2140
		3	40	13	0	Α	0	14	-	-		SPACE
LCP-3 RM 2120		-	-	15	0	В	0	16	-	-		SPACE
		-	-	17	0	С	0	18	-	-		SPACE
SPACE		-	-	19	0	Α	0	20	-	-		SPACE
SPACE		-	-	21	0	В	0	22	-	-		SPACE
SPACE		-	-	23	0	С	0	24	- 3	-		SPACE
SPACE		-	-	25	0	Α	0	26	-	-		SPACE
SPACE		-	S.T.	27	0	В	0	28	-	-		SPACE
SPACE		-	:=:	29	0	С	0	30	-	-		SPACE
SPACE		-	-	31	0	Α	0	32	-	-		SPACE
SPACE		-	-	33	0	В	0	34	-	-		SPACE
SPACE		-	-	35	0	С	0	36	-	-		SPACE
SPACE		-	-	37	0	Α	0	38	-	-		SPACE
SPACE		-	-	39	0	В	0	40	-	-		SPACE
SPACE		-	-	41	0	С	0	42	-	-		SPACE
PANEL OPTIONS:			RE	CEF	PT-VA@	per NEC	198	TC	TAL C	ALC	C LOAD VA =	0
					STD-VA@	100%					USTED VA =	0
					OSPVA@						AND AMPS =	0
·····					AREVA@		-				EXIST. KW=	0
PANEL NOTES:					R-VA@	100%	-	LF			R LOAD VA =	0
SIEMENS PANELBOARD					N-VA@	100%	-			# O	F ELEV(S) =	0
T # BG42ML4225SBM }					′-VA @	per NEC	-					
J					EQ-VA@	100%			Parameter and the second		EN EQUIP =	0
			40		EQ-VA@	100%	173				PANEL(S) =	
					OR-VA@	100%	(=3)				H FACTOR =	0
			1	/ISC	-VA@	100%	3-3		TOTAL	DE	SIGN AMPS	0

												AIC PATING		
PANELBOARD NAME	12,000	LTA			PHASE	WRE	BUS SIZ	ZE		26%	MAIN	AIC RATING		
2/H SECT 1 (NEW)			/120		3	4	225				/ILO	(14KA		
LOCATION			ROM		SOURCE		# OF CK	TS			DUNT	NEMA ENCLOSURE		
RM 2134)P/2	A		RM1	134	42				RFACE	TYPE 1		
LOAD	CB ACCESS.	POLE	BKR	CKT#	VA	PHASE	VA	CKT#	BKR	POLE	CB ACCESS.	LOAD		
LITES RM 2165		1	20	1	0	Α	0	2	20	1		RECPTS 2118A,B,C		
LITES RM 2100L, 2159		1	20	3	0	В	0	4	20	1		RECPTS 2118		
LITES RM 2167		1	20	5	0	С	0	6	30	1		SMPS- ELEC RM 2134		
RECEPTS IDF-2136		1	20	7	0	Α	0	8	20	1		RECEPTS IDF-2136		
HAND DRYER RM 2145		1	20	9	360	В	360	10	20	1		HAND DRYER RM 2140		
HAND DRYER RM 2145,2144		1	20	11	720	С	720	12	20	1		HAND DRYER RM 2140,A		
		3	40	13	0	Α	1,440	14	20	1		FLOORBOX 2120		
LCP-3 RM 2120		i + i	-	15	0	В	1,440	16	20	1		FLOORBOX 2120		
		-	7=	17	0	С	1,440	18	20	1		FLOORBOX 2120		
FLOORBOX 2120		1	20	19	1,440	Α	1,440	20	20	1		FLOORBOX 2120		
FLOORBOX 2120		1	20	21	1,440	В	1,440	22	20	1		FLOORBOX 2120		
FLOORBOX 2120	•	1	20	23	1,440	С	0	24	-	-		SPACE		
SPACE		2-3	u.e.	25	0	Α	0	26	-	-		SPACE		
SPACE		-	155	27	0	В	0	28	-	-		SPACE		
SPACE			(H)	29	0	С	0	30	-	-		SPACE		
SPACE		-	-	31	0	Α	0	32	-	-		SPACE		
SPACE		-	/ in	33	0	В	0	34	-	-		SPACE		
SPACE		-	-	35	0	С	0	36	-			SPACE		
SPACE		12	72	37	0	Α	0	38	-	-		SPACE		
SPACE		-	-	39	0	В	0	40	18	-		SPACE		
SPACE			1151	41	0	С	0	42		150		SPACE		
NEL OPTIONS:			RE	CEP	T-VA@	per NEC	11,840	TO	TAL C	ALC	LOAD VA =	13,680		
			LIGH	ITS S	STD-VA@	100%		Г		ADJU	JSTED VA =	11,840		
			LIGH'	TS H	OSPVA@	per NEC			D	EMA	ND AMPS =	33		
			LIGH ¹	TS W	AREVA@	per NEC	-	AD	JUST	ED E	EXIST. KW =	0		
NEL NOTES:			M	OTOF	R-VA@	100%		LR	G MO	TOR	R LOAD VA =	0		
			KIT	CHE	N-VA@	100%	-			# O	F ELEV(S) =	0		
					-VA@	per NEC	-							
			HEA	TING	EQ-VA@	100%	-	# (OF KIT	CHE	EN EQUIP =	0		
					EQ-VA@	100%		S	UB-FE	ED	PANEL(S) =			
					OR-VA@	100%		25% GROWTH FACTOR				8		
			-		-VA @	100%	7=0	8	TOTAL	DF	SIGN AMPS	33		

PANELBOARD NAME	VO	LTA	GE		PHASE	WRE	BUS SIZ	ZE.	1	1	MAIN	AIC RATING		
2/H SECT 2 (DEMO)	100000	\$100 PM	/120		3	4	225	William I		-	MCB	10KA		
LOCATION			ROM			OCATION	# OF CK	TS			TAUC	NEMA ENCLOSURE		
RM 2134)P/2			RM '		42				RFACE	TYPE 1		
LOAD	CB ACCESS.			CKT#	VA	PHASE	VA	CKT#	BKR		CB ACCESS.	LOAD		
RECPTS 2130, 2132 ISO GR		1	20	1	0	Α	0	2	20	1		RECPTS 2135, 2133, ISO GR		
RECPTS 2130, 2100L		1	20	3	0	В	0	4	20	1		RECPTS 2100J, 2143		
RECPTS 2120 & SOUTH WALL		1	20	5	0	С	0	6	20	1		WATER COOLER 2100J		
RECPTS RM 2120A		1	20	7	0	Α	0	8	20	1		RECPTS 2131, 2133		
RECPTS 2120 ISO GR		1	20	9	0	В	0	10	20	1		RECPTS 2131,2133 ISO GR		
MOVIE SCREEN 2120		1	20	11	0	С	0	12	20	1		RECPTS 2133, 2135		
PROJECTOR 2120		1	20	13	0	Α	0	14	20	1		RECPTS 2136		
RECPTS 2120 NORTH WALL		1	20	15	0	В	0	16	20	1		RECPTS 2020D, 2202, ISO GR		
GFI RECPTS 2140, 2145		1	20	17	0	С	0	18	20	1		RECPTS 2020G, 2020F, ISO GR		
RECPTS UNDER COUNTER 2145		1	20	19	0	Α	0	20	20	1		RECPT 2132		
RECPTS UNDER COUNTER 2140		1	20	21	0	В	0	22	20	1		RECPT 2132		
SPARE		1	20	23	0	С	0	24	20	1		RECPT 2132		
LITES RM 2170		1	20	25	0	Α	0	26	20	1		RECPT 2120 EAST & 2020G		
LITES 2180		1	20	27	0	В	0	28	20	1		RECPTS 2020D		
LITES RM 2175 & 2185		1	20	29	0	С	0	30	20	1		RECPTS 2020F, 2020E		
LITES 2190		1	20	31	0	Α	0	32	20	1		RECPTS 2020M 2020B,C ISO GR		
LITES 2195		1	20	33	0	В	0	34	20	1		RECPTS 2020J,I,A FLOOR BOXES 2020A		
RELAY 2080		1	20	35	0	С	0	36	20	1		RECPTS 2020, 2020B,C		
RECPTS 2020E, 2200 ISO GR		1	20	37	0	Α	0	38	20	1		RECPTS 2120, 2020I, 2020H		
SPARE		1	20	39	0	В	0	40	20	1		RECPTS FLOOR 2020AISO GR		
SPARE		1	20	41	0	С	0	42	20	1		RECPTS 2020J, 2020I ISO GR		
PANEL OPTIONS:			RI	CEF	T-VA@	per NEC	-	TO	TAL (CAL	C LOAD VA =	0		
	1		LIGH	HTS S	STD-VA@	100%	-	П	Ĭ,	ADJ	USTED VA =	0		
	1		LIGH	TS H	OSPVA@	per NEC	-		D	EM	AND AMPS =	0		
			LIGH'	TS W	AREVA@	per NEC	-	AD	JUST	ED	EXIST. KW=	0		
PANEL NOTES:	1		M	ОТО	R-VA@	100%	-	LR	RG MC	TOF	R LOAD VA =	0		
SIEMENS PANELBOARD	1		KI.	TCHE	N-VA@	100%	-	1		# C	FELEV(S) =	0		
CAT # BG42MB4225SBM	1		>	(-RAY	′-VA@	per NEC	-	T						
	1		HEA	TING	EQ-VA@	100%	-	# (OF KI	ГСН	EN EQUIP =	0		
			COC	LING	EQ-VA@	100%		S	UB-F	ED	PANEL(S) =			
			ELE	VAT	OR-VA@	100%		25%	GRC	OWTH FACTOR		0		
			1	MISC.	-VA@	100%	-	1	TOTA	L DE	SIGN AMPS	0		

												<u>/1</u> \		_
PANELBOARD NAME	l VC	DLTA	(GE		PHASE	WRE	BUS SIZ	ΖE		١	MAIN		AIC RATING	_
2/H SECT 2 (NEW)		208	/120		3	4	225			١	MCB		14KA	_
LOCATION	FEE	DF	ROM		SOURCE	LOCATION	# OF CK	TS		M	TNUC		NEMA ENCLOSURE	
RM 2134		DP/2			RM ·	1134	42			SUI	RFACE		TYPE 1	_
LOAD	CB ACCESS	POLE	BKR	CKT#	VA	PHASE	VA	CKT#	BKR AMP	POLE	CB ACCESS.		LOAD	
		1	20	1	0	Α	0	2	20	1			RECPTS 2135, 2133, ISO GR	_
RECPTS 2127		1	20	3	1,080	В	1,260	4	20	1			RECPTS 2100J	
RECPTS 2120		1	20	5	1,260	С	1,260	6	20	1			RECPTS 2100J	Ξ
RECPTS RM 2120A		1	20	7	0	Α	2,160	8	20	1			RECPTS 2118L,M,K,J	_
RECPTS 2120		1	20	9	1,440	В	0	10	20	1				Τ
SCREEN 2120		1	20	11	900	С	0	12	20	1				_
PROJECTOR 2120		1	20	13	900	Α	0	14	20	1			RECPTS 2136	_
RECPTS 2120		1	20	15	1,260	В	0	16	20	1		R	RECPTS 2020D, 2202, ISO GR	_
RECPTS 2140,2145, 2142,2140A		1	20	17	1,440	С	1,260	18	20	1			RECPTS 2020J,K	_
		1	20	19	0	Α	1,800	20	20	1			RECPTS 2118	_
RECPTS 2100S		1	20	21	1,260	В	1,080	22	20	1			RECPTS 2118	-
SPARE		1	20	23	0	С	0	24	20	1			RECPT 2132	-
LITES RM 2170	2	1	20	25	0	Α	1,800	26	20	1			RECPTS 2020G,J,V	-
LITES 2180		1	20	27	0	В	1,620	28	20	1			RECPTS 2020R,P,N	-
LITES RM 2175 & 2185		1	20	29	0	С	900	30	20	1			RECPTS 2020M	-
LITES 2190		1	20	31	0	Α	1,260	32	20	1			RECPTS 2020	-
LITES 2195		1	20	33	0	В	900	34	20	1			RECPTS 2020S	-
RELAY 2080		1	20	35	0	C	1,620	36	20	1			RECPTS 2020A	-
RECPTS 2020E, 2200 ISO GR		1	20	37	0	A	0	38	20	1			RECPTS 2020E,V	-
SPARE	8	1	20	39	0	В	0	40	20	1			11201 10 20202,4	-
SPARE	+	1	20	41	0	C	0	42	20	1				-
PANEL OPTIONS:					PT-VA@	per NEC	18,230			AL (LOAD VA =		26,460	-
					STD-VA@	100%	-				USTED VA =		18,230	-
					OSPVA@		-				AND AMPS =		51	-
					AREVA@		-	AD	JUST	ED	EXIST. KW=		0	-
PANEL NOTES:					R-VA@	100%	-	LR	G MO	TOF	R LOAD VA =		0	-
					EN-VA@	100%	2				F ELEV(S) =		0	-
					/-VA@	per NEC	_						694	-
					EQ-VA@	100%	-	# (OF KIT	СН	EN EQUIP =		0	-
					GEQ-VA@	100%	-				PANEL(S) =		3,905.07	-
			-0		OR-VA@	100%	-				H FACTOR =		13	-
					VA @	100%	_				SIGN AMPS		51	_

PANELBOARD NAME	VOI				PHASE	WRE	BUS SIZ	Έ		257	MAIN	AIC RATING
2/4H (DEMO)			/277		3	4	100				ИСВ	10KA
LOCATION			ROM		SOURCE	OCATION	# OF CK	TS			TAUC	NEMA ENCLOSURE
RM 2134	D	P/4	Α				42				RFACE	TYPE 1
LOAD	CB ACCESS.	POLE	BKR	CKT#	VA	PHASE	VA	CKT#	BKR AMP	POLE	CB ACCESS.	LOAD
LITES 2100J, 2145, 2140, 2140A, 2134		1	20	1	0	Α	0	2	20	1		LITES 2190
SPARE	8	1	20	3	0	В	0	4	20	1		LITES 2185, 2195
LITES 2109, 2111, 2113, 2115, 2117, 2131,2133,2135		1	20	5	0	С	0	6	20	1		LITES 2190
LITES 2100N,2100M		1	20	7	0	Α	0	8	20	1		SPARE
LITES 2165, 2167, 2175		1	20	9	0	В	0	10	20	1		DOWN LITE ATRIUM SW ST #
LITES 2170		1	20	11	0	С	0	12	20	1		SPARE
LITES 2130, 2132, 2100K, 2000J, 2200K		1	20	13	0	Α	0	14	20	1		SPARE
SPARE		1	20	15	0	В	0	16	20	3		
SPARE		1	20	17	0	С	0	18	-	2		LCP4 RM 2120
SPARE		1	20	19	0	Α	0	20	2	2		
SPACE		-	-	21	0	В	0	22	-	3		SPACE
SPACE		-	-	23	0	С	0	24	-	3		SPACE
SPACE		-	878	25	0	Α	0	26	-	5		SPACE
SPACE		-	S(#)	27	0	В	0	28	-			SPACE
SPACE		-	2.00	29	0	С	0	30	-	*		SPACE
SPACE		-	-	31	0	Α	0	32	-	-		SPACE
SPACE		-	:×:	33	0	В	0	34	-	2		SPACE
SPACE	5	-	-	35	0	С	0	36	-	2		SPACE
SPACE	31	-	-	37	0	Α	0	38	3	3	i i	SPACE
SPACE		-	-	39	0	В	0	40	-	2		SPACE
SPACE		-	(G)	41	0	С	0	42	-			SPACE
PANEL OPTIONS:	1		RE	ECE	PT-VA@	per NEC		TO	TAL C	ALC	CLOAD VA =	0
			LIGH	HTS	STD-VA@	100%	181		Α	DJ	USTED VA =	0
					OSPVA@		* 2				ND AMPS =	0
······			LIGH	TS W	/AREVA@	per NEC	-	AD	JUSTE	EDI	EXIST. KW=	0
PANEL NOTES:	1		М	ОТО	R-VA@	100%	-	LR	G MO	TOF	R LOAD VA =	0
SIEMENS PANELBOARD			KI	TCHE	EN-VA@	100%	- 21			# O	F ELEV(S) =	0
CAT # H442MB4100SBM 2			X	(-RA	Y-VA@	per NEC	-					
}			HEA	TING	EQ-VA@	100%	-	# (OF KIT	СН	EN EQUIP =	0
					G EQ-VA@	100%	151				PANEL(S) =	
	I		ELE	EVAT	OR-VA@	100%		25%	GRO	WTI	+ FACTOR =	0
	1		N	MISC	VA @	100%	-		TOTAL	DE	SIGN AMPS	0

PANELBOARD NAME	l VC	LTA	GE		PHASE	WRE	BUS SI	ZE		N	MAN	AIC RATING
2/4H (NEW)		480	/277		3	4	100	2002000		١	ИCB	22KA
LOCATION	FEE	DF	ROM		SOURCE L	OCATION	# OF CK	TS		MC	DUNT	NEMA ENCLOSURE
RM2134)P/4	Α				42			SUF	RFACE	TYPE 1
LOAD	CB ACCESS.	POLE	BKR	CKT#	VA	PHASE	VA	CKT#	BKR	POLE	CB ACCESS.	LOAD
LITES 2100J,2140,2145,2142,2140A,2114,2100S		1	20	1	2,200	Α	0	2	20	1		LITES 2190
SPARE		1	20	3	0	В	0	4	20	1		LITES 2185, 2195
LITES 2118, A,B,C,J,K,L,M		1	20	5	2,200	С	0	6	20	1		LITES 2190
LITES 2100N,2100M		1	20	7	0	Α	0	8	20	1		SPARE
LITES 2165, 2167, 2175		1	20	9	0	В	0	10		1		DOWN LITE ATRIUM SW ST #5
LITES 2170		1	20	11	0	С	2,200	12		1		Lites 2020,A,B,G,J,K,M,N,P,R,S,F
LITES 2000J, 2200K,2100K,2127		1	20	13	2,200	Α	2,200	14	20	1	5	LITES 2120
SPARE		1	20	15	0	В	0	16		3		
SPARE		1	20	17	0	С	0	18	-	-		LCP-4 RM 2120
SPARE		1	20	19	0	Α	0	20	-	-	7-	
SPACE		-	12	21	0	В	0	22	-	-		SPACE
SPACE		-	12	23	0	С	0	24		-		SPACE
SPACE		10.7	1.5	25	0	Α	0	26	-			SPACE
SPACE		-	8.5	27	0	В	0	28	-			SPACE
SPACE		1 -		29	0	С	0	30	-	-		SPACE
SPACE		-	(+	31	0	Α	0	32	-	-		SPACE
SPACE		-		33	0	В	0	34	-	-		SPACE
SPACE		-	-	35	0	С	0	36	-	-		SPACE
SPACE		-	12	37	0	Α	0	38	-	-		SPACE
SPACE		-	-	39	0	В	0	40	-	-		SPACE
SPACE		-	-	41	0	С	0	42	-	-		SPACE
PANEL OPTIONS:			RE	CEF	T-VA@	per NEC	353	TC	TAL C	ALC	LOAD VA =	11,000
	1		LIGH	ITS S	STD-VA@	100%	11,000		-	ADJI	JSTED VA =	11,000
	1		LIGH	TS H	OSPVA@	per NEC			D	EMA	ND AMPS =	13
			LIGH'	TS W	AREVA@	per NEC	-	AD	JUST	ED E	EXIST. KW=	0
PANEL NOTES:	7		M	ОТО	R-VA@	100%	541	LF	RG MO	TOF	R LOAD VA =	0
	1		KI	CHE	N-VA@	100%	-			# O	FELEV(S) =	0
	1				'-VA@	per NEC	-	1				
	1				EQ-VA@	100%	-	#	OF KIT	СН	EN EQUIP =	0
	1				EQ-VA@	100%		S	UB-FE	ED	PANEL(S) =	
	1				OR-VA@	100%	170				FACTOR =	3
	1				-VA@	100%	(#);	TOTAL DESIGN AMPS				13



222 West Washington Ave. Suite 310 Madison, WI 53703 ph: 608.268.1499 www.destreearchitects.com DESTREE DESIGN ARCHITECTS HOLDS ALL RIGHTS INCLUDING THE COPYRIGHT OF THIS DOCUMENT, AS WELL AS THE CONCEPTS AND DESIGNS INCORPORATED HEREIN AS AN INSTRUMENT OF SERVICE AS PROPERTY OF DESTREE DESIGN ARCHITECTS IT IS NOT TO BE COPIED, DISTRIBUTED, OR USED IN WHOLE OR PART WITHOUT THE EXPRESS WRITTEN CONSENT OF DESTREE DESIGN ARCHITECTS.

Madison:
1241 John Q Hammons Dr, Suite 503
Madison, Wisconsin 53717
T 608.833.7000
Email: info@henneman.com
Website: http://www.henneman.com JOB NO. 22-10300C

MADISON WISCONSIN **OF** #6101 UNIVERSITY (
21 N PARK STREET SUITE
MADISON, WI 53715

RAINGER HALL 2ND & 5TH FLOOR RENOVATION
HASE 3 - 2ND FLOOR NW RENOVATION
NERSITY OF WISCONSIN - MADISON
UNIVERSITY AVENUE
DISON, WI 53706

(975 MAE	Shee									
Revis	ions:		l										
No.	Date	:	Description	:									
\triangle	03/12	2/24	ADDENDUM 2										
Graph Scale	nic	NT	TS										
PRJ. Numb	er		/: MSN 0140-2303 /SA: A-22-021										
Set Type		BD											

Sheet Number E500