

1 ADDENDUM NO. 1

2 ISSUE DATE: **August 5, 2025**

3
4 RE: **GRAINGER HALL DINING EXPANSION AND RENOVATION**
5 **UNIVERSITIES OF WISCONSIN - MADISON**
6 **MADISON, WISCONSIN**
7 **UW-Madison Project No. 9950-2307 / UWSA Project No. A-24-004**
8

9 BID OPENING: **MEP Bid – 2:00 P.M., August 19, 2025.**
10 **GPC Bid – 2:00 P.M., September 4, 2025.**
11

12 FROM: **Workshop Architects**
13 **201 E. Pittsburgh Ave. Suite 301**
14 **Milwaukee WI 53204**
15

16 TO: Prospective Bidders
17

18 This addendum forms a part of the Contract Documents and modifies the original Contract Documents
19 dated **June 20, 2025**, as noted below. Acknowledge receipt of this Addendum by inserting the number and
20 issue date of this addendum in the blank space provided on the Bid Form. Failure to do so may subject the
21 Bidder to disqualification.
22

23 This Addendum consists of 51 **pages**.
24
25

26 **ANSWERS TO SUBMITTED QUESTIONS:**
27

28 QUESTION: On sheet S101 the notes call out for the permanent ers [earth retention system] that we are to
29 take into account the adjacent foundation loading. Can the structural engineer provide the loading of the
30 existing foundations on the S101 plan page that are to be taken into account when designing the permanent
31 eras [earth retention system]?
32

33 RESPONSE: Refer to existing structural drawings for assumed soil bearing pressures and footing
34 geometry/elevations.
35

36 Structural drawings reference 01/05/2009 RECORD DRAWINGS – **(01-05-2009 RECORD DRAWINGS**
37 **Grainger Hall structural drawings.pdf)** and 11/3/93 AS-BUILT DRAWINGS – **(11-3-93 AS-BUILT**
38 **drawings Grainger Hall structural drawings.pdf)** for existing structural drawings.
39

40 EXISTING STRUCTURAL DRAWINGS FOR REFERENCE ONLY CAN ACCESSED TROUGH BOX
41 FOLDER LOCATED AT: <https://app.box.com/s/493q0hyc1y2pj0f9k4eh60uveencdgm>

42 The existing drawings are being provided for bidding purposes only. Layouts and other information on
43 these drawings have not been confirmed with actual conditions. The existing conditions will need to be
44 field verified by the contractor. Existing drawings provided are scans of the original. Do not scale from
45 drawings. Refer to project general requirements, drawings, and specifications for additional information.
46
47

48 CONTRACTOR QUESTION: [Sheet S101 - Sheet Notes] Note 8 e. calls out the max thickness of the ers
49 [earth retention system] perpendicular to the plane shall be 16".

- 50 a. With the requirements provided of the vertical loading, that the ers [earth retention system] must
51 be a cantilevered system, that the deflection is 1/4" or less an ers [earth retention system] system
52 with 16" max thickness is not feasible.
53

1 RESPONSE: The term cantilevered has been removed from the temporary earth retention system
2 (ERS) description, as the design team is not requiring a cantilevered earth retention system (ERS)
3 system, though a cantilevered system would be acceptable. The intent was to clarify that tiebacks or
4 additional structural beyond the earth retention system (ERS) would not be acceptable.
5 i. In the temporary condition, there is no objection to providing temporary bracing
6 (means/methods designed/provided by the contractor).
7 ii. In the final condition the earth retention system (ERS) noted on S101 may be considered
8 braced by the reinforced concrete (RC) cap beam and adjacent Level 1 slab
9

10 CONTRACTOR QUESTION:

11 b. [Sheet S101 - Sheet Notes 8 – Note E] Can this 16” requirement be relaxed if the other
12 requirements need to be accounted for?
13

14 RESPONSE: Sheet notes on sheet S101 have been updated to allow for maximum 3/8” allowable
15 lateral deflection. Bidders should maintain the maximum 16” thickness.
16

17
18 CONTRACTOR QUESTION:

19 c. Or can the structural engineer design a retaining wall as the permanent structure and the ers
20 [earth retention system] be for the temporary situation?
21

22 RESPONSE: The earth retention system (ERS) design to be maintained per bid documents.
23
24

25 QUESTION: For the internal face of the mechanical room (concrete) that will be attached to the permanent
26 ers [earth retention system], please confirm what the loading imparted onto the ers [earth retention system]
27 will be?
28

29 RESPONSE: 6" reinforced concrete (RC) wall at interior of north/south/east earth retention system (ERS)
30 wall as noted on 2/S101 and 2/S330 is non-load bearing and is supported vertically by the mechanical room
31 slab-on-grade. At a minimum, 6” RC wall to be laterally braced at t/wall.
32
33

34 QUESTION: Specifications state that the AV devices and accessories shall be provided and installed by the
35 Owner. Please clarify the contractor’s scope for the AV system.
36

37 RESPONSE: Contractor scope includes all conduits, raceways, boxes, and receptacles for the AV
38 equipment. AV equipment and cabling for AV equipment will be owner furnished, and owner installed by
39 owner’s vendor.
40
41

42 SUBSTITUTIONS:

43 Substitutions are not reviewed during bidding but after contracts are awarded and through the construction
44 period. Submit a Substitution Request as part of the submittal review process at which time the design
45 team and owner will review your request and either accept or reject the request.
46
47

48 CHANGES TO THE DRAWINGS:
49

50 C050 - TRAFFIC CONTROL PLAN





51 The construction staging area on Brooks Street shall be reduced by half. New Staging area, E/W
52 boundary, to be from eastern curb to the centerline of Brooks Street. The N/S boundary stays the
53 same.
54

55 S101 – LEVEL 1 FRAMING PLAN


1 Revision to plan note 8
 2
 3 A401 - ENLARGED PLANS, SECTIONS & DETAILS – PLENARY
 4 Ramp length increased to 20'-0"
 5 Stair to raised platform adjusted to include clear 4'-0" by 4'-0" landings.
 6
 7 A405 - ENLARGED SHAFT PLANS & SECTIONS
 8 Detail 5/A405 - Remove reference to 2-hour firewrap above level 4. There will be no firewrap at
 9 this location. Add fire/smoke dampers at floor penetrations on level 2, level 4 and level 5. See
 10 mechanical references in the addendum.
 11
 12
 13 M201B – FIRST FLOOR DUCTWORK PLAN – AREA B
 14 a. Added fire/smoke damper.
 15 b. Revised sheet keynote 4 to reflect smoke detector requirement.
 16 M201C – FIRST FLOOR DUCTWORK PLAN – AREA C
 17 a. Added fire/smoke damper.
 18 b. Revised pull station location.
 19 c. Revised notes 3, 4, & 5 to reflect insulation changes.
 20 M204B – FOURTH FLOOR DUCTWORK PLAN – AREA B
 21 a. Added fire/smoke damper.
 22 M205B – FIFTH FLOOR DUCTWORK PLAN – AREA B
 23 a. Added fire/smoke damper.
 24 b. Revised sheet keynote 1 to reflect VFD criteria.
 25 M501 – EXHAUST AIR FLOW RISER DIAGRAM
 26 a. Added fire/smoke dampers.
 27 M604 – MECHANICAL DETAILS
 28 a. Added fire/smoke damper details.
 29 M700 – MECHANICAL SCHEDULES
 30 a. Revised horsepower on EF-17.
 31 b. Updated VFD schedule to reflect EF-17 change.
 32 c. Revised minimum cfm for exhaust fans.
 33 M701 – MECHANICAL SCHEDULES
 34 a. Added fire/smoke damper schedule.
 35 M702 – MECHANICAL SCHEDULES
 36 a. Revised Electrical Equipment Schedule for EF-17 change.
 37
 38 E001 – ELECTRICAL ABBREVIATIONS, CODES AND DESIGNATIONS
 39 a. Updated Sheet List
 40
 41 E216B – SIXTH FLOOR POWER PLAN – AREA B
 42 b. Updated Sheet List
 43
 44 E231B – FIRST FLOOR FIRE ALARM PLAN – AREA B
 45 a. Add a duct smoke detector.
 46
 47 E234B – FOURTH FLOOR FIRE ALARM PLAN – AREA B
 48 a. Add a duct smoke detector.
 49
 50 E235B – FIFTH FLOOR FIRE ALARM PLAN – AREA B
 51 b. Add a duct smoke detector.
 52
 53 E600 – ELECTRICAL SCHEDULES
 54 c. Add, removed and edited Types.
 55

1 E610 – ELECTRICAL SCHEDULES
 2 a. Updated schedules.
 3 b. Added keyed note.
 4
 5 E614 – ELECTRICAL SCHEDULES
 6 a. Updated schedules.
 7
 8
 9
 10 CHANGES TO THE SPECIFICATION VOLUME 1 GPC and VOLUME 1 MEP
 11 GPC (General Prime Contractor) BID DOCUMENTS
 12 MEP (Mechanical, Electrical, Plumbing, and Fire Protection) BID DOCUMENTS
 13
 14 GPC INVITATION TO BID
 15 Page A-1 - Line 11 Change to bid opening “BID OPENING for GENERAL PRIME
 16 CONTRACTOR BIDDERS: 2:00 P.M., **September 4, 2025.**”
 17
 18 BID FORM – GENERAL PRIME CONTRACTOR (GPC)
 19 Page C-1 - Line 11 Change to “General Prime Contractor (GPC) Bid Opening: 2:00 P.M.,
 20 **September 4, 2025.**”
 21
 22 MEP INVITATION TO BID
 23 Page A-1 - Line 11 Change to bid opening “BID OPENING for GENERAL PRIME
 24 CONTRACTOR BIDDERS: 2:00 P.M., **September 4, 2025.**”
 25
 26 CHANGES TO THE TECHNICAL SPECIFICATIONS BID DOCUMENTS
 27 (DIVISIONS 2 THRU 33):
 28
 29 Division 07 – THERMAL AND MOISTURE PROTECTION
 30 07 21 00 - THERMAL INSULATION
 31 Under FOAM PLASTIC BOARD INSULATION MATERIALS, for Polyisocyanurate Board,
 32 Glass-Fiber-Mat Faced material - Atlas Energy Shield Rboard has been renamed by the
 33 manufacture to Energy Shield CGF or CGF Pro
 34
 35 Division 23 – HEATING VENTILATING AND AIR CONDITIONING
 36 23 07 00 HVAC Insulation
 37 a. Updated insulation for condensate ductwork and plenum slot diffusers.
 38 23 33 00
 39 a. Added fire/smoke dampers.
 40
 41 Division 32 – EXTERIOR IMPROVEMENTS
 42 32 36 00 - EXTERIOR SITE FURNISHINGS AND SPECIALTY ITEMS
 43 Add StormTank Urban Roots System under other possible manufacturers, as an approved product
 44 and manufacturer for the MODULAR SOIL VAULT.
 45
 46
 47 ATTACHMENTS:
 48
 49 S101 – LEVEL 1 FRAMING PLAN
 50 A401 - ENLARGED PLANS, SECTIONS & DETAILS – PLENARY
 51 M201B - FIRST FLOOR DUCTWORK PLAN - AREA B
 52 M201C - FIRST FLOOR DUCTWORK PLAN - AREA C
 53 M204B - FOURTH FLOOR DUCTWORK PLAN - AREA B
 54 M205B - FIFTH FLOOR DUCTWORK PLAN - AREA B

1 M501 - EXHAUST AIR RISER DIAGRAM
2 M604 - MECHANICAL DETAILS
3 M700 - MECHANICAL SCHEDULES
4 M701 - MECHANICAL SCHEDULES
5 M702 - MECHANICAL SCHEDULES
6 E000 - ELECTRICAL SYMBOLS AND SHEET INDEX
7 E216B - SIXTH FLOOR POWER PLAN - AREA B
8 E231B - FIRST FLOOR FIRE ALARM PLAN - AREA B
9 E234B - FOURTH FLOOR FIRE ALARM PLAN - AREA B
10 E235B - FIFTH FLOOR FIRE ALARM PLAN - AREA B
11 E610 - ELECTRICAL SCHEDULES
12 E614 - ELECTRICAL SCHEDULES
13 GPC INVITATION TO BID – Page A-1
14 BID FORM – GENERAL PRIME CONTRACTOR (GPC) – Page C-1
15 MEP INVITATION TO BID – Page A-1
16 23 07 00 HVAC INSULATION
17 23 33 00 AIR DUCT ACCESSORIES
18
19
20
21 END OF ADDENDUM
22
23
24 The Board of Regents of The Universities of Wisconsin System
25 C/O UWSA - Capital Planning and Budget,
26 780 Regent Street, Suite 239
27 Madison, Wisconsin 53715

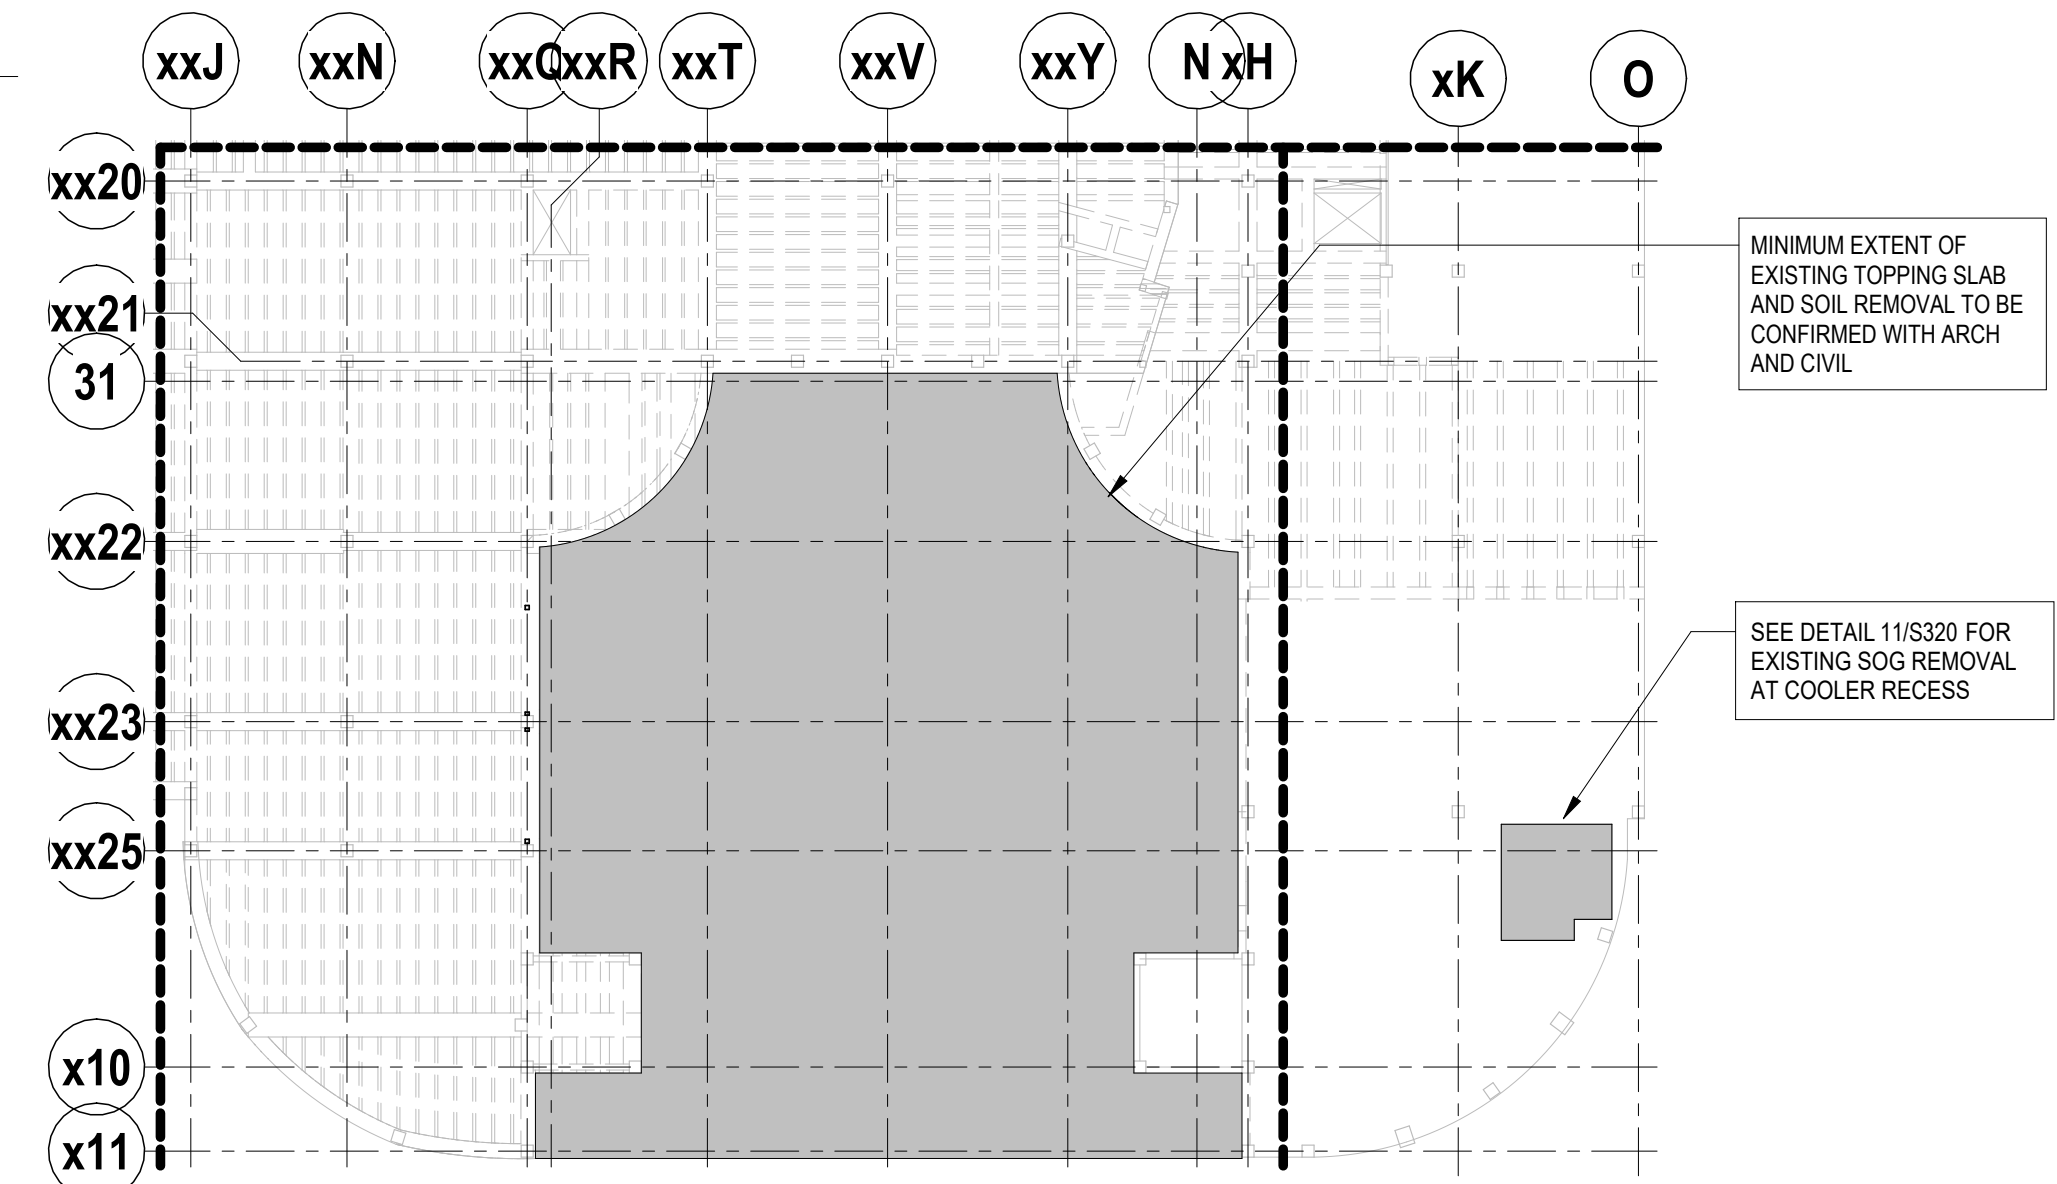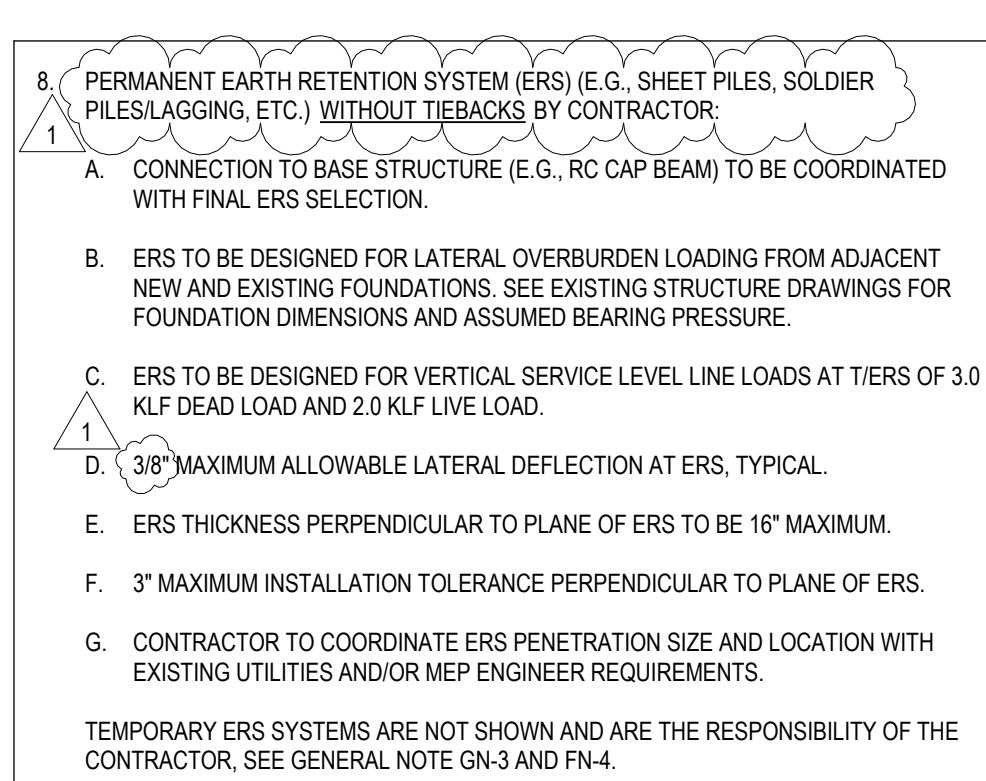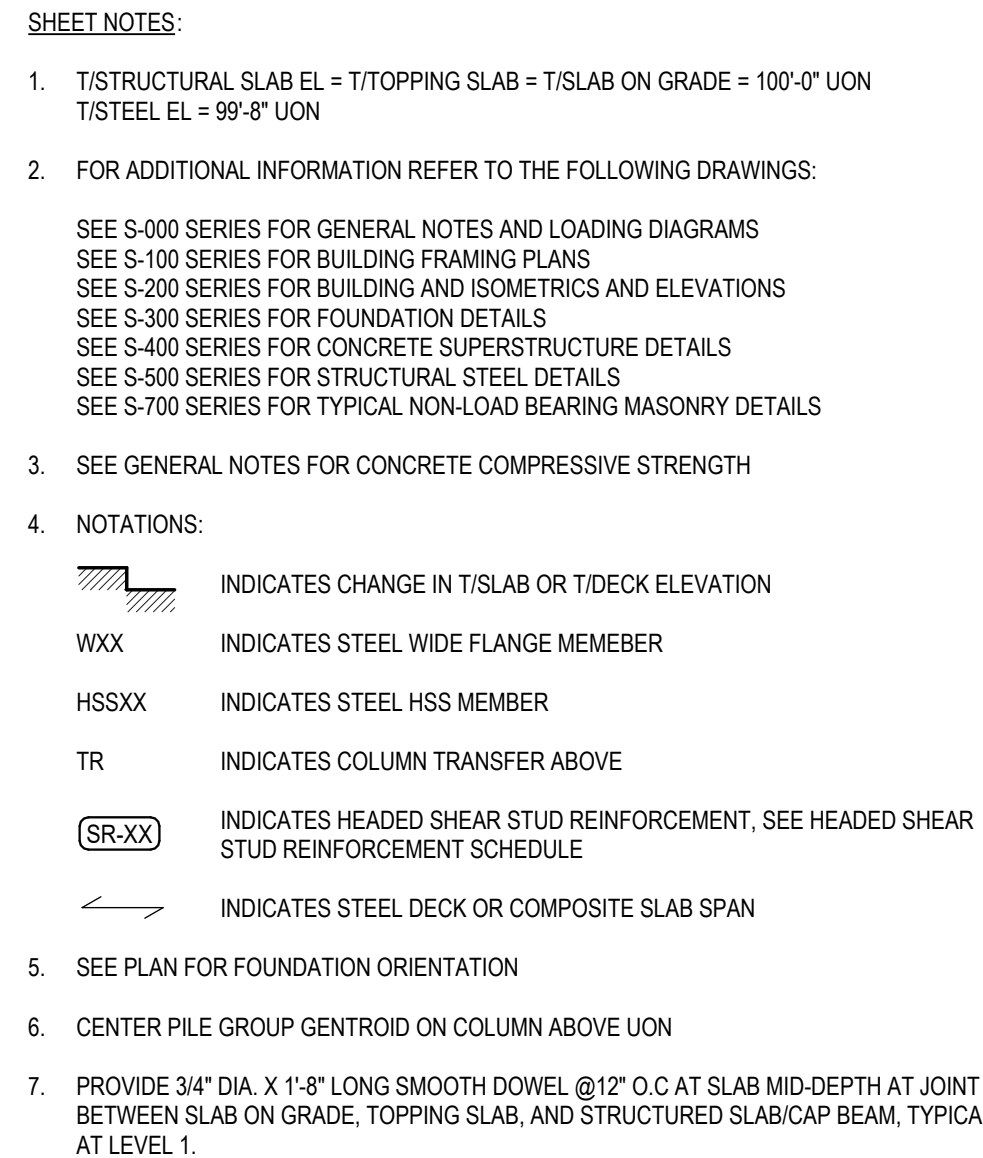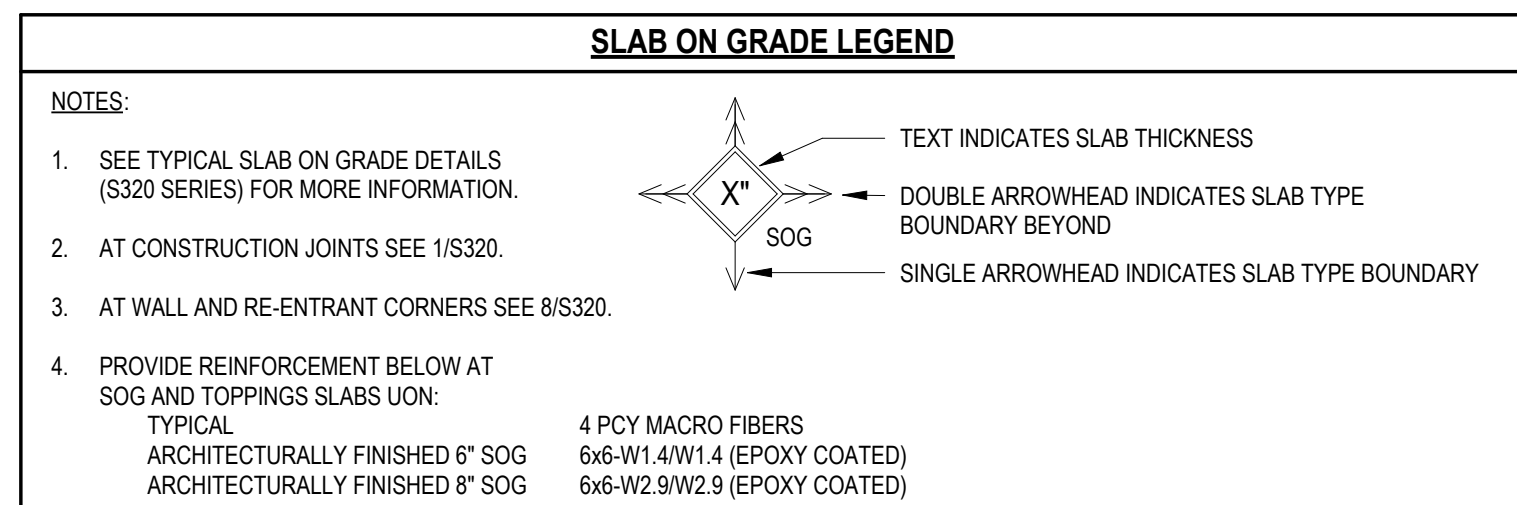

3 LEVEL 1 KEY PLAN
SCALE: 1/32" = 1'-0"

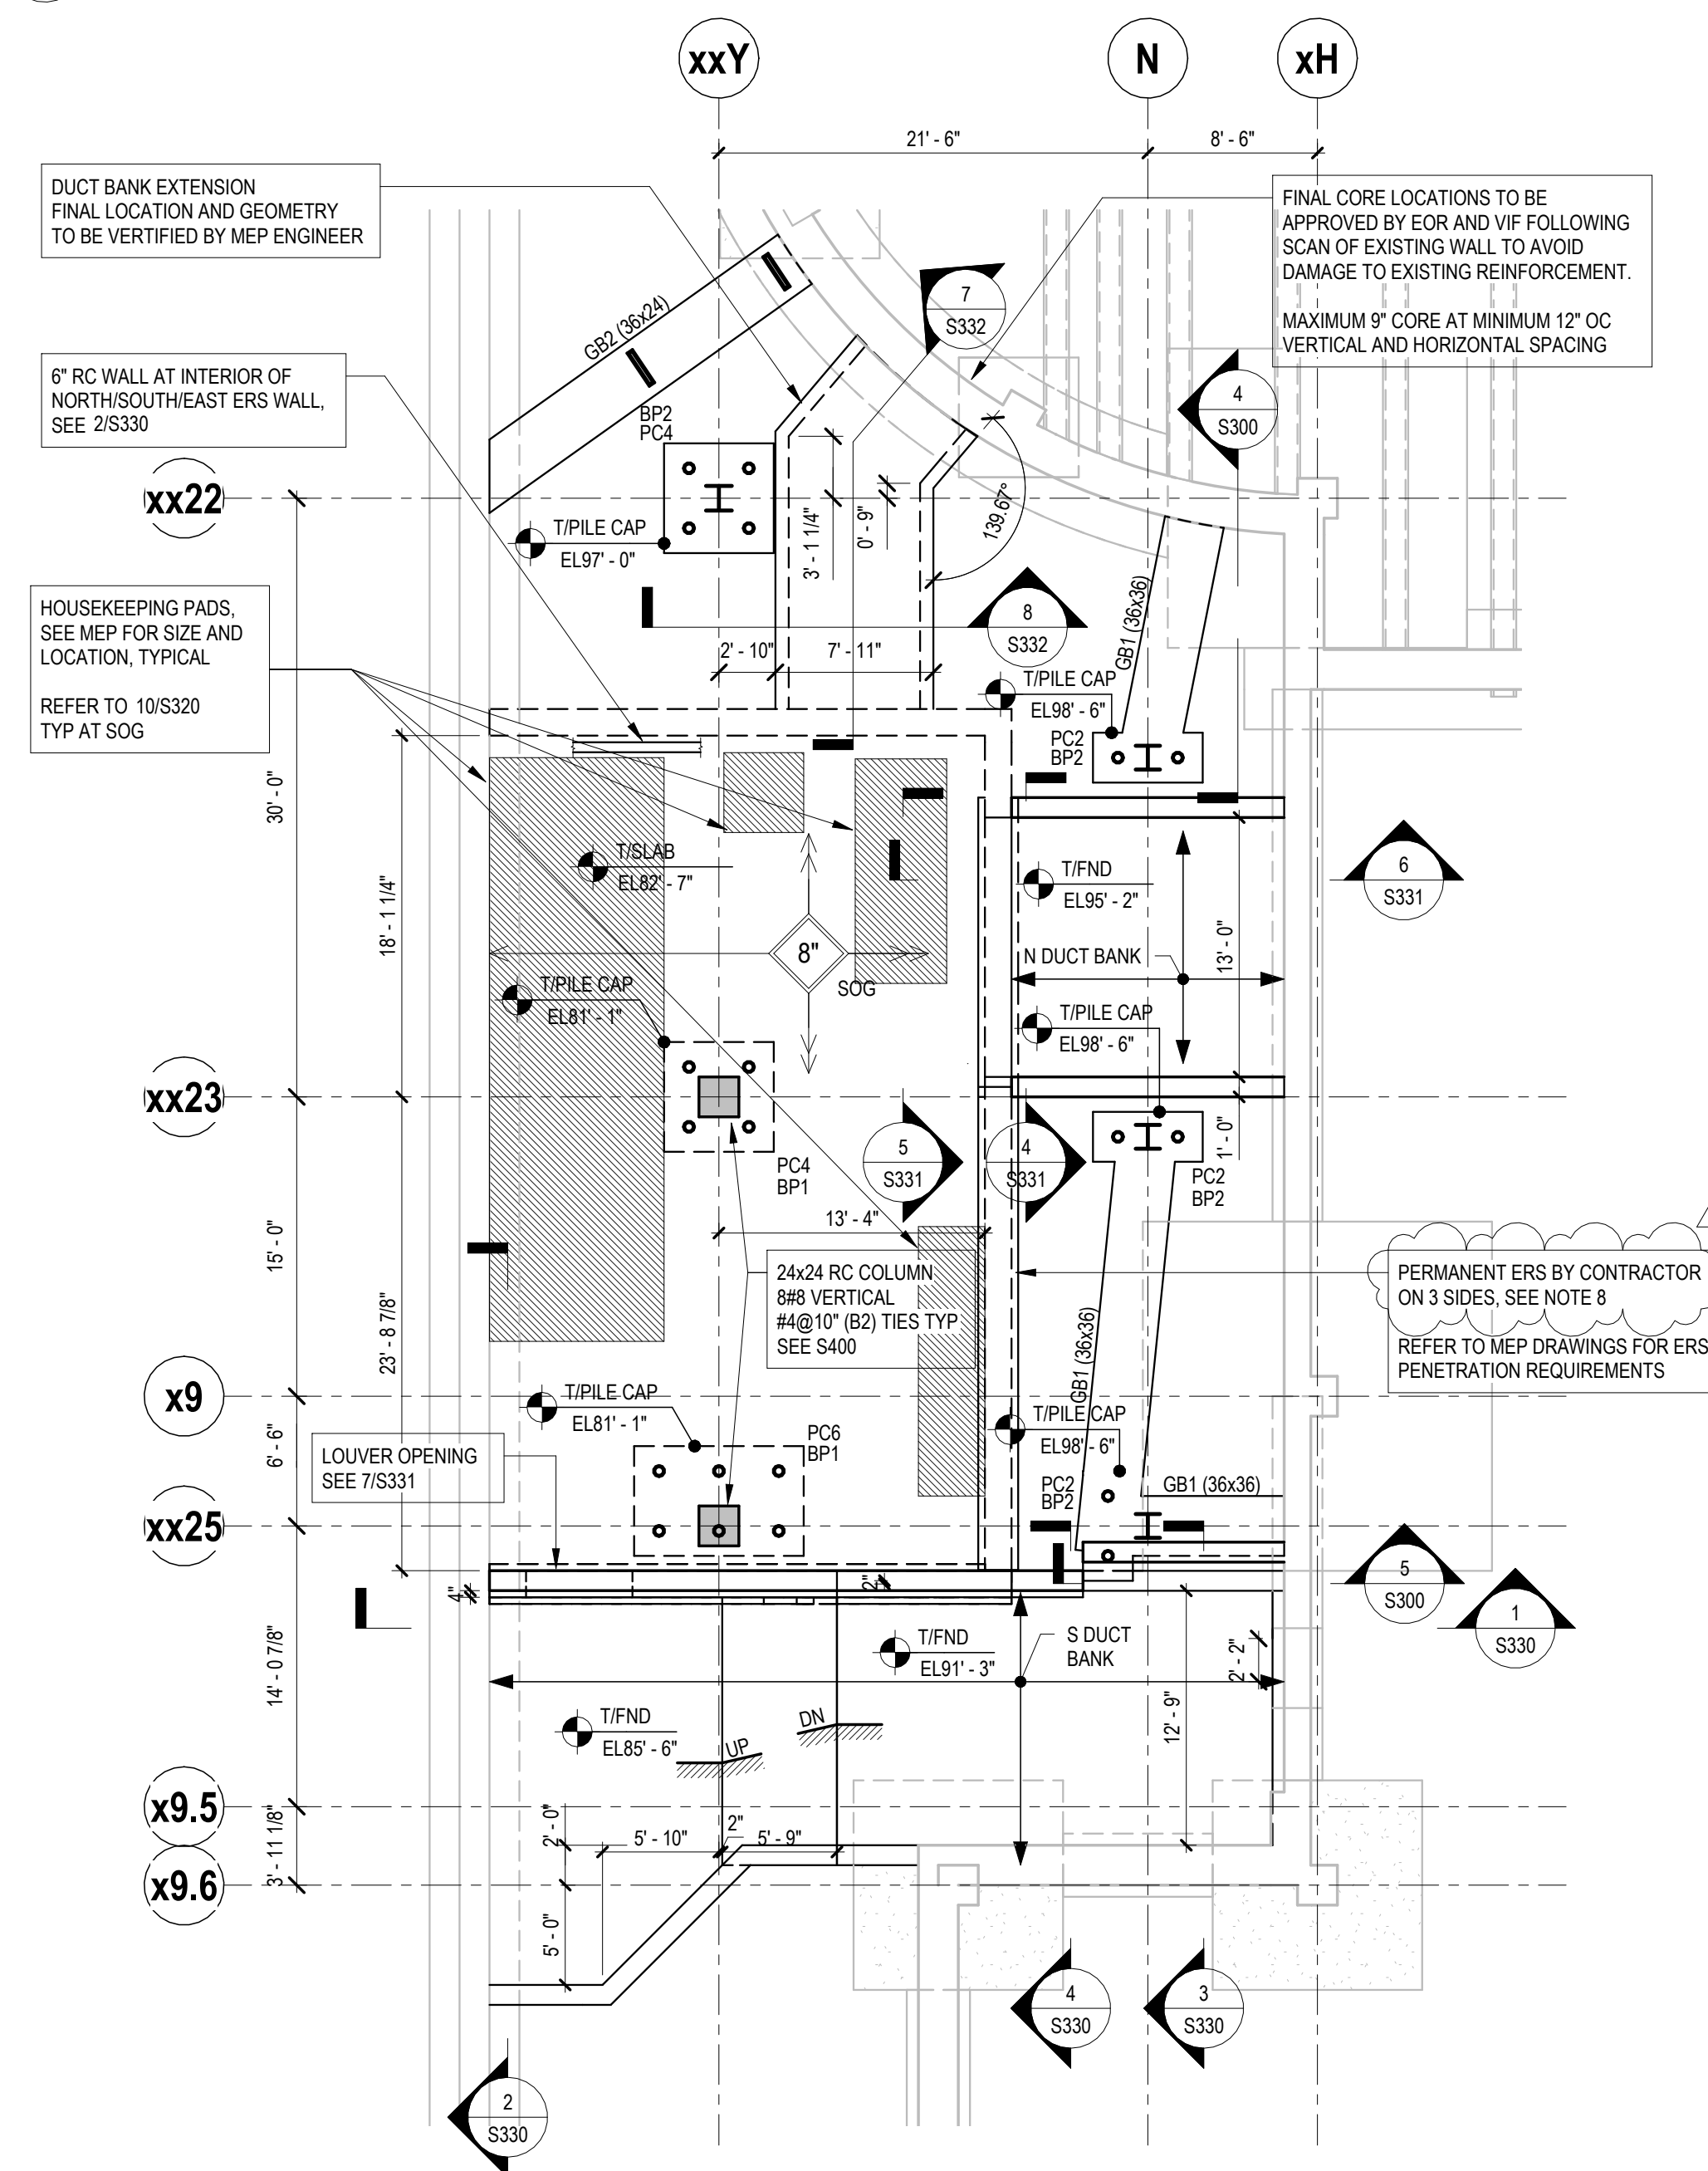

BASEMENT PARKING LEVEL-1 AND FOUNDATION PARTIAL PLAN
SCALE: 1/8" = 1'-0"

Board of Regents of the
University of Wisconsin




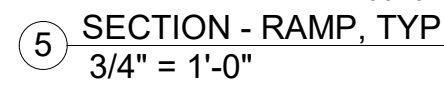
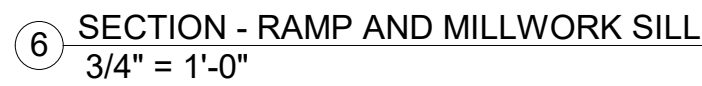
975 UNIVERSITY AVE
MADISON, WISCONSIN 53706

GRAINGER HALL DINING EXPANSION AND RENOVATION

Sheet Title
ENLA
PI EN


[illegible]

Graphic Scale	 AS INDICATED
UWUSA Number	A-24-004
Volume Number	1
MSN Number	9950-2307
Issued For	BID DOCUMENTS
Date Issued	06/20/2025
Sheet Number	A401




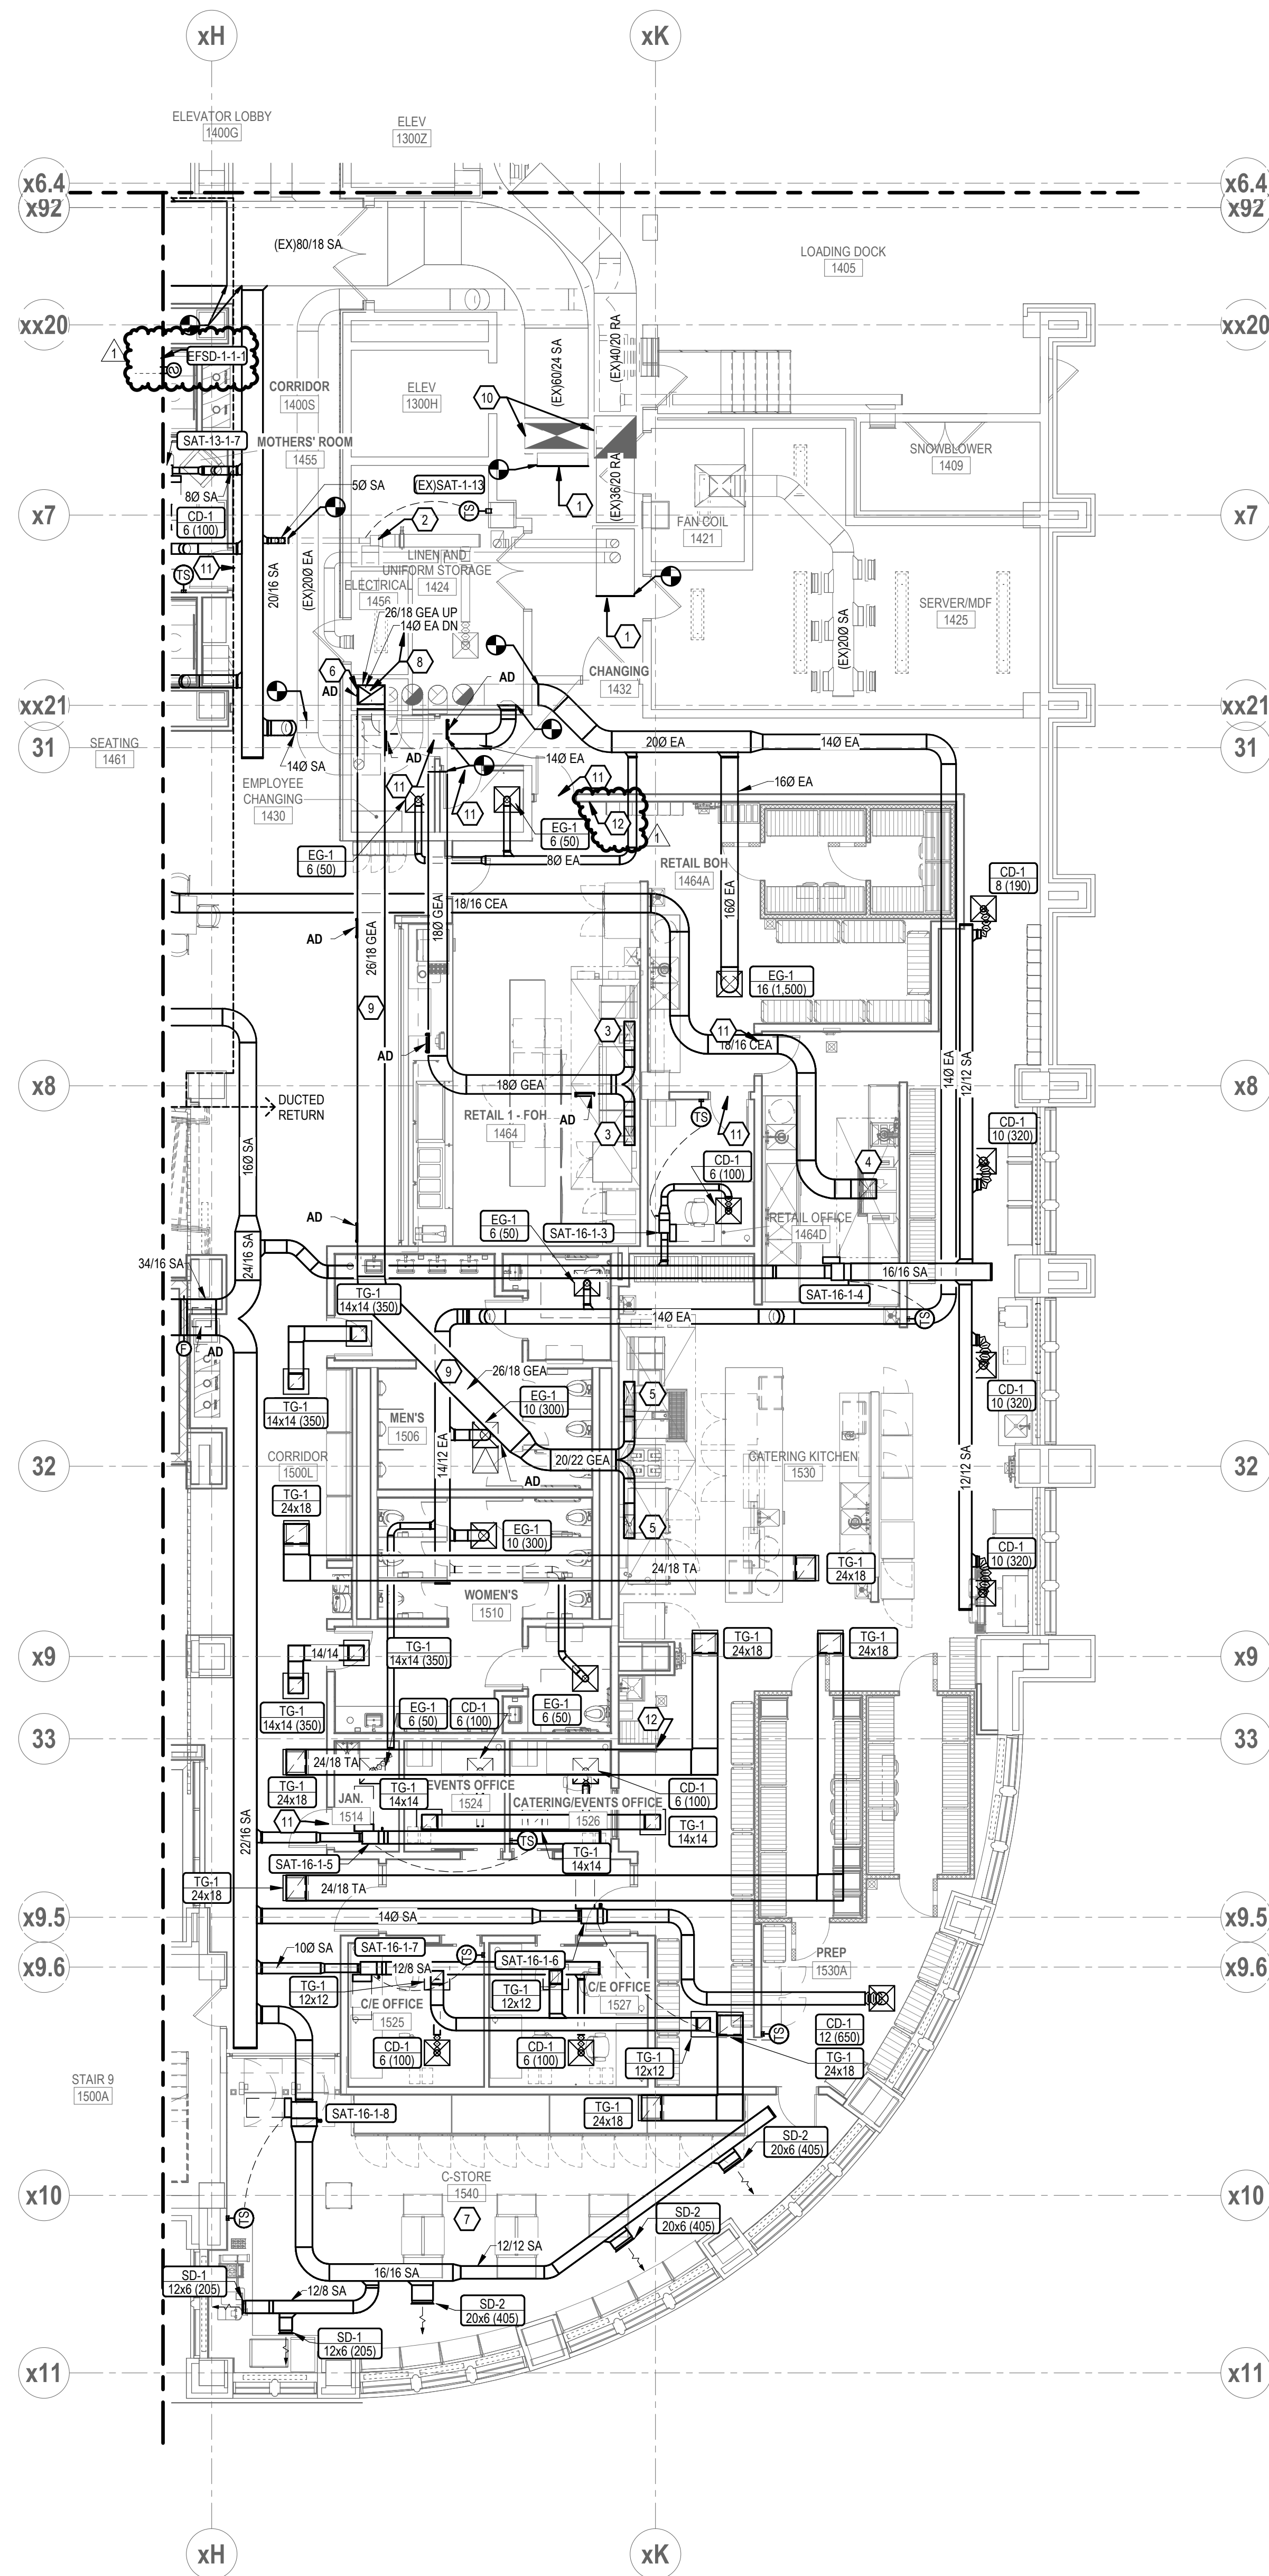
KEYED NOTES

1. PROVIDE AND INSTALL UPDATE TEMPERATURE SENSOR AND CONTROLS FOR EXISTING VAV BOX. INCLUDING NEW CONTROLS WIRING, REBALANCE AIRFLOW TO AIR TERMINAL AS REQUIRED. PLEASE REFER TO AIR TERMINAL SCHEDULE FOR MORE INFORMATION.
2. THIS STOP SERVES FIRST FLOOR (AREA B) AND SECOND FLOOR WINTER GARDEN.
3. GARAGE EXHAUST AND RELIEF AIR DISCHARGE AREA WELL. SEE DETAIL 1001.
4. INSTALL SMOKE DETECTOR AT THE TOP POSITION OF THE TYPICAL GARAGE EXHAUST. PROVIDE SMOKE DETECTOR WITH A BATTERY BACKUP THAT IS INACTIVE.
5. SPACE IS UTILIZING UNDERCUT DOOR FOR MEANS TO TRANSFER AIR. SEE ARCHITECTURAL DRAWINGS FOR UNDERCUT DOOR INFORMATION.

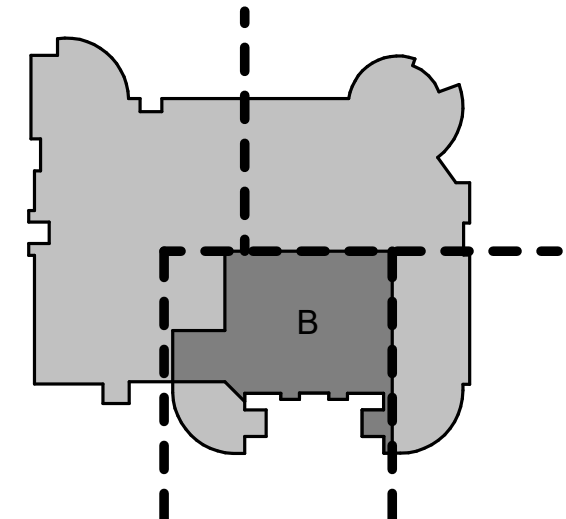


1

Graphic Scale	
UWSA Number	A-24-004
Volume Number	2
MSN Number	9950-2307
Issued For	BID DOCUMENTS
Date Issued	06/20/2025
Sheet Number	M201B



- ## SHEET NOTES
- A. ALL BRANCH DUCT SIZES ARE SIZED FOR THE AIR TERMINAL UNIT OR GRILL NECK CONNECTOR UNLESS NOTED OTHERWISE.
- B. PROVIDE MANUAL BALANCING DAMPERS IN ALL BRANCH DUCTS FOR MEANS OF BALANCING, WHETHER SHOWN ON THE PLANS OR NOT.
- C. RESIZE ALL EXISTING AIR TERMINALS, DIFFUSERS, REGISTERS AND GRILLES, WITHIN PROJECT SCOPE.
- ## KEYED NOTES
1. CAP EXISTING DUCTWORK AND PROVIDE INSULATION, END CAP AND INSULATION TO MATCH EXISTING CONDITIONS.
2. PROVIDE AND INSTALL UPDATED TEMPERATURE SENSOR AND CONTROLS FOR EXISTING BOIL, INCLUDING NEW CONTROLS WIRING, RESISTANCE AIRFLOW TO AIR TERMINAL AS NEEDED. PLEASE REFER TO AIR TERMINAL DATA SHEET FOR FURTHER INFORMATION.
3. SEE DETAIL #09020 FOR CONNECTION DETAIL.
4. SEE DETAIL #09022 FOR CONNECTION DETAIL.
5. SEE DETAIL #09022 FOR CONNECTION DETAIL. PROVIDE 2 HOUR FIRE WRAP FROM HOOD CONNECTION TO BUILDING ROOF PENETRATION.
6. PROVIDE HOOD CONNECTION TO BUILDING ROOF PENETRATION.
7. PROVIDE EXHAUST DUCTWORK.
8. NO CEILING IN THE SPACE. BLACK GRID ONLY. ALL MECHANICAL UTILITIES IN THIS SPACE TO BE PAINTED BLACK.
9. 14" DIA. GENERAL EXHAUST DUCT DOWN TO FLOOR BELOW. THIS INCLUDES FIRESMOKE DAMPER AND ACCESS DOOR AT SHAFT PENETRATIONS (WALL AND FLOOR). SEE DRAWING M001 FOR MORE INFORMATION.
10. GREASE EXHAUST DUCTWORK TO SLOPE BACK TO HOOD AT AN 8.3 PERCENT SLOPE (ONE INCH VERTICAL IN 12 UNITS HORIZONTAL).
11. CONSTRUCTION SHUTDOWN WILL REQUIRE COORDINATION FIRESMOKE DAMPER DAMPERS IN VERTICAL POSITION CLOSERS WITH OWNERS REP AND GENERAL CONTRACTOR.
12. SPACE IS UTILIZING UNDERDOOR DOOR FOR MEANS TO TRANSFER AIR. SEE DETAIL #09020 FOR CONNECTION DETAIL.
13. LOCATION FOR MANUAL PULL STATION FOR TYPE I HOOD. SEE KITCHEN DINGS FOR MORE INFORMATION.

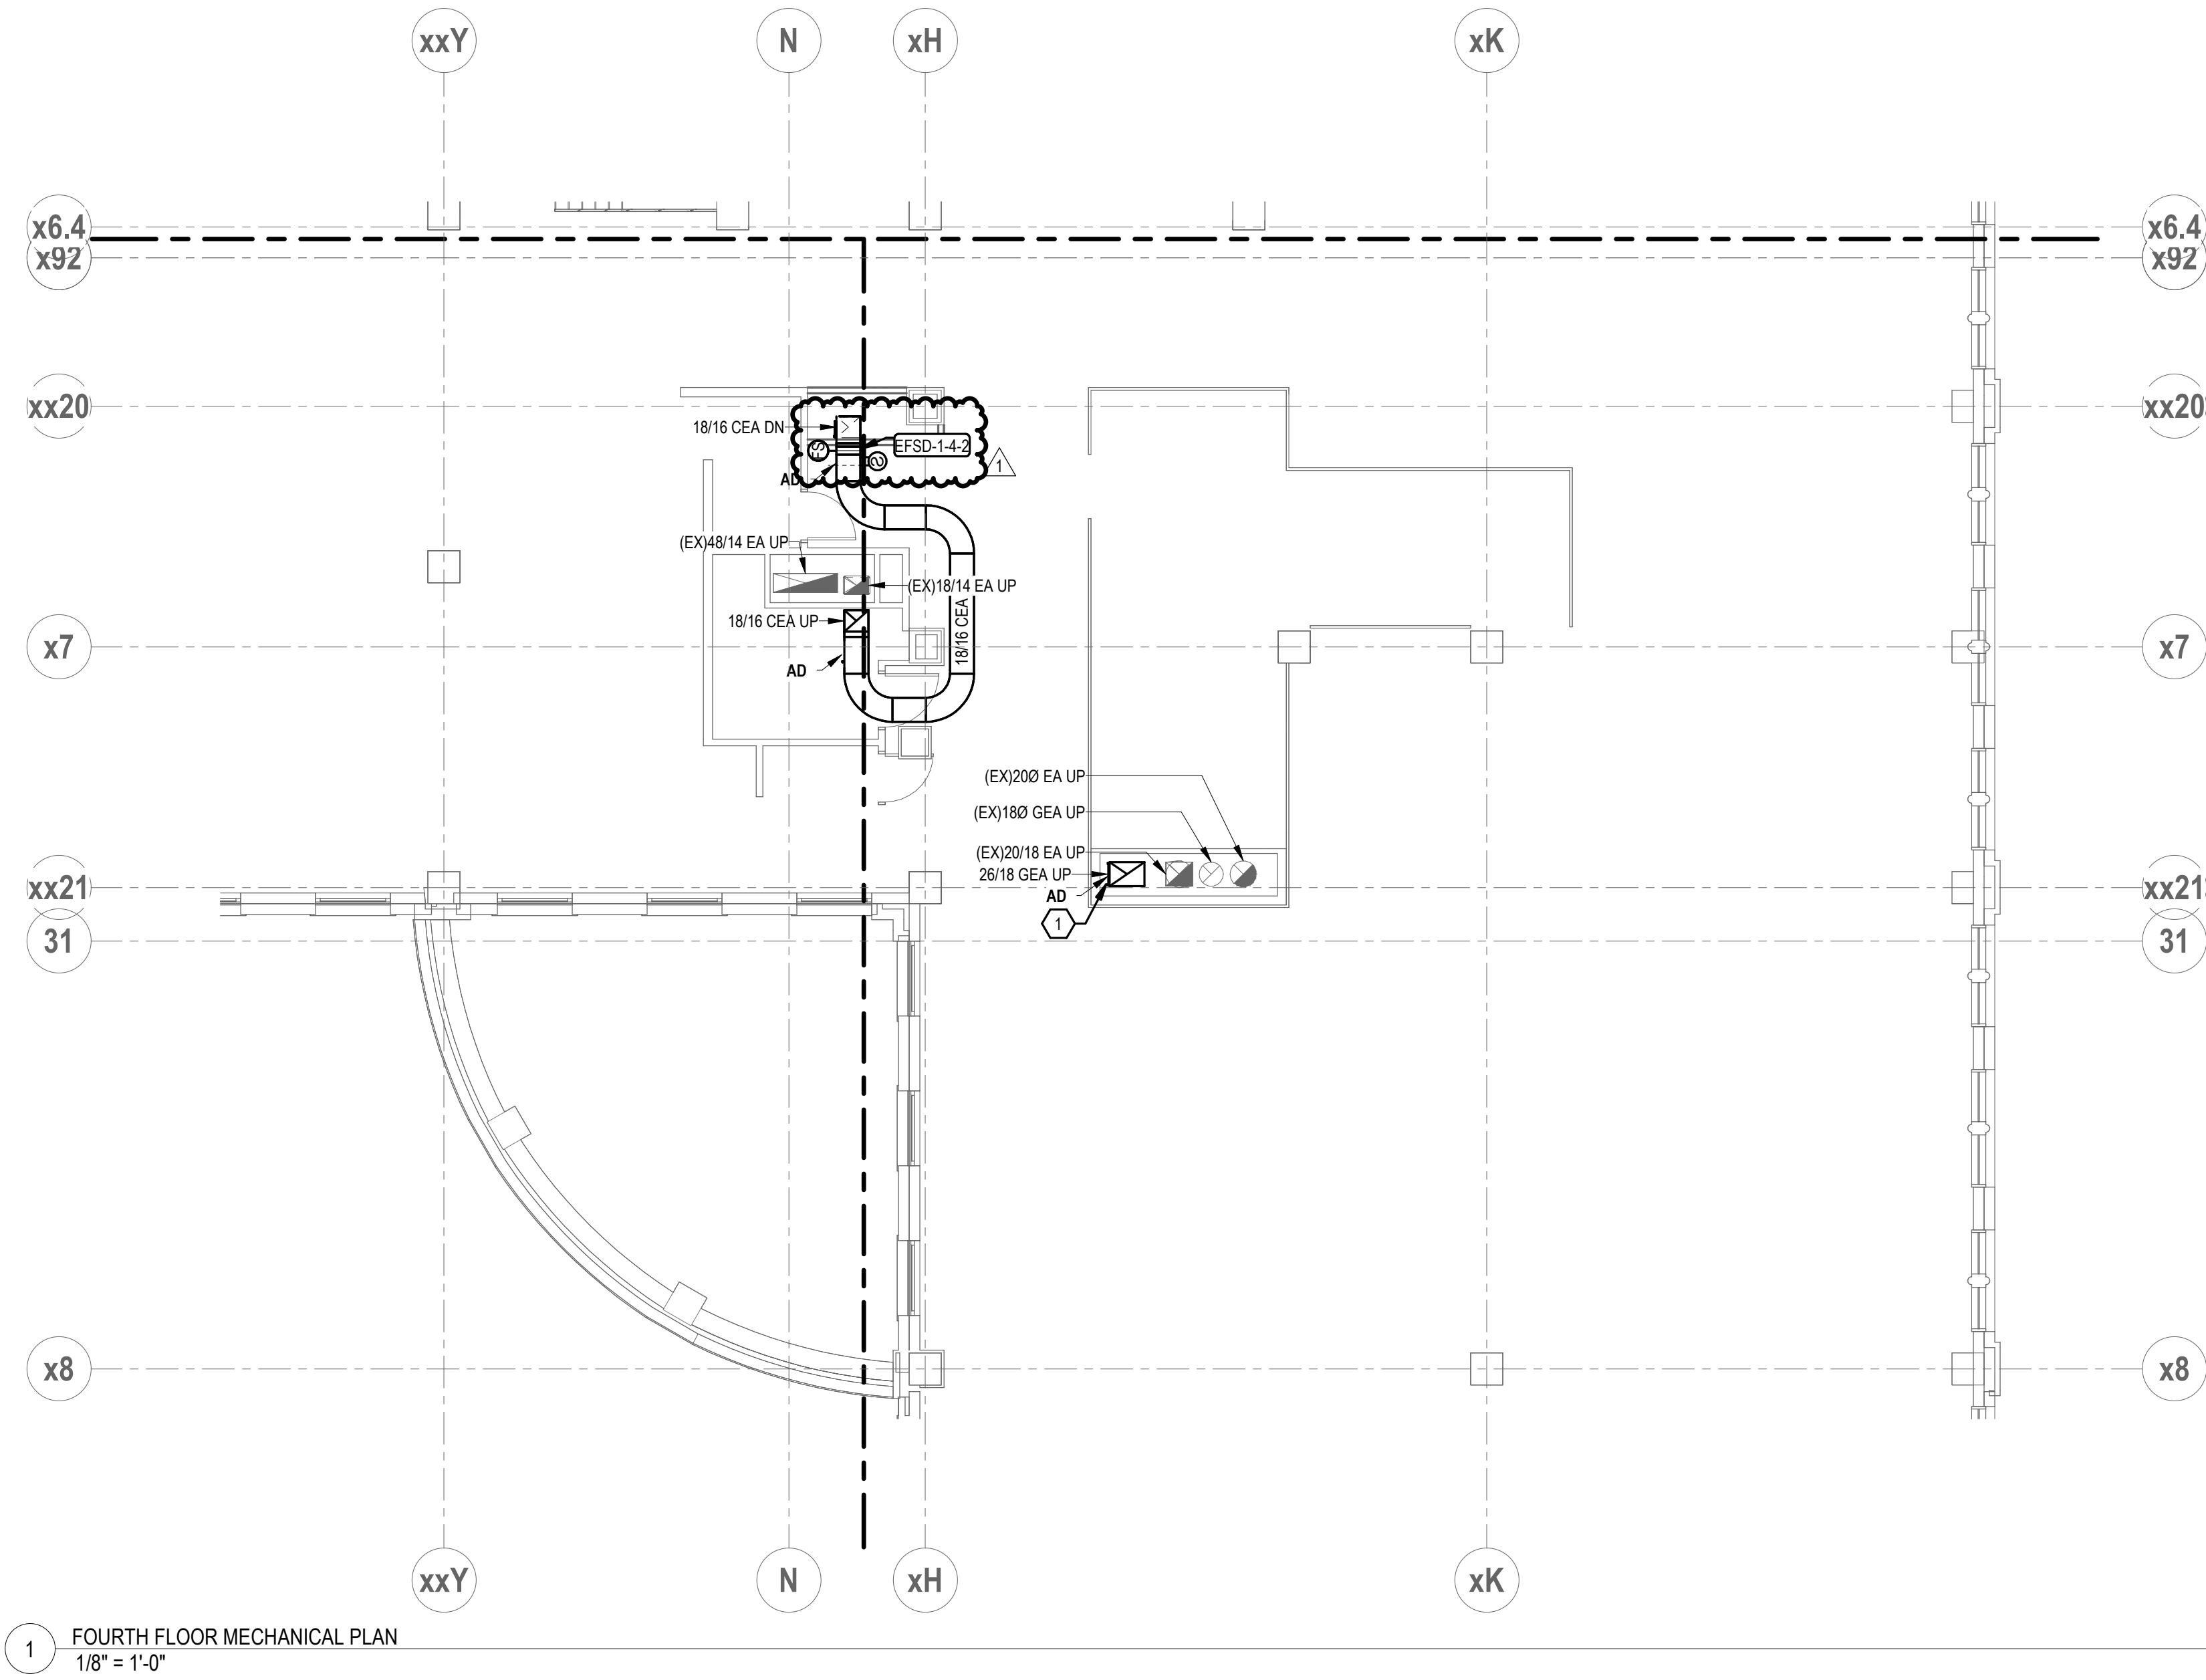

SHEET NOTES


A. ALL BRANCH DUCT SIZES ARE SIZED FOR THE AIR TERMINAL UNIT OR GRILL NECK CONNECTION, UNLESS NOTED OTHERWISE.

B. PROVIDE MANUAL BALANCING DAMPERS IN ALL BRANCH DUCTS FOR MEANS OF BALANCING, WHETHER SHOWN ON THE PLANS OR NOT.

C. REBALANCE ALL EXISTING AIR TERMINALS, DIFFUSERS, REGISTERS AND GRILLES, WITHIN PROJECT SCOPE.

KEYED NOTES

1. ARCHITECTURAL ACCESS PANEL FOR ACCESS TO VERTICAL GREASE EXHAUST DUCTWORK

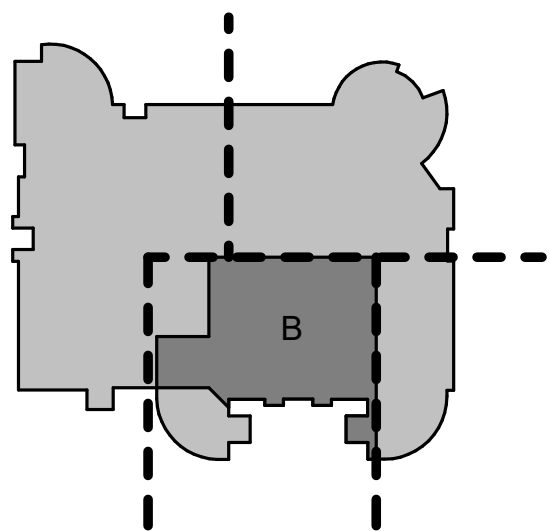

201 E PITTSBURGH AVE #301
MILWAUKEE, WI 53204

WORKSHOP ARCHITECTS, INC.

WORKSHOP ARCHITECTS
201 E PITTSBURGH AVE #301
MILWAUKEE, WI 53204

ARCHITECT

K. SINGH & ASSOCIATES
3636 N. 124TH STREET
WAUWATOSA, WI 53222

CIVIL

SAIKI DESIGN
1110 S PARK STREET
MADISON, WI 53715

LANDSCAPE

THORNTON TOMASETTI
320 E BUFFALO ST #603
MILWAUKEE, WI 53202

STRUCTURAL

RING & DUCHATEAU
17400 W CAPITOL DRIVE
BROOKFIELD, WI 53045

MEP / FP


RIPPE ASSOCIATES
10650 RED CIRCLE DR, STE. 100
MINNEAPOLIS, MN 55343

FOOD SERVICE

SHEN MILSOM & WILKE
125 S. WACKER DRIVE, SUITE 1510
CHICAGO, IL 60606

AV / IT

Board of Regents of the
University of Wisconsin
c/o UW System Administration



Project Location:
975 UNIVERSITY AVE
MADISON, WISCONSIN 53706

GRAINGER HALL DINING EXPANSION AND
RENOVATION
UNIVERSITY OF WISCONSIN - MADISON
MADISON, WISCONSIN 53706

Sheet Title:
FOURTH FLOOR DUCTWORK PLAN - AREA
B

Revisions:

No.	Date:	By:	Description:
1	8/5/2025	ADDERSON/BJP	

Graphic
Scale

0' 2' 4' 8' 12'

UWSA
Number

A-24-004

Volume
Number

2

MSN
Number

9950-2307

Issued
For

BID DOCUMENTS

Date
Issued

06/20/2025

Sheet
Number

M204B

ARCHITECT

TECH

CIVIL

LANDSCAPE

STRUCTURAL


MEP / FR

FOOD SERVICE

AV / R

- A. ALL BRANCH DUCT SIZES ARE SIZED FOR THE AIR TERMINAL UNIT OR GRILL NECK CONNECTION, UNLESS NOTED OTHERWISE.
- B. PROVIDE MANUAL BALANCING DAMPERS IN ALL BRANCH DUCTS FOR MEANS OF BALANCING, WHETHER SHOWN ON THE PLANS OR NOT.
- C. REBALANCE ALL EXISTING AIR TERMINALS, DIFFUSERS, REGISTERS AND GRILLES, WITHIN PROJECT SCOPE.

1. COORDINATE VFD LOCATION WITH EXISTING UTILITY PANELS

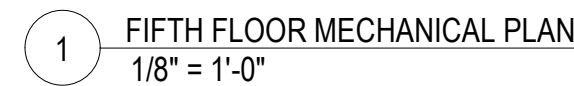

Project Location:

975 UNIVERSITY AVE
MADISON, WISCONSIN 53706

Sheet Title:

FIFTH FLOOR DUCTWORK PLAN - AREA B

[illegible]

A-24-004


2

9950-2307

Date	
------	--

06/20/2025

M205B

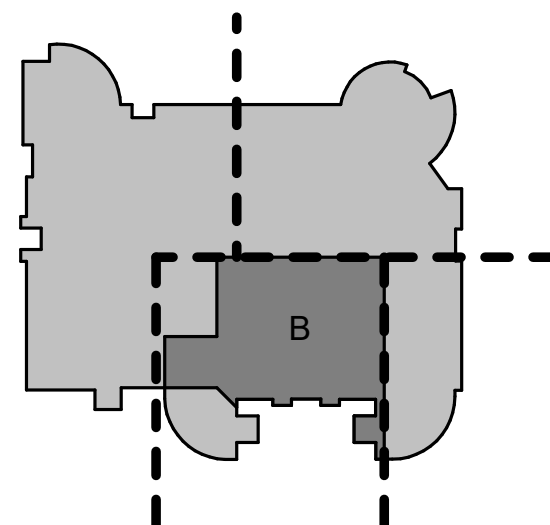

ARCHITECT

CIVIL

LANDSCAPE

STRUCTURAL

MEP / FP

OD SERVICE


AV / IT


A. MECHANICAL CONTRACTOR IS RESPONSIBLE TO TEST AND BALANCE EXISTING IMPACTED SYSTEMS PRIOR TO CONSTRUCTION, AS WELL AS TEST AND BALANCING SYSTEMS UPON CONSTRUCTION COMPLETION. SEE SPECIFICATION SECTION 23 05 93 PART 3 EXECUTION.

1. REBALANCE DAMPERS AND FANS FOR NEW AIRFLOW DIFFERENCES.



EXHAUST AIR RISER DIAGRAM

Graphic Scale	 NO SCALE
UWSA Number	A-24-004
Volume Number	2
MSN Number	9950-2307
Issued For	BID DOCUMENTS
Date Issued	06/20/2025
Sheet Number	M501

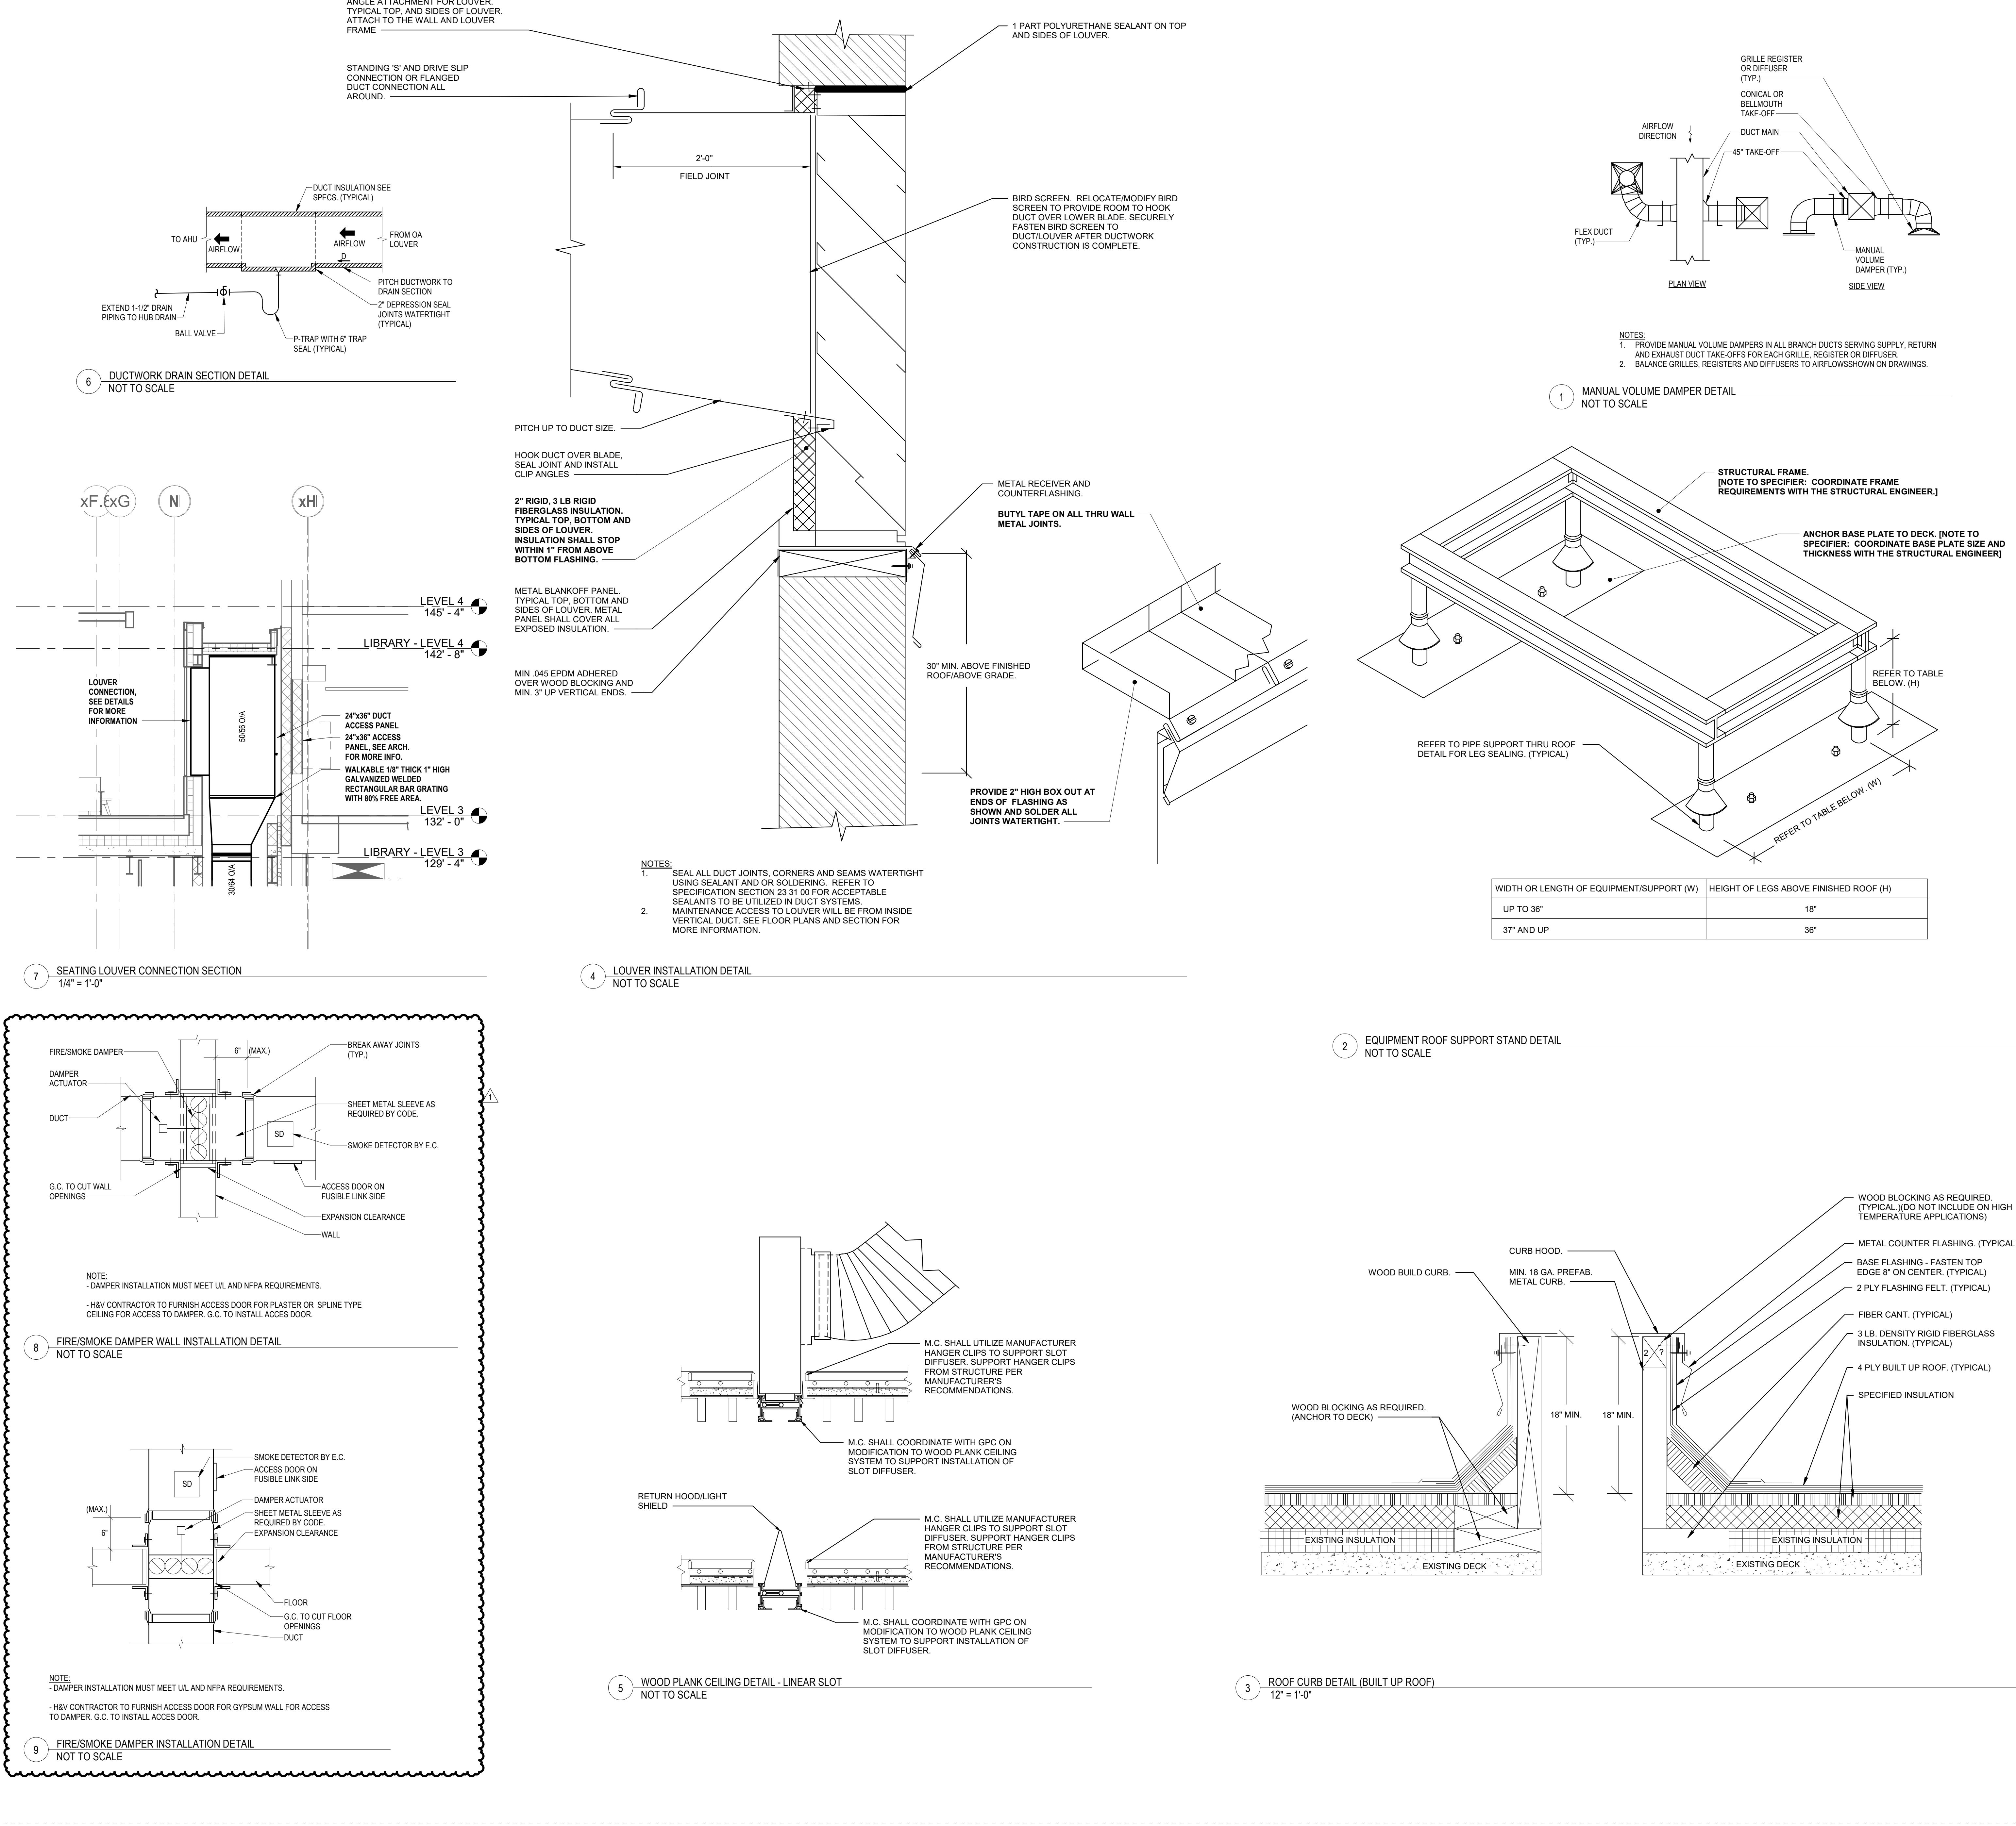

201 E PITTSBURGH AVE #301
MILWAUKEE WI 53204

WORKSHOP ARCHITECTS, INC.

201 E PITTSBURGH AVE #301
MILWAUKEE, WI 53204

ARCHITECT

3636 N. 124TH STREET
WAUWATOSA, WI 53222

CIVIL

1110 S PARK STREET
MADISON, WI 53715

LANDSCAPE

320 E BUFFALO ST #603
MILWAUKEE, WI 53202

STRUCTURAL

17400 W CAPITOL DRIVE
BROOKFIELD, WI 53045

MEP / FP

10650 RED CIRCLE DR, STE. 100
MINNEAPOLIS, MN 55343

FOOD SERVICE

125 S. WACKER DRIVE, SUITE 1510
CHICAGO, IL 60606

AV / IT

Board of Regents of the
University of Wisconsin
c/o UW System Administration

975 UNIVERSITY AVE
MADISON, WISCONSIN 53706

GRAINGER HALL DINING EXPANSION AND
RENOVATION
UNIVERSITY OF WISCONSIN - MADISON
MADISON, WISCONSIN 53706

MECHANICAL DETAILS

Revisions:

No.	Date:	By:	Description:
1	8/5/2025	ADDER/BJP	

Graphic Scale

AS INDICATED

UWSA Number

A-24-004

Volume Number

2

MSN Number

9950-2307

Issued For

BID DOCUMENTS

Date Issued

06/20/2025

Sheet Number

M604

AIR HANDLING UNIT SCHEDULE (AHU)												
NO.	LOCATION	POSITION 1	POSITION 2	POSITION 3	POSITION 4	POSITION 5	POSITION 6	POSITION 7	POSITION 8	POSITION 9	REMARKS	
8	MECH ROOM P133	RRF	IMB	AB	F	FB/HC	AS	CC	AS	SAF	(1)	

NOTES:
(1) REFER TO INDIVIDUAL COMPONENT SCHEDULES FOR CAPACITIES AND FLOWS.

POSITOINS ARE LISTED IN DIRECTION OF AIRFLOW THRU UNIT.

ABBREVIATIONS (POSITIONS LISTED IN DIRECTION OF AIR FLOW FROM SUCTION TO DISCHARGE OF UNIT)

AB: AIR BLENDER
AS: ACCESS SECTION
CB: COIL BYPASS
CC: COOLING COIL
DB: DIFFUSER...
DP: DISCHARGE PLUNUM
DS: DUCT SECTION

EFB: EXTERNAL FACE &...
F: FILTER
FB/HC: FACE & BYPASS/ HEATING COIL...
IMB: INTAKE/MIXING BOX
H: HUMIDIFIER
HC: HEATING COIL

HRD: HEAT RECOVERY DEVICE
IFB: INTERNAL FACE & BYPASS
IS: INSPECTION SECTION
ME: MOISTURE ELIMINATOR
RRF: RETURN/ RELIEF FAN
SAF: SUPPLY AIR FAN

VARIABLE FREQUENCY DRIVE SCHEDULE						
SERVICE	LOCATION	VOLTAGE/PHASE	MOTOR BHP	MOTOR HP	INTEGRAL BYPASS	REMARKS
VFD-SF-16A	MECH ROOM...	480/3	16.47	25	NO	
VFD-SF-16B	MECH ROOM...	480/3	16.47	25	NO	
VFD-RF-9A	MECH ROOM...	480/3	4.08	7.5	NO	
VFD-RF-9B	MECH ROOM...	480/3	4.08	7.5	NO	
VFD-EF-9	5TH FLOOR	480/3	1.98	2.5	YES	
VFD-EF-10	5TH FLOOR	480/3	1.98	2.5	YES	
VFD-EF-17	5TH FLOOR	480/3	3.13	5	YES	

SUPPLY FAN ARRAY SCHEDULE (SF)																		
NO.	LOCATION	SERVICE	FAN ARRAY							INDIVIDUAL FANS							REMARKS	
			TOTAL CFM	MIN. CFM	TSP (IN WC)	ESP (IN WC)	MAX. BHP	CONNECTED MOTOR HP	QTY.	MAX. CFM	MIN. CFM	WIDE	HIGH	CLASS	MOTOR HP	MANUFACTURE R		
AHU-8	16A	MECH ROOM...	ADDITION/REMODEL	12,500	6,500	6.00	3-	17	25	1	12,000	3,250	2	1	II	25	TRANE	(1,2)
AHU-8	16B	MECH ROOM...	ADDITION/REMODEL	12,500	6,500	6.00	3-	17	25	1	12,000	3,250	2	1	II	25	TRANE	(1,2)

NOTES:
(1) FULLY REDUNDANT SUPPLY FAN.
(2) ONE VFD FOR EACH FAN. TWO TOTAL.
(3) REFER TO M500 FOR EXISTING AND NEW AIRFLOW...

NO.	LOCATION	SERVICE	TOTAL CFM	MIN. CFM	TSP (IN WC)	ESP (IN WC)	DISCH. ARR.	CLASS	FAN TYPE	FAN DIA. (IN)	FAN RPM	MOTOR			CAPACITY CONTROL	CONTROL DAMPERS	MANUFACTURER	REMARKS
9A	MECH ROOM P133	RETURN AIR	6,250	0	2 1/2	2-	PLEN	I	PLENUM	22.25	1,673	4.08	7 1/2	DIRECT	VFD	MOD	GREENHECK	50% AIRFLOW CAPACITY
9B	MECH ROOM P133	RETURN AIR	6,250	0	2 1/2	2-	PLEN	I	PLENUM	22.25	1,673	4.08	7 1/2	DIRECT	VFD	MOD	GREENHECK	50% AIRFLOW CAPACITY

NO.	LOCATION	SERVICE	TOTAL CFM	MIN. CFM	TSP (IN WC)	DISCH. ARR.	CLASS	FAN TYPE	FAN DIA. (IN)	FAN RPM	MAX. BHP	HP	DRIVE	CAPACITY CONTROL	CONTROL DAMPERS	MANUFACTURER	MODEL	REMARKS
EF-9	ROOF	GREASE HOOD	3,800	0	3 1/4	VERT.	I	SWSI	16.5	1,750	1.98	2 1/2	BELT	VFD	MOD	TWIN CITY	BCVR-165	1, 2
EF-10	ROOF	CONDENSATE...	2,200	0	2 3/4	VERT.	I	UPBLAST	-	1,750	1.98	2 1/2	BELT	VFD	MOD	GREENHECK	CUBE-240XP	-
EF-17	ROOF	GREASE HOOD	4,600	0	3	VERT.	I	SWSI	18	1,921	3.13	5-	DIRECT	VFD	MOD	GREENHECK	USF-18	-

NOTES:
(1) REUSE EXISTING GREASE EXHAUST FAN #9.
(2) REBALANCE AND RESHEAVE AS NEEDED
(3) REFER TO M501 FOR EXISTING AND NEW AIRFLOW INFORMATION.

DESTRATIFICATION FAN SCHEDULE (DF)												
NO.	LOCATION	SERVICE	FAN				MOUNTING HEIGHT (FT)	ACCESSORIES	MANUFACTURER	MODEL	REMARKS	
			CFM	DIA. (IN)	RPM	TYPE						WATTS
1	WINTER GARDEN-1-1300A-1	WINTER GARDEN-1	547	16.25	1,650	SUSPENDED	45	22.5	SPEED CONTROL	AIRIUS	S-25-SP-SH-277-W	(1)
2	WINTER GARDEN-1-1300A-1	WINTER GARDEN-1	547	16.25	1,650	SUSPENDED	45	22.5	SPEED CONTROL	AIRIUS	S-25-SP-SH-277-W	(1)
3	WINTER GARDEN-1-1300A-1	WINTER GARDEN-1	547	16.25	1,650	SUSPENDED	45	22.5	SPEED CONTROL	AIRIUS	S-25-SP-SH-277-W	(1)
4	WINTER GARDEN-1-1300A-1	WINTER GARDEN-1	547	16.25	1,650	SUSPENDED	45	22.5	SPEED CONTROL	AIRIUS	S-25-SP-SH-277-W	(1)
5	WINTER GARDEN-1-1300A-1	WINTER GARDEN-1	547	16.25	1,650	SUSPENDED	45	22.5	SPEED CONTROL	AIRIUS	S-25-SP-SH-277-W	(1)
6	WINTER GARDEN-1-1300A-1	WINTER GARDEN-1	547	16.25	1,650	SUSPENDED	45	22.5	SPEED CONTROL	AIRIUS	S-25-SP-SH-277-W	(1)
7	WINTER GARDEN-1-1300A-1	WINTER GARDEN-1	547	16.25	1,650	SUSPENDED	45	22.5	SPEED CONTROL	AIRIUS	S-25-SP-SH-277-W	(1)
8	WINTER GARDEN-1-1300A-1	WINTER GARDEN-1	547	16.25	1,650	SUSPENDED	45	22.5	SPEED CONTROL	AIRIUS	S-25-SP-SH-277-W	(1)

NOTES:
(1) FAN UTILIZES FAN HOUSING THAT INTEGRATES WITH DROP CEILING INSTALLATION.

AIR HANDLING UNIT HEATING COIL SCHEDULE - STEAM (HC)																		
NO.	SERVICE	TOTAL CFM	HEAT CFM	EAT (°F)	LAT (°F)	MAX. APD [1]	CAP. (MBH)	STEAM		SIZE (FT)		FACE VELOCITY (FPM)	ROWS	MAX. FPF	COIL TYPE	MANUFACTURER	REMARKS	
								PRESS. (PSIG)	CAPACITY (LBS/HR)	HEIGHT	LENGTH							
HC-1	AHU-8	12,500	12,500	-15	58.7	0.476	1,000	5	1,040	4.5	7.67	601	4	6	VFB	TRANE	-	

NOTES:
[1] MAXIMUM APD BASED ON TOTAL CFM.

AIR HANDLING UNIT COOLING COIL SCHEDULE - WATER (CC)																						
NO.	SERVICE	TOTAL CFM	EAT (°F)		LAT (°F)		MAX. APD (IN WC)	CAP. (TONS)	CAP. (MBH)	FLUID				FACE			ROWS	MAX. FPF	FLUID TYPE	MANUFACTURER	REMARKS	
			DB	WB	DB	WB				GPM	EWT (°F)	LWT (°F)	WPD (FT)	HEIGHT (FT)	LENGT H (FT)	VELOCITY (FPM)						
CC-1	AHU-8	12,500	87.0	75.0	52.0	51.9	0.60	80	961	137	45	59	13.0	57	88	358	8	120	WATER	TRANE	-	

SILENCER SCHEDULE (S)																						
NO.	SERVICE	CFM	DIMENSIONS				VELOCITY (FPM)	MAX. APD (IN WC)	CONFIG.	LINING	ATTENUATION PER OCTAVE BAND (RE 10-12 WATTS)								MANUFACTURER	MODEL	REMARKS	
			LENGTH (FT)	WIDTH (IN)	HEIGHT (IN)	AREA (FT²)					1	2	3	4	5	6	7	8				
1	SUPPLY AIR	12,000	ELBOW	3	2.5	7	1,778	0.3	ELBOW	TEDLAR	5	6	9	12	20	26	23	17	VIBRO ACOUSTICS	RD	-	
2	RETURN AIR	6,500	ELBOW	1.67	2.5	4	1,730	0.3	ELBOW	TEDLAR	5	6	10	12	19	26	23	18	VIBRO ACOUSTICS	RD	-	

AIR FLOW MEASURING STATION SCHEDULE (AFMS)											
NO.	SERVICE	MAX. CFM	MIN. CFM	MAX. VEL. (FPM)	MIN. VEL. (FPM)	MAX. APD (IN WC)	DUCT SIZE (IN)		MOUNTING	MANUFACTURER	REMARKS
							H	W			
19	SF-16A	12,000	3,250	6,750	1,828	0.1	16	16	FAN INLET	-	
20	SF-16B	12,000	3,250	6,750	1,828	0.1	16	16	FAN INLET	-	
21	RF-9	12,000	0	6,750	0	0.1	16	16	FAN INLET	-	

201 E PITTSBURGH AVE #301
MILWAUKEE WI 53204

WORKSHOP
WORKSHOP ARCHITECTS, INC.

ARCHITECT

201 E PITTSBURGH AVE #301
MILWAUKEE, WI 53204

CIVIL

3636 N. 124TH STREET
WAUWATOSA, WI 53222

LANDSCAPE

1110 S PARK STREET
MADISON, WI 53715

STRUCTURAL

330 E BUFFALO ST #603
MILWAUKEE, WI 53202

MEP / FP

17400 W CAPITOL DRIVE
BROOKFIELD, WI 53045

FOOD SERVICE

10650 RED CIRCLE DR. STE. 100
MINNEAPOLIS, MN 55343

AV / IT

125 S. WACKER DRIVE, SUITE 1510
CHICAGO, IL 60606

SHEN MILSOM & WILKE

Board of Regents of the
University of Wisconsin
c/o UW System Administration



Project Location:
975 UNIVERSITY AVE
MADISON, WISCONSIN 53706

GRAINGER HALL DINING EXPANSION AND
RENOVATION
UNIVERSITY OF WISCONSIN - MADISON
MADISON, WISCONSIN 53706

MECHANICAL SCHEDULES

Revisions:		
No.	Date:	By: Description:
1	8/5/2025	ADDERSDORFF

UWSA Number	A-24-004
Volume Number	2
MSN Number	9950-2307
Issued For	BID DOCUMENTS
Date Issued	06/20/2025
Sheet Number	M700

201 E PITTSBURGH AVE #301
MILWAUKEE WI 53204

WORKSHOP ARCHITECTS
201 E PITTSBURGH AVE #301
MILWAUKEE, WI 53204

K. SINGH & ASSOCIATES
3636 N. 124TH STREET
WAUWATOSA, WI 53222

SAIKI DESIGN
1110 S PARK STREET
MADISON, WI 53715

THORNTON TOMASETTI
320 E BUFFALO ST #603
MILWAUKEE, WI 53202

RING & DUCHATEAU
17400 W CAPITOL DRIVE
BROOKFIELD, WI 53045

RIPPE ASSOCIATES
10660 RED CIRCLE DR. STE. 100
MINNEAPOLIS, MN 55343

SHEN MILSOM & WILKE
125 S. WACKER DRIVE, SUITE 1510
CHICAGO, IL 60606

ARCHITECT

CIVIL

LANDSCAPE

STRUCTURAL

MEP / FP

FOOD SERVICE

AV / IT

Board of Regents of the
University of Wisconsin
c/o UW System Administration



Project Location:
975 UNIVERSITY AVE
MADISON, WISCONSIN 53706

GRAINGER HALL DINING EXPANSION AND
RENOVATION
UNIVERSITY OF WISCONSIN - MADISON
MADISON, WISCONSIN 53706

Sheet Title:
MECHANICAL SCHEDULES

Revisions:		Description:	
No.	Date:	By:	
1	9/25/25		ADD RCP/FP

UWSA Number	A-24-004
Volume Number	2
MSN Number	9950-2307
Issued For	BID DOCUMENTS
Date Issued	06/20/2025
Sheet Number	M701

CHILLED WATER HEAT EXCHANGER SCHEDULE (CX)

NO.	SERVICE	TYPE	CHILLED WATER				PROCESS CHILLED WATER				HEIGHT (IN)	WIDTH (IN)	DEPTH (IN)	HTG. SURFACE (FT ²)	FOUL FACTOR	NO. OF PASSES	MANUFACTURER	MODEL	REMARKS
			GPM	EWT (°F)	LWT (°F)	WPD (PSI)	GPM	EWT (°F)	LWT (°F)	WPD (PSI)									
1A	PROCESS CHILLED WATER	PLATE	20	45	55	3.6	20	70	60	4.4	24.3	7.5	4.6	19	0	1	B&G	BP422-20	-
1B	PROCESS CHILLED WATER	PLATE	20	45	55	3.6	20	70	60	4.4	24.3	7.5	4.6	19	0	1	B&G	BP422-20	-

FAN COIL UNIT SCHEDULE - WATER (FCU)

NO.	LOCATION	FAN				HEATING						COOLING												MANUFACTURER	MODEL	REMARKS
		CFM	ESP (IN WC)	HP	MAX. NC	EAT (°F)	LAT (°F)	TOTAL MBH	EWT (°F)	LWT (°F)	GPM	BRANCH PIPE	EDB (°F)	EWB (°F)	LDB (°F)	LWB (°F)	SENS. MBH	TOTAL MBH	EWT (°F)	LWT (°F)	GPM	BRANCH PIPE				
8	MECH ROOM P133	400	1	0.55	-	60	95	15.2	180	150.0	1.0	3/4	80	67	58	58	9.6	12	44	54.1	2.4	3/4	TRANE	BCHE012	-	

GRILLE SCHEDULE

NO.	TYPE	GRILLE FACE (IN)	CFM RANGE	SIZE (IN)		MAX. NC	MATERIA L	FINISH	FRAME	DAMPER	MOUNTING HEIGHT	OPTIONS	MANUFACTURER	MODEL	REMARKS
				SQ.	ROUND										
CD-1	PLAQUE	24x24	SEE PLANS	SEE...	SEE PLANS	30	STL.	W	SEE CEILING...	NO	CEILING	-	PRICE	SPD	(2)
SD-1	SIDEWALL	-	SEE PLANS	SEE...	SEE PLANS	30	STL.	W	F	NO	SIDEWALL	-	PRICE	600	-
SD-2	SIDEWALL	-	SEE PLANS	SEE...	SEE PLANS	30	STL.	W	F	NO	SIDEWALL	-	PRICE	600	-
LD-1	LINEAR-1" 2 SLOT	4.25x48	SEE PLANS	SEE...	SEE PLANS	30	ALUM.	W	SEE CEILING...	NO	SOFFIT	-	PRICE	SDS100	-
LD-2	LINEAR-.5" 2 SLOT	3.25X24	SEE PLANS	SEE...	SEE PLANS	30	ALUM.	W	SEE CEILING...	NO	SOFFIT	-	PRICE	SDS50	-
LD-3	LINEAR-1" 2 SLOT	4.25x60	SEE PLANS	SEE...	SEE PLANS	30	ALUM.	W	SEE CEILING...	NO	SOFFIT	-	PRICE	SDS100	-
LD-4	LINEAR-1.5" 2 SLOT	7.375"	60 CFM / L.F.	SEE...	SEE PLANS	30	ALUM.	W	SEE CEILING...	NO	SOFFIT	-	PRICE	CFC/CFP	(1)
LD-5	LINEAR-1" 2 SLOT	4.25x48	SEE PLANS	SEE...	SEE PLANS	30	ALUM.	W	SEE CEILING...	NO	CEILING	-	PRICE	SDS100	-
LD-6	LINEAR-1" 2 SLOT	4.25x48	SEE PLANS	SEE...	SEE PLANS	30	ALUM.	W	SEE CEILING...	NO	SOFFIT	-	PRICE	SDS100	-
RG-1	PERFORATED	24x24	SEE PLANS	SEE...	SEE PLANS	30	STL.	W	SEE CEILING...	NO	CEILING	-	PRICE	PDR	-
RG-2	SIDEWALL	-	SEE PLANS	SEE...	SEE PLANS	30	STL.	W	F	NO	SIDEWALL	-	PRICE	600	-
EG-1	PERFORATED	24x24	SEE PLANS	SEE...	SEE PLANS	30	ALUM.	W	SEE CEILING...	NO	CEILING	-	PRICE	PDR	-
EG-2	SIDEWALL	-	SEE PLANS	SEE...	SEE PLANS	30	ALUM.	W	F	NO	SIDEWALL	-	PRICE	600	-
TG-1	PERFORATED	24x24	SEE PLANS	SEE...	SEE PLANS	30	STL.	W	SEE CEILING...	NO	CEILING	-	PRICE	PDR	-
TG-2	SIDEWALL	-	SEE PLANS	SEE...	SEE PLANS	30	STL.	W	F	NO	SIDEWALL	-	PRICE	600	-
TG-3	LINEAR	-	SEE PLANS	SEE...	SEE PLANS	30	STL.	W	3/4" FRAME	NO	SIDEWALL	-	PRICE	600	-

OPTIONS:

1- OPPOSED BLADE DAMPER
2- BUTTERFLY DAMPER

3- FIRE DAMPER
4- COMBINATION...

5- EQUALIZING GRID
6- RADIAL

7- FILTER

ABBREVIATIONS:

A- ANODIZED
ALU... ALUMINUM
E- ENAMEL/EPOXY

EG- EXHAUST GRILLE
PERF.- PERFORATED GRILLE
RG- RETURN GRILLE

SUPPLY GRILLE
SATIN POLISH
STAINLESS STEEL

STL- STEEL
TG- TRANSFER...
W- WHITE

FRAME:
C- CHANNEL
F- FLANGE
L- LAY-IN

SI- SNAP-IN
T- REGULAR

NOTES:

(1) BLANK OFF UNUSED PORTION.
(2) IF DIFFUSERS DO NOT SHOW AIRFLOW ARROWS, ASSUME 4-WAY THROW.

RADIANT CEILING PANEL SCHEDULE - WATER (RCP)

NO.	LOCATION	HEATING				COOLING				PANEL SIZE		MAX WPD (FT)	BRANCH PIPE (IN)	MANUFACTURER	MODEL	REMARKS
		CAP. (BTU/FT)	EWT (°F)	LWT (°F)	GPM (PER FT)	CAP. (MBH)	EWT (°F)	LWT (°F)	GPM	LENGTH (IN)	WIDTH (IN)					
1	SEE PLANS	439	180	170	0.09	-	-	-	-	108	36	5	3/4	AIR-TITE	AR-X	-

WATER PRESSURE REGULATING VALVE SCHEDULE (WPRV)

NO.	LOCATION	SERVICE	CAPACITY (GPM)	INLET PRESS. (PSIG)	OUTLET PRESS. (IN)	SIZE (IN)	MANUFACTURER	MODEL	REMARKS
1	MECH ROOM P133	PROCESS CHILLED WATER	2	80	1/2	1/2	WATTS	LFUSB-73	SYSTEM FILL
2	MECH ROOM P133	CHILLED WATER	20	80	1/2	1 1/2	WATTS	LFUSB-73	CITY WATER BACK UP

FIRE/SMOKE DAMPER SCHEDULE (EFSO)

NO.	LOCATION	DUCT		CFM	VEL. (FPM)	AIR SYSTEM		LEAKAGE CLASS [1]	FIRE RATING	PRE-FAB. SLEEVE	SMOKE DETECTOR	MANUFACTURER	MODEL	REMARKS
		SIZE (IN) H W				FAN	TEMP. (°F)							
1-1-1	1ST FLOOR	16 18	2,200	1,100	EF-10	350	III	1.5	YES	YES	RUSKIN	FSD35SS	-	
1-4-2	4TH FLOOR	16 18	2,200	1,100	EF-10	350	III	1.5	YES	YES	RUSKIN	FSD35SS	-	
1-5-3	5TH FLOOR	16 18	2,200	1,100	EF-10	350	III	1.5	YES	YES	RUSKIN	FSD35SS	-	

NOTES:

[1] REUSABLE/RESETTABLE TYPE.
[2] PER U.L. STANDARD 555 & 555S

PUMP SCHEDULE (PCP)

NO.	SERVICE	FLUID		PUMP						MOTOR		SPEED CONTROL TYPE	REMARKS
		TEMP. (°F)	TYPE	GPM	MIN. GPM	HEAD (FT)	NPSH AVAIL. (FT)	MIN. EFF. (%)	TYPE	RPM	HP		
15A	PROCESS CHILLED WATER	60	WATER	20	8	30	-	30%	IN-LINE	2,500	1	ECM	-
15B	PROCESS CHILLED WATER	60	WATER	20	8	30	-	30%	IN-LINE	2,500	1	ECM	-

AIR SEPERATOR SCHEDULE (AS)

NO.	SERVICE	FLUID TYPE	TYPE	SIZE (IN)	FLOW RATE (GPM)	PRESSURE DROP (FT HD)	MANUFACTURER	MODEL	REMARKS
3	PROCESS CHILLED WATER	COLD WATER	AIR & DIRT	2"	20	0.2	BELL AND GOSSETT	CRSN-2G	-

EXPANSION TANK SCHEDULE (ET)

NO.	SERVICE	FLUID TYPE	TYPE	TANK VOLUME (GAL)	EXPANSION VOLUME (GAL)	DIAMETER (IN)	VERT. TANK HEIGHT (IN)	PIPE CONN. (IN)	SUPPORT	MANUFACTURER	MODEL	REMARKS
1	PCW	COLD WATER	BLADDER	10	-	12	24	3/4"	CONCRETE PAD	BELL & GOSSETT	B35	-

WATER FILTER SCHEDULE (WF)

NO.	LOCATION	SERVICE	HOUSING				FILTER CARTRIDGES						REMARKS
			MATERIAL	ASME STAMP	FLOW (GPM)	WPD (FT)	INLET SIZE (IN)	OUTLET SIZE (IN)	QTY.	MEDIA TYPE	CARTRIDGE LENGTH (IN)	WPD (FTHD) CLEAN DIRTY	
1	MECH ROOM P133	PCW	CARBON STEEL	YES	26	1	1 1/2	1 1/2	1	CARTRIDGE	10	2 12	-
2	MECH ROOM P133	PCW	CARBON STEEL	YES	5	1	3/4	3/4	1	CARTRIDGE	10	2 12	-

WATER SAFETY RELIEF VALVE SCHEDULE (WSRV)

NO.	LOCATION	SERVICE	CAPACITY (GPM)	PRESS. SETTING (PSIG)	INLET SIZE (IN)	OUTLET SIZE (IN)	MANUFACTURER	MODEL	REMARKS
1	MECH ROOM P133	PROCESS CHILLED WATER	-	65	1/2	1/2	KUNKLE	900 SERIES	-

CONDENSATE PUMP SCHEDULE (CP)

NO.	LOCATION	TYPE	SYSTEM CAPACITY	FLUID		RECEIVER			PUMP				MANUFACTURER	MODEL	REMARKS	
				TEMP. (°F)	TYPE	CAP. (GAL)	MATERIAL	INLET SIZE (IN)	GPM	DISCH. PRESS. (PSIG)	RPM	QTY.				HP (EA)
CP-2	MECH ROOM P133	DUPLEX	2,250	212	CONDENSATE	23	CAST IRON	2	9	30	3,500	2	3/4	BELL & GOSSETT	SERIES CB	-

CABINET UNIT HEATER SCHEDULE - WATER (CUH)

NO.	LOCATION	FAN				COIL				BRANCH PIPE (IN)	UNIT CONFIGURATION	RECESS (IN)	HEIGHT ABV. FLR. (IN)	ACCESSORIES				MANUFACTURER	MODEL	REMARKS			
		CFM	ESP (IN WC)	RPM	HP	EAT (°F)	LAT (°F)	CAP. (MBH)	GPM					WPD (FT)	EWT (°F)	LWT (°F)	SUB BASE				FALSE BACK	RECESSED FLANGES	PROJECTIO N...
23	VESTIBULE 1500T	600	0.3	1,450	1/6	60	100	63.2	7.0	16.3	180	160	1-	VERT. RECESSED	9"	9"	NO	NO	NO	NO	TRANE	FFHB060	
24	VESTIBULE 1500S	600	0.3	1,450	1/6	60	100	63.2	7.0	16.3	180	160	1-	VERT. RECESSED	9"	9"	NO	NO	NO	NO	TRANE	FFHB060	
25	COMMONS 3447	700	0.3	1,538	0.195	60	100	30.0	0.8	0.9	180	120	3/4	HORZ. RECESSED	9"	108	NO	NO	NO	NO	TRANE	FFEBO60	
26	CORRIDOR 3500L	700	0.3	1,538	0.195	60	100	30.0	0.8	0.9	180	120	3/4	HORZ. RECESSED	9"	108	NO	NO	NO	NO	TRANE	FFEBO60	

EQUIPMENT ELECTRICAL SCHEDULE

EQUIPMENT			ELECTRICAL DATA								MOTOR CONTROLLER										DISCONNECT AT EQUIPMENT				SCCR (KA)	REMARKS	
NO.	LOCATION	TYPE	V	PH	HP	KW	FLA	MCA	MOP	EMERG. POWER	LOCATION	TYPE	DISCONNECT	VFD RESTART	FURN. BY	INST. BY	WIRE BY	ACCESSORIES			TYPE	FURN. BY	INST. BY	WIRE BY			
AHU-8-SF-16A	MECH ROOM P133	SUPPLY FAN ARRAY	480	3	25	-	-	-	-	YES	MECH. ROOM	VFD (NO BYPASS)	YES	NO	MC	EC	EC	EC (HOA)	(PL)	(PB)	-	-	-	-	-	-	-
AHU-8-SF-16B	MECH ROOM P133	SUPPLY FAN ARRAY	480	3	25	-	-	-	-	YES	MECH. ROOM	VFD (NO BYPASS)	YES	NO	MC	EC	EC	EC (HOA)	(PL)	(PB)	-	-	-	-	-	-	-
AHU-8 SERVICE	MECH ROOM P133	SERVICE LIGHTS	120	1	-	-	-	-	15	YES	-	-	-	-	-	-	-	-	-	-	(INDOOR)	(NF)	EC	EC	EC	-	-
RF-9A	MECH ROOM P133	RETURN AIR FAN	480	3	7 1/2	-	-	-	-	YES	MECH. ROOM	VFD (NO BYPASS)	YES	NO	MC	EC	EC	EC (HOA)	(PL)	(PB)	(INDOOR)	(NF)	EC	EC	EC	-	-
RF-9B	MECH ROOM P133	RETURN AIR FAN	480	3	7 1/2	-	-	-	-	YES	MECH. ROOM	VFD (NO BYPASS)	YES	NO	MC	EC	EC	EC (HOA)	(PL)	(PB)	(INDOOR)	(NF)	EC	EC	EC	-	-
EF-9	ROOF	CENTRIFUGAL EXHAUST FAN	480	3	2 1/2	-	-	-	-	NO	PENTHOUSE	VFD (BYPASS-SOFT START)	YES	NO	MC	EC	EC	EC (HOA)	(PL)	(PB)	(OUTDOOR)	(NF)	EC	EC	EC	-	(1)
EF-10	ROOF	UPBLAST EXHAUST FAN	480	3	2 1/2	-	-	-	-	YES	PENTHOUSE	VFD (BYPASS-SOFT START)	YES	NO	MC	EC	EC	EC (HOA)	(PL)	(PB)	(OUTDOOR)	(NF)	EC	EC	EC	-	(2)
EF-17	ROOF	CENTRIFUGAL EXHAUST FAN	480	3	5	-	-	-	-	NO	PENTHOUSE	VFD (BYPASS-SOFT START)	YES	NO	MC	EC	EC	EC (HOA)	(PL)	(PB)	(OUTDOOR)	(NF)	EC	EC	EC	-	-
DF-1	WINTER GARDEN-1	DESTRATIFICATION	277	1	-	0.045	-	-	-	NO	WINTER GARDEN 1	MANUAL	NO	NO	MC	EC	EC	-	-	-	-	-	-	-	-	-	
DF-2	WINTER GARDEN-1	DESTRATIFICATION	277	1	-	0.045	-	-	-	NO	WINTER GARDEN 1	MANUAL	NO	NO	MC	EC	EC	-	-	-	-	-	-	-	-	-	
DF-3	WINTER GARDEN-1	DESTRATIFICATION	277	1	-	0.045	-	-	-	NO	WINTER GARDEN 1	MANUAL	NO	NO	MC	EC	EC	-	-	-	-	-	-	-	-	-	
DF-4	WINTER GARDEN-1	DESTRATIFICATION	277	1	-	0.045	-	-	-	NO	WINTER GARDEN 1	MANUAL	NO	NO	MC	EC	EC	-	-	-	-	-	-	-	-	-	
DF-5	WINTER GARDEN-1	DESTRATIFICATION	277	1	-	0.045	-	-	-	NO	WINTER GARDEN 1	MANUAL	NO	NO	MC	EC	EC	-	-	-	-	-	-	-	-	-	
DF-6	WINTER GARDEN-1	DESTRATIFICATION	277	1	-	0.045	-	-	-	NO	WINTER GARDEN 1	MANUAL	NO	NO	MC	EC	EC	-	-	-	-	-	-	-	-	-	
DF-7	WINTER GARDEN-1	DESTRATIFICATION	277	1	-	0.045	-	-	-	NO	WINTER GARDEN 1	MANUAL	NO	NO	MC	EC	EC	-	-	-	-	-	-	-	-	-	
DF-8	WINTER GARDEN-1	DESTRATIFICATION	277	1	-	0.045	-	-	-	NO	WINTER GARDEN 1	MANUAL	NO	NO	MC	EC	EC	-	-	-	-	-	-	-	-	-	
PCP-15A	MECH ROOM P133	INLINE PUMP	208	3	1	-	-	-	-	NO	MECH. ROOM	MANUAL	YES	NO	MC	EC	EC	EC (HOA)	(PL)	(PB)	(INDOOR)	(NF)	EC	EC	EC	-	-
PCP-15B	MECH ROOM P133	INLINE PUMP	208	3	1	-	-	-	-	NO	MECH. ROOM	MANUAL	YES	NO	MC	EC	EC	EC (HOA)	(PL)	(PB)	(INDOOR)	(NF)	EC	EC	EC	-	-
CP-2	MECH ROOM P133	STEAM CONDENSATE PUMP	208	3	1/2	-	-	-	-	NO	MECH. ROOM	MAGNETIC	NO	NO	MFR	MFR	EC	-	-	-	(INDOOR)	(NF)	EC	EC	EC	-	(3)
FCU-8	MECH ROOM P133	FAN COIL UNIT	208	1	0.55	-	-	-	-	NO	MECH. ROOM	MANUAL	NO	NO	MFR	MFR	EC	-	-	-	(INDOOR)	(NF)	EC	EC	EC	-	-
CUH-23	VESTIBULE 1500T	CABINET UNIT HEATER	120	1	1/6	-	-	-	-	NO	VESTIBULE 1500T	MANUAL	NO	NO	MFR	MFR	EC	-	-	-	(INDOOR)	(NF)	EC	EC	EC	-	-
CUH-24	VESTIBULE 1500S	CABINET UNIT HEATER	120	1	1/6	-	-	-	-	NO	VESTIBULE 1500S	MANUAL	NO	NO	MFR	MFR	EC	-	-	-	(INDOOR)	(NF)	EC	EC	EC	-	-
CUH-25	COMMONS 3447	CABINET UNIT HEATER	120	1	0.195	-	-	-	-	NO	COMMONS 3447	MANUAL	NO	NO	MFR	MFR	EC	-	-	-	(INDOOR)	(NF)	EC	EC	EC	-	-
CUH-26	CORRIDOR 3500L	CABINET UNIT HEATER	120	1	0.195	-	-	-	-	NO	CORRIDOR 3500L	MANUAL	NO	NO	MFR	MFR	EC	-	-	-	(INDOOR)	(NF)	EC	EC	EC	-	-
TCP-1	MECH ROOM P133	TEMPERATURE CONTROL PANEL	120	1	-	-	-	-	-	20	NO	-	-	-	-	-	-	-	-	-	(INDOOR)	(NF)	EC	EC	EC	-	-
TCP-2	STORAGE 1225	TEMPERATURE CONTROL PANEL	120	1	-	-	-	-	-	20	NO	-	-	-	-	-	-	-	-	-	(INDOOR)	(NF)	EC	EC	EC	-	-
TCP-3	STORAGE 1297	TEMPERATURE CONTROL PANEL	120	1	-	-	-	-	-	20	NO	-	-	-	-	-	-	-	-	-	(INDOOR)	(NF)	EC	EC	EC	-	-
VAV BOXES	VARIOUS	VAV BOXES	24	1	-	-	-	-	-	NO	-	-	-	-	-	-	-	-	-	-	(INDOOR)	(NF)	EC	EC	EC	-	-
CONTROL DAMPERS	MECH ROOM P133	CONTROL DAMPERS	24	1	-	-	-	-	-	NO	-	-	-	-	-	-	-	-	-	-	(INDOOR)	(NF)	EC	EC	EC	-	-
SMOKE DAMPERS	MECH ROOM P133	SMOKE DAMPERS	24	1	-	-	-	-	-	NO	-	-	-	-	-	-	-	-	-	-	(INDOOR)	(NF)	EC	EC	EC	-	-
CONTROL VALVES	MECH ROOM P133	WATER CONTROL VALVES	24	1	-	-	-	-	-	NO	-	-	-	-	-	-	-	-	-	-	(INDOOR)	(NF)	EC	EC	EC	-	-
CW FLOW METER	EXTG MECH ROOM	WATER METER	120	1	-	-	-	-	-	NO	-	-	-	-	-	-	-	-	-	-	(INDOOR)	(NF)	EC	EC	EC	-	-
PUMPED CONDENSATE FLOW METER	EXTG MECH ROOM	STEAM METER	120	1	-	-	-	-	-	NO	-	-	-	-	-	-	-	-	-	-	(INDOOR)	(NF)	EC	EC	EC	-	-

ABBREVIATIONS:

MC MECHANICAL CONTRACTOR
EC ELECTRICAL CONTRACTOR
MFR MANUFACTURER
TCC TEMPERATURE CONTROL CONTRACTOR

FLA FULL LOAD...
MCA MIN. CIRCUIT AMPS
MOP MAX. OVERCURRENT PROTECTION

VFD VARIABLE FREQUENCY DRIVE
MCC MOTOR CONTROL CENTER

ACCESSORIES:

(HOA) HAND-OFF-AUTO
(PL) PILOT LIGHT
(PB) PUSH BUTTON

DISCONNECT TYPE:

(OUTDOOR) WEATHER PROOF
(INDOOR) NON-WEATHER PROOF
(F) FUSED
(NF) NON-FUSED

NOTES:


G1. SEE SPECIFIC EQUIPMENT SCHEDULES FOR ADDITIONAL INFORMATION.

G2. THE SHORT CIRCUIT CURRENT RATING (SCCR) IS THE MINIMUM CALCULATED VALUE OF FAULT CURRENT AMPACITY REQUIRED FOR THIS PIECE OF EQUIPMENT. THIS CONTRACTOR SHALL PROVIDE EQUIPMENT WITH A SHORT CIRCUIT CURRENT RATING EQUAL TO OR GREATER THAN THE VALUE INDICATED, INCLUDING ANY ASSOCIATED MOTOR CONTROLLERS, CONTROL PANELS, FUSIBLE DISCONNECT SWITCHES, ETC. EQUIPMENT NAMEPLATE SHALL CLEARLY INDICATE THE SCCR RATING FOR THE EQUIPMENT AS REQUIRED TO MEET ALL APPLICABLE CODES AND RECOGNIZED QUALIFIED ELECTRICAL TESTING LABORATORIES (ETL).

(1) REUSE EXISTING EXHAUST FAN.
(2) REPLACING EXISTING EXHAUST FAN.
(3) DUPLEX PUMP SKID TO A SINGLE POWER POINT CONNECTION.

AIR TERMINALS

NO.	SERVICE	AIRFLOW				COIL								BRANCH PIPE SIZE (IN)	BRANCH INLET DIA. (IN)	BOX OUTLET DUCT SIZE (IN)	OCCUPANCY SENSOR		AHU SERVED BY	MANUFACTURER	MODEL	REMARKS
		MAX. CFM	MIN. CFM	HEATING CFM	APD (IN WC)	EAT (°F)	LAT (°F)	HL (MBH)	CAP. (MBH)	GPM	EWT (°F)	LWT (°F)	WPD (°F)				BAS CONTROL	PROVIDED BY				
SAT-1-1-1	1200K - HALLWAY	300	300	300	0.4	55	85	0.0	9.8	1.0	180	160	4	3/4	10	12x10	YES	EC	BUAC-1	PRICE	SDV-8	-
SAT-1-1-2	1250 - PRIVATE DINING	2,400	665	665	0.4	55	85	0.0	21.6	2.2	180	160	4	3/4	18	24x18	YES	EC	BUAC-1	PRICE	SDV-16	-
SAT-1-1-3	1250A - CATERING SUPPORT	175	175	175	0.4	55	85	0.0	5.7	0.6	180	160	4	3/4	8	12x8	YES	EC	BUAC-1	PRICE	SDV-6	-
SAT-1-1-4	1266 - FIREPLACE LOUNGE	600	320	320	0.4	55	85	0.0	10.4	1.0	180	160	4	3/4	12	14x12	YES	EC	BUAC-1	PRICE	SDV-10	-
SAT-1-1-5	1290 - PRIVATE CO-WORKING	630	160	160	0.4	55	85	0.0	5.2	0.5	180	160	4	3/4	12	14x12	YES	EC	BUAC-1	PRICE	SDV-10	-
SAT-1-1-6	1290A, 1290B - WORKSTATIONS	100	40	40	0.4	55	85	0.0	1.3	0.1	180	160	4	3/4	6	12x8	YES	EC	BUAC-1	PRICE	SDV-6	-
SAT-1-1-7	1290C, 1290D, 1290E - OFFICES	225	90	90	0.4	55	85	0.0	2.9	0.3	180	160	4	3/4	8	12x8	YES	EC	BUAC-1	PRICE	SDV-8	-
SAT-1-1-8	1290F, 1290G, 1290H - OFFICES	225	90	90	0.4	55	85	0.0	2.9	0.3	180	160	4	3/4	8	12x8	YES	EC	BUAC-1	PRICE	SDV-8	-
SAT-1-1-9	1297 - STORAGE	180	180	180	0.4	55	85	2.6	5.9	0.6	180	160	4	3/4	8	12x8	YES	EC	BUAC-1	PRICE	SDV-6	-
EX-SAT-1E-9	CORRIDOR 1200R	200	60	200	0.4	55	85	0.0	6.5	0.7	180	160	4	3/4	8	12x8	YES	EC	BUAC-1	-	-	(4)
SAT-13-1-1	1230 - SEATING, 1230C - COUNTER, 1230D-CORRIDOR	910	310	310	0.4	55	85	0.0	10.1	1.0	180	160	4	3/4	12	14x12	YES	EC	AHU-6&7	PRICE	SDV-10	-
SAT-13-1-2	1231 - SEATING, 1230C - COUNTER, 1230D-CORRIDOR	1,200	1,100	1,100	0.4	55	85	15.5	35.8	3.6	180	160	4	3/4	14	16x15	YES	EC	AHU-6&7	PRICE	SDV-12	-
SAT-13-1-3	1232 - SEATING, 1230C - COUNTER, 1230D-CORRIDOR	515	200	200	0.4	55	85	0.0	6.5	0.7	180	160	4	3/4	10	12x10	YES	EC	AHU-6&7	PRICE	SDV-8	-
SAT-13-1-4	1230B - STARBUCKS BOH	440	440	440	0.4	55	85	0.0	14.3	1.4	180	160	4	3/4	10	12x10	YES	EC	AHU-6&7	PRICE	SDV-8	-
SAT-13-1-5	1329 - CATERING SUPPORT	120	70	70	0.4	55	85	0.0	2.3	0.2	180	160	4	3/4	6	12x8	YES	EC	AHU-6&7	PRICE	SDV-6	-
SAT-13-1-6	1310 - PLENARY	3,300	1,125	1,125	0.4	55	85	0.0	36.6	3.7	180	160	4	3/4	24x16	38x18	YES	EC	AHU-6&7	PRICE	SDV-24/16	(2)
SAT-13-1-7	MOTHERS' ROOM 1455	100	50	100	0.4	55	85	0.0	3.3	0.3	180	160	4	3/4	6	12x8	YES	EC	AHU-6&7	PRICE	SDV-6	(3)
(EX) SAT-1-12	1450 - COMMONS	600	250	250	0.4	55	85	0.0	8.1	0.8	180	160	4	3/4	12	14x12	YES	EC	AHU-6&7	-	-	(4)
(EX) SAT-1-11	1451 - COMMONS	500	200	200	0.4	55	85	0.0	6.5	0.7	180	160	4	3/4	10	12x10	YES	EC	AHU-6&7	-	-	(4)
SAT-16-1-11	WINTER GARDEN-1 - 1300A-1	2,270	860	2,270	0.4	55	85	21.7	73.9	7.4	180	160	4	1	18	24x18	YES	EC	AHU-8	PRICE	SDV-16	(3)
SAT-16-1-10	WINTER GARDEN-1 - 1300A-1	1,160	430	1,160	0.4	55	85	10.8	37.8	3.8	180	160	4	3/4	14	16x15	YES	EC	AHU-8	PRICE	SDV-12	(3)
SAT-16-1-9	WINTER GARDEN-1 - 1300A-1	2,270	860	2,270	0.4	55	85	21.7	73.9	7.4	180	160	4	1	18	24x18	YES	EC	AHU-8	PRICE	SDV-16	(3)
SAT-16-1-13	WINTER GARDEN-1 - 1300A-1	1,000	370	1,000	0.4	55	85	0.0	32.6	3.3	180	160	4	3/4	14	16x15	YES	EC	AHU-8	PRICE	SDV-12	(3)
SAT-16-1-1	WINTER GARDEN-1 - 1300A-1	1,600	600	1,600	0.4	55	85	0.0	52.1	5.2	180	160	4	1	16	20x18	YES	EC	AHU-8	PRICE	SDV-14	(3)
SAT-16-1-3	RETAIL OFFICE - 1464D	100	40	100	0.4	55	85	0.0	3.3	0.3	180	160	4	3/4	6	12x8	YES	EC	AHU-8	PRICE	SDV-6	(3)
SAT-16-1-4	CATERING KITCHEN - 1530	1,300	1,300	1,300	0.4	55	85	18.9	42.9	4.3	180	160	4	1	14	16x15	YES	EC	AHU-8	PRICE	SDV-12	(3)
SAT-16-1-6	PREP - 1530A	650	380	650	0.4	55	85	9.5	21.5	2.1	180	160	4	3/4	12	14x12	YES	EC	AHU-8	PRICE	SDV-10	(3)
SAT-16-1-8	1445 - C-STORE	1,625	690	1,625	0.4	55	85	17.0	52.9	5.3	180	160	4	1	16	20x18	YES	EC	AHU-8	PRICE	SDV-14	(3)
SAT-16-1-12	HUDDLE - 1501, HUDDLE - 1502	200	100	200	0.4	55	85	0.0	6.5	0.7	180	160	4	3/4	8	12x8	YES	EC	AHU-8	PRICE	SDV-8	(3)
SAT-16-1-5	EVENTS OFFICE - 1524, CATERING/EVENTS OFFICE - 1526	200	60	200	0.4	55	85	0.0	6.5	0.7	180	160	4	3/4	8	12x8	YES	EC	AHU-8	PRICE	SDV-8	(3)
SAT-16-1-7	CIE OFFICE - 1525, CIE OFFICE - 1527	200	60	200	0.4	55	85	0.0	6.5	0.7	180	160	4	3/4	8	12x8	YES	EC	AHU-8	PRICE	SDV-8	(3)

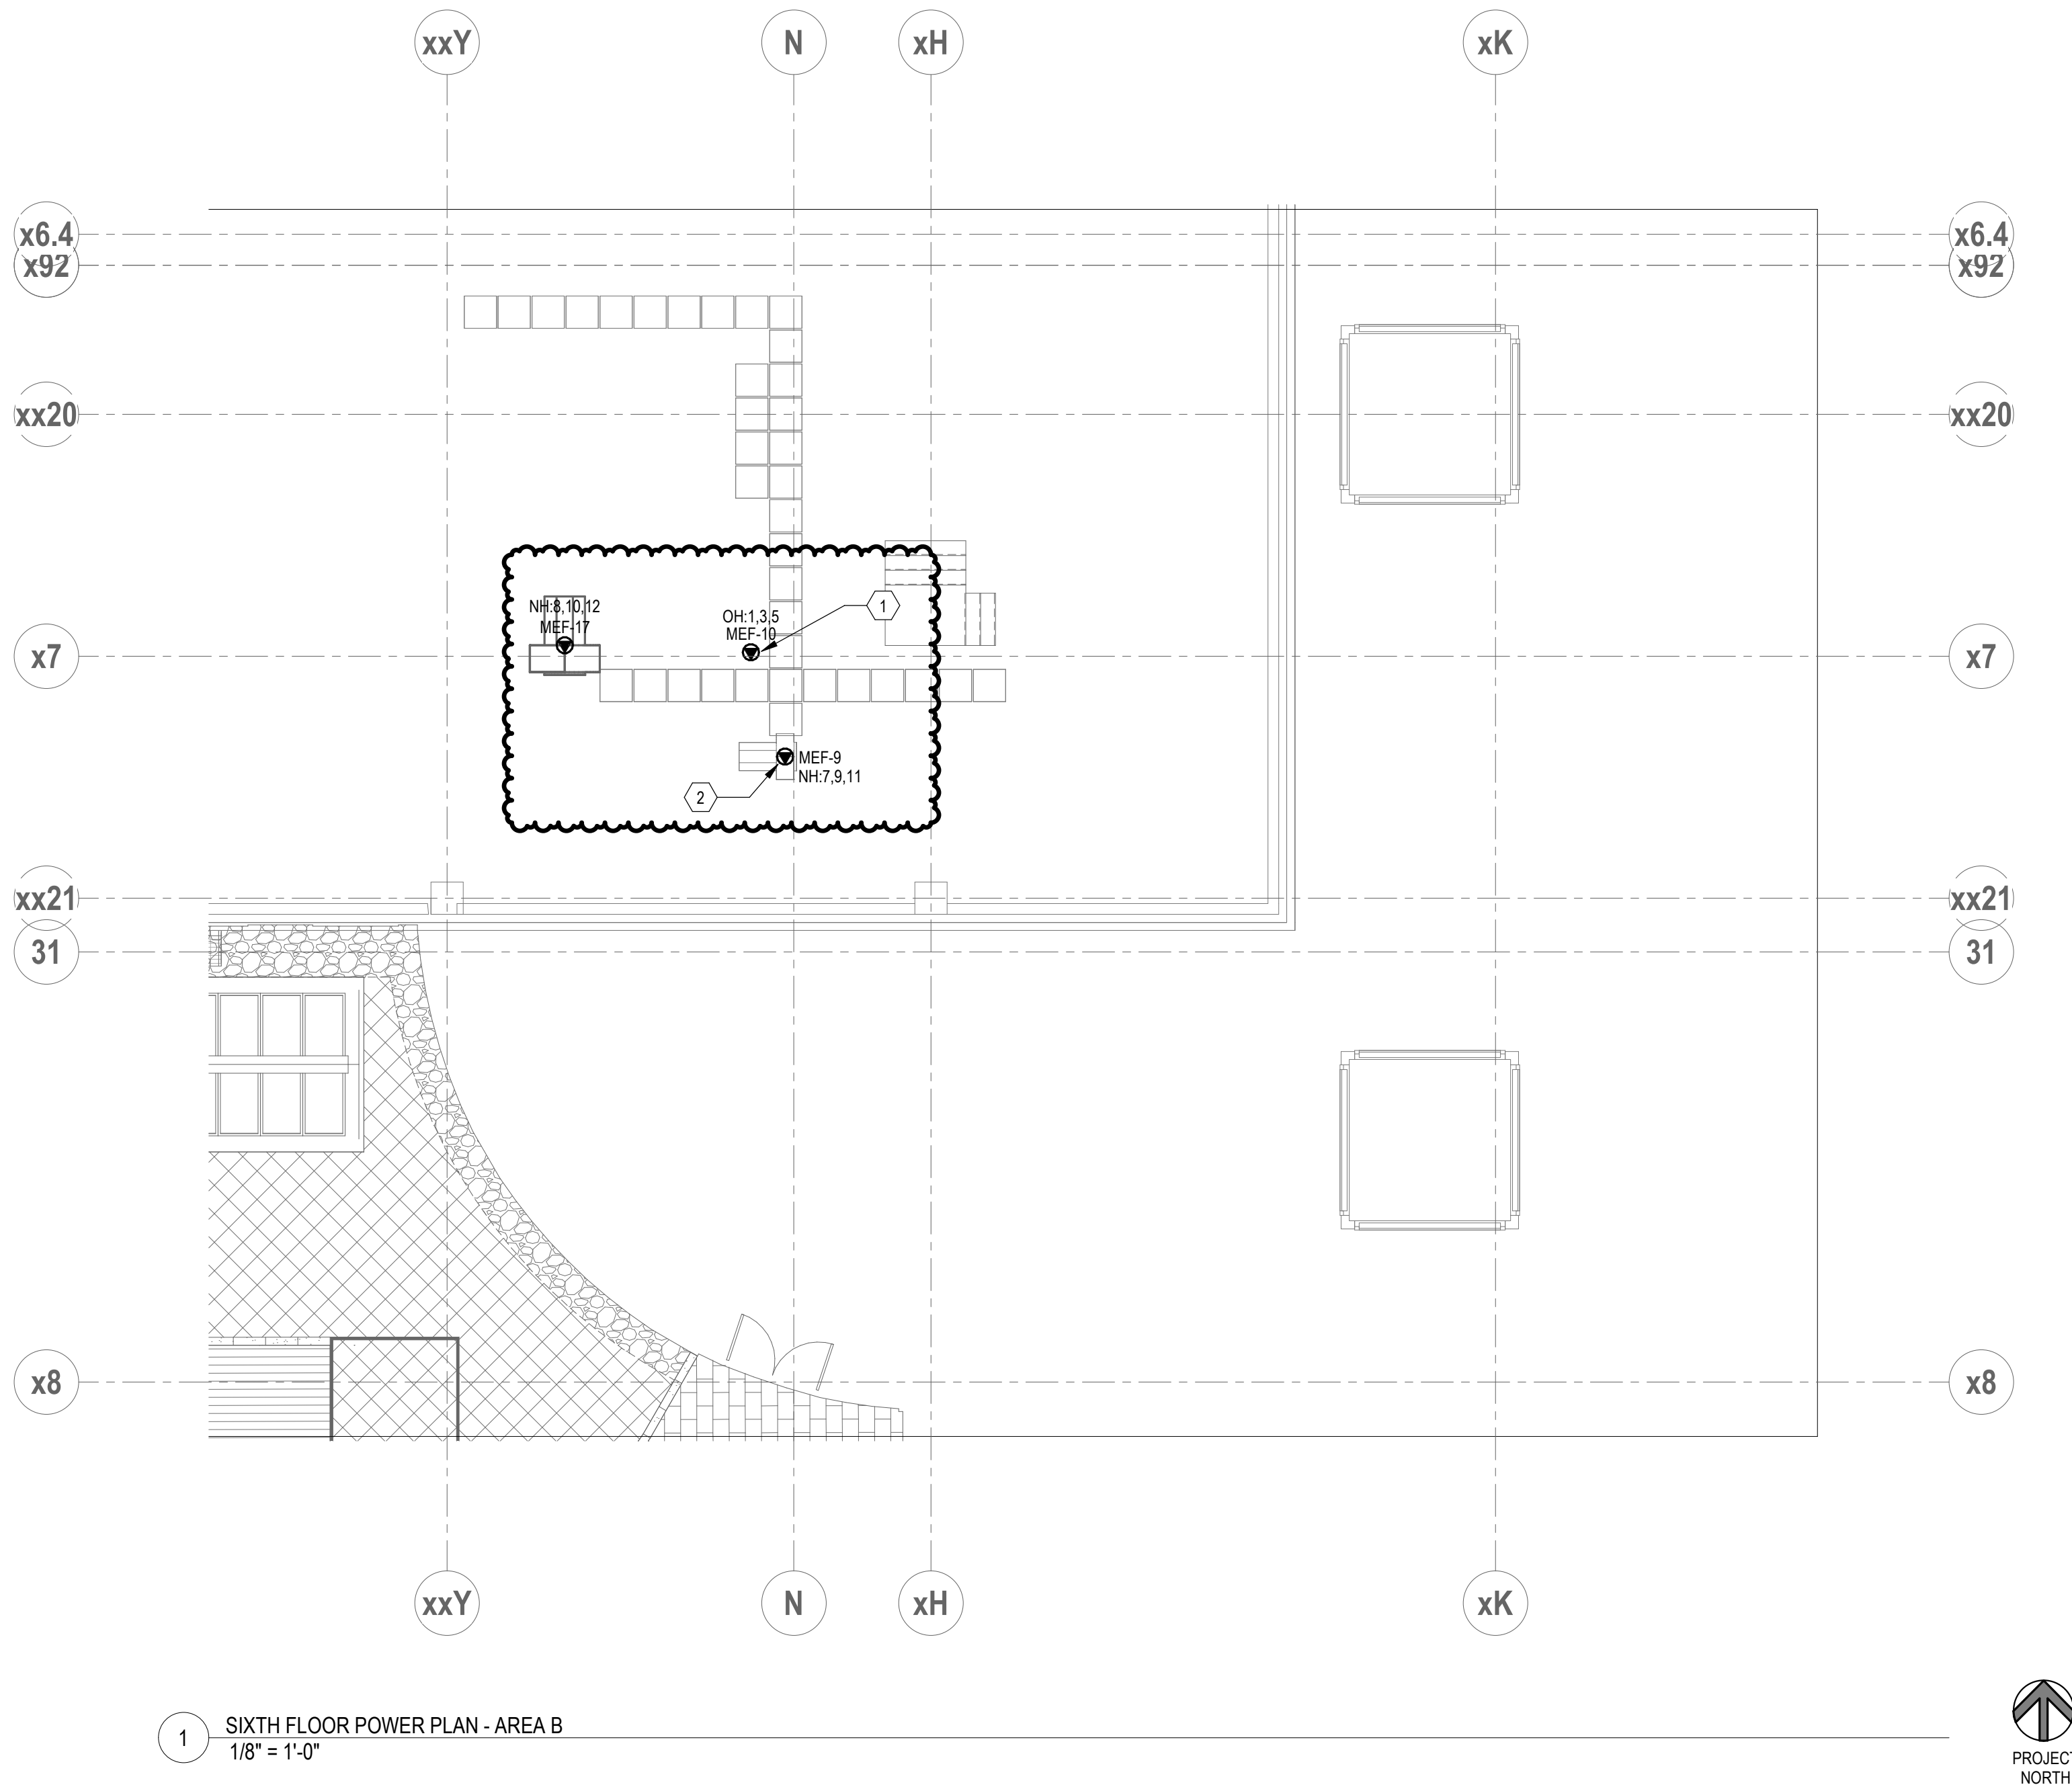


SHEET NOTES

- A. REFER TO ARCHITECTURAL PLANS, ELEVATIONS, AND DETAILS FOR LOCATIONS AND MOUNTING HEIGHTS OF ALL ELECTRICAL DEVICES PRIOR TO COMMENCING INSTALLATION.
- B. CIRCUIT NUMBERS INDICATED DO NOT REFLECT THE ACTUAL POSITION OF THE CIRCUIT BREAKERS IN THE PANEL, RATHER, THE NUMBERS INDICATE WHICH DEVICES ARE CONNECTED TO A COMMON CIRCUIT.
- C. EXISTING TO REMAIN, "EX", ON THIS PLAN REFERS TO THE STATUS OF BASIC ELECTRICAL DEVICES. THERE MAY BE SOME WORK REQUIRED IN THESE SPACES INVOLVING BACK-FEEDING EXISTING CIRCUITS OR OTHER MODIFICATIONS. SEE ALL DOCUMENTS THAT MAKE UP THIS CONTRACT FOR THE TOTAL EXTENT OF WORK REQUIRED IN ALL SPACES.
- D. SERVE ALL 480/277 VOLT, NORMAL BRANCH CIRCUITS "NH" WITHIN THIS BOUNDRY FROM PANEL "HSC", UNLESS OTHERWISE INDICATED.
- E. SERVE ALL 480/277 VOLT, 702 BRANCH CIRCUITS "OH" WITHIN THIS BOUNDRY FROM PANEL "EH5", UNLESS OTHERWISE INDICATED.

KEYNOTES


1. EXISTING MEF-10 IS BEING REMOVED AND REPLACE WITH A NEW EXHAUST FAN IN THE SAME LOCATION.
2. EXISTING MEF-9 IS REMAINING IN PLACE BUT THE FEEDER IS TO BE REPLACE TO ALLOW FOR THE NEW MOTOR CONTROLLER AND DISCONNECT TO BE INSTALLED.


WORKSHOP WORKSHOP ARCHITECTS, INC.	
201 E PITTSBURGH AVE #301 MILWAUKEE, WI 53204	
WORKSHOP ARCHITECTS 201 E PITTSBURGH AVE #301 MILWAUKEE, WI 53204	ARCHITECT
K. SINGH & ASSOCIATES 3636 N. 124TH STREET WAUWATOSA, WI 53222	CIVIL
SAIKI DESIGN 1110 S PARK STREET MADISON, WI 53715	LANDSCAPE
THORNTON TOMASETTI 320 E BUFFALO ST #603 MILWAUKEE, WI 53202	STRUCTURAL
RING & DUCHATEAU 17400 W CAPITOL DRIVE BROOKFIELD, WI 53045	MEP / FP
RIFFE ASSOCIATES 10660 RED CIRCLE DR, STE. 100 MINNEAPOLIS, MN 55343	FOOD SERVICE
SHEN MILSON & WILKE 125 S. WACKER DRIVE, SUITE 1510 CHICAGO, IL 60606	AV / IT


Board of Regents of the University of Wisconsin c/o UW System Administration	
	Project Location: 975 UNIVERSITY AVE MADISON, WISCONSIN 53706

GRAINGER HALL DINING EXPANSION AND RENOVATION UNIVERSITY OF WISCONSIN - MADISON MADISON, WISCONSIN 53706	
Sheet Title:	SIXTH FLOOR POWER PLAN - AREA B

Revisions:			
No.	Date:	By:	Description:
1	8/5/2025	ADDERSON/JP	

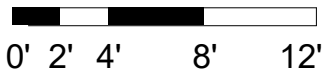Graphic Scale	
UWSA Number	A-24-004
Volume Number	2
MSN Number	9950-2307
Issued For	BID DOCUMENTS
Date Issued	06/20/2025
Sheet Number	E216B

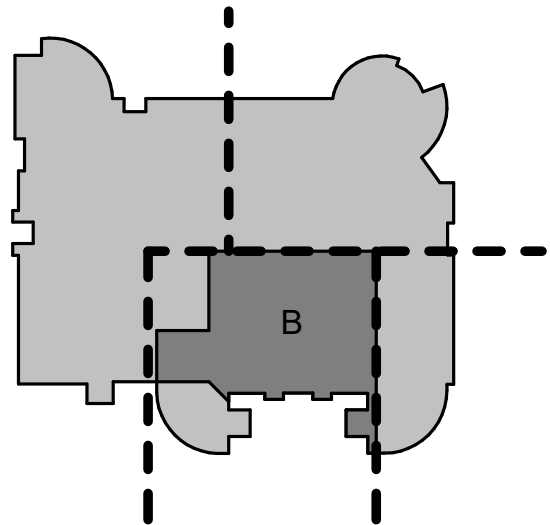

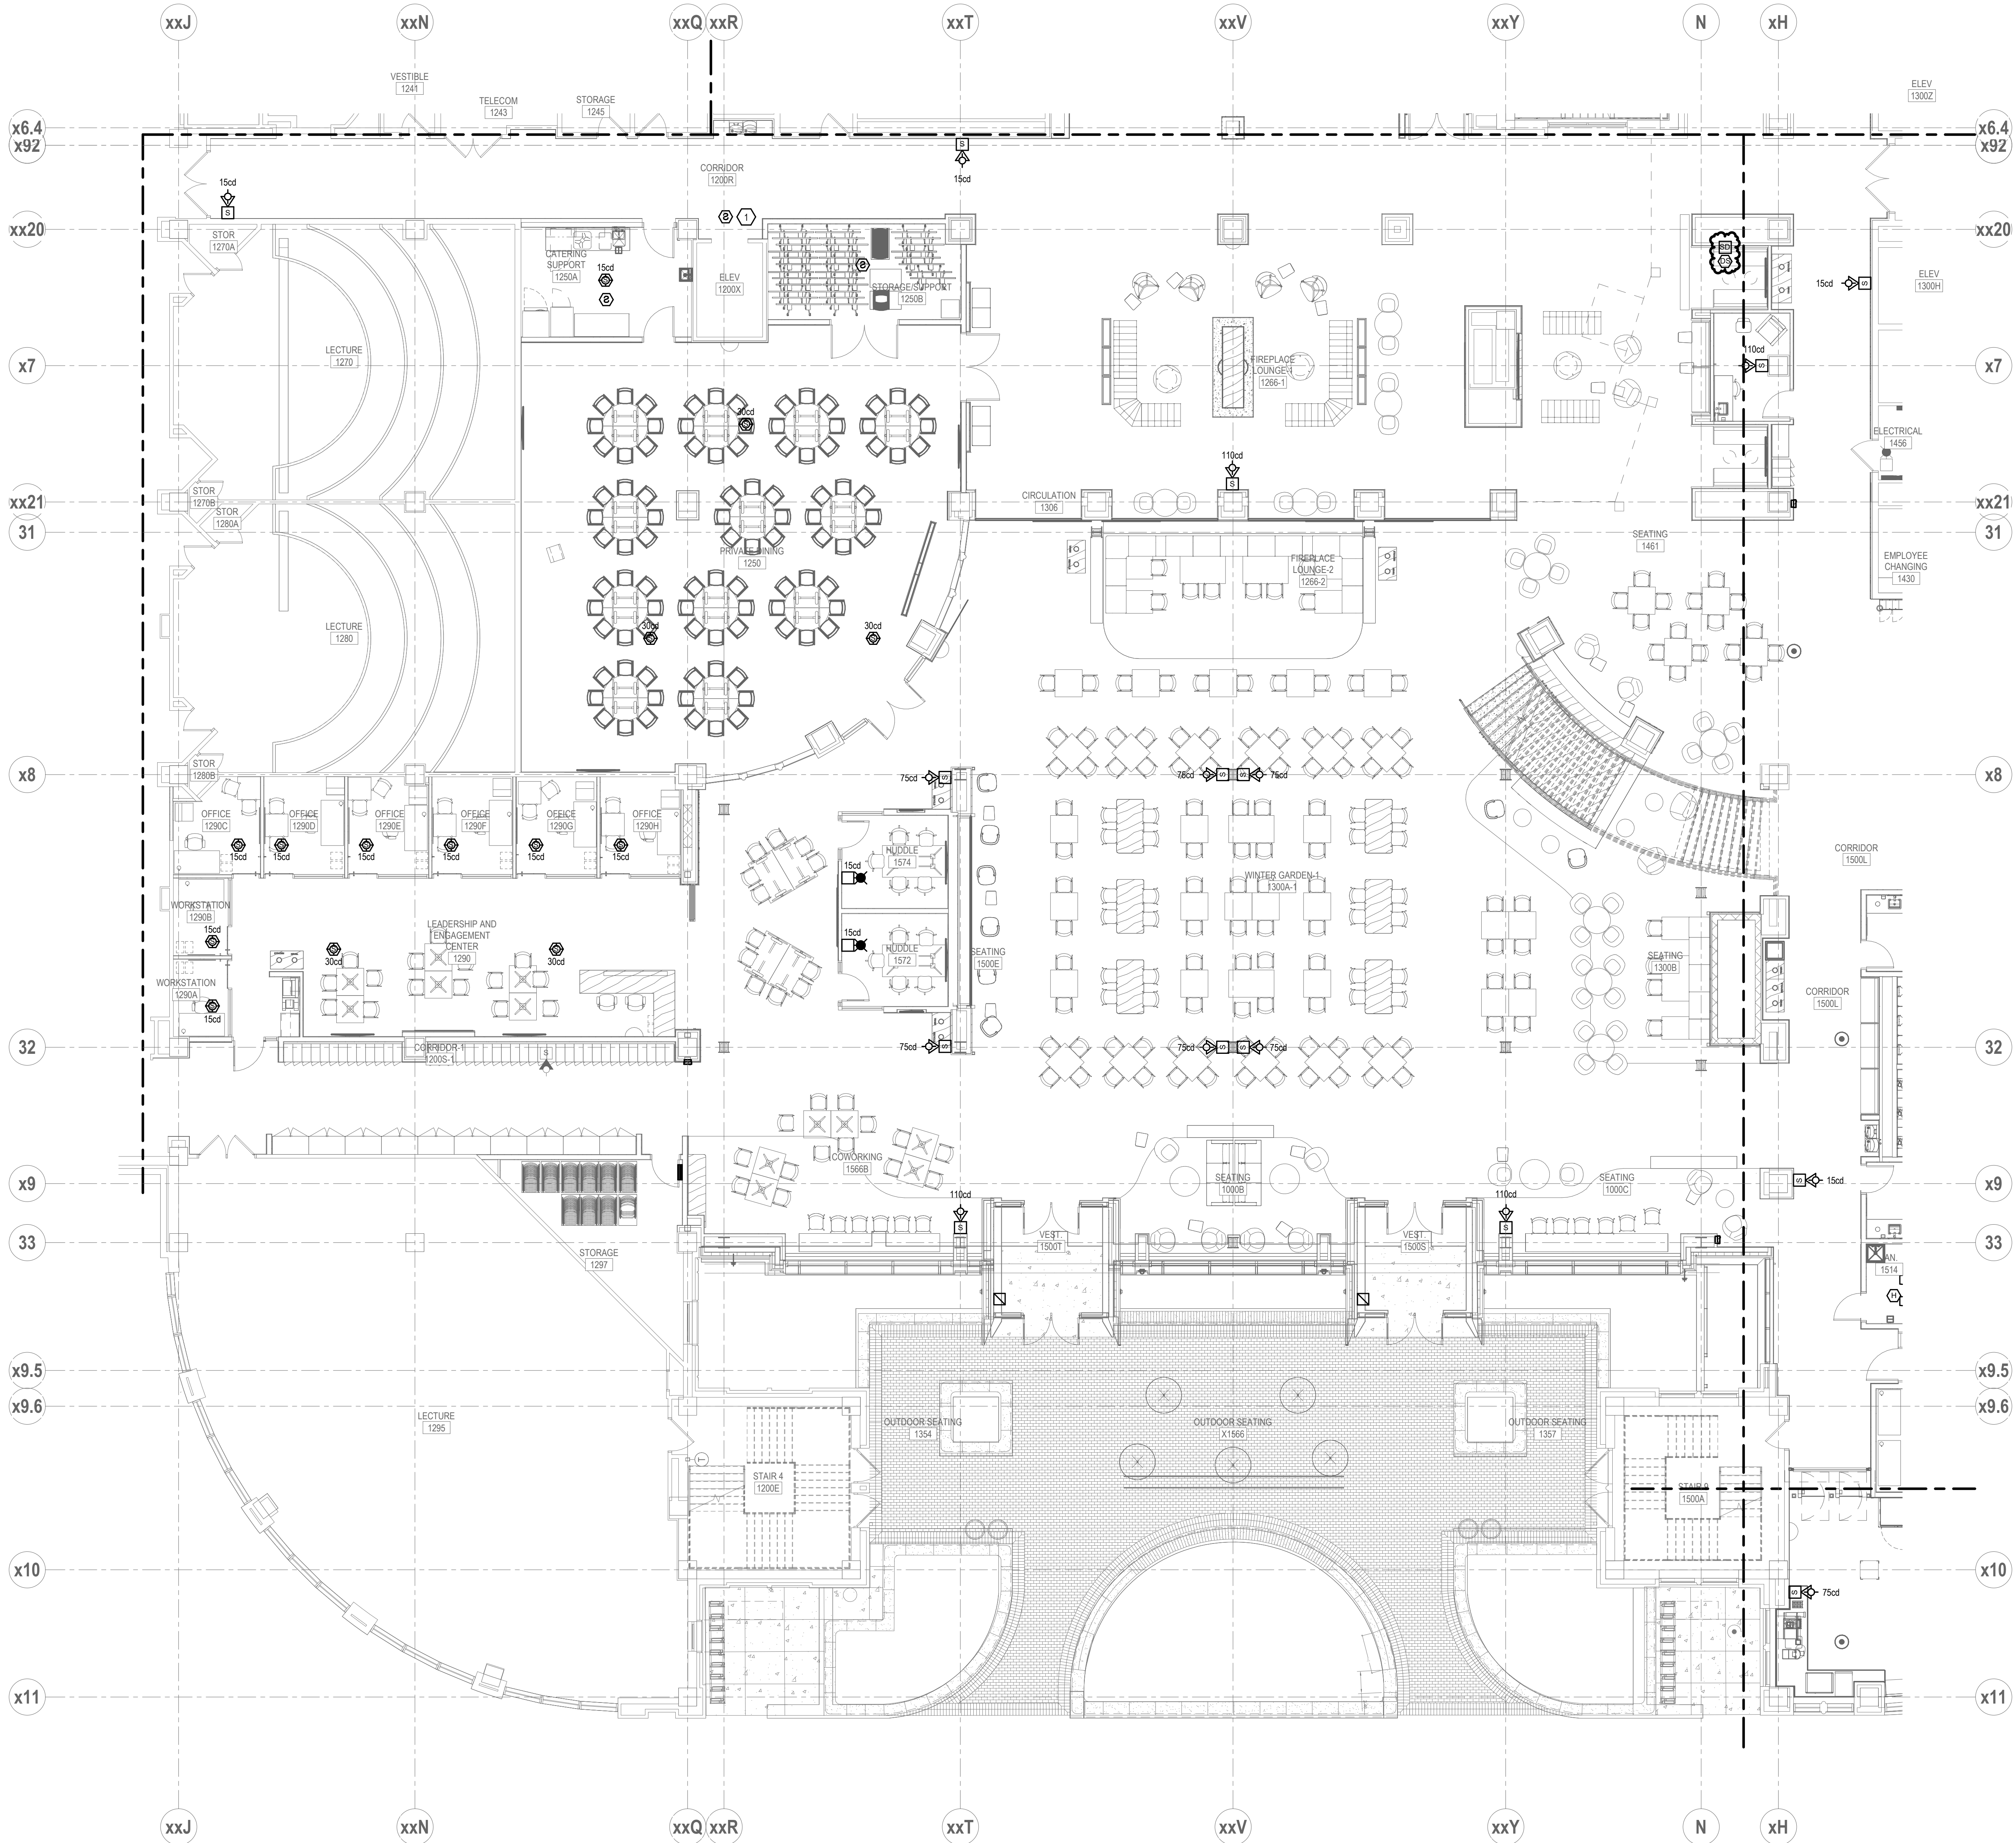

1 FIRST FLOOR FIRE ALARM PLAN
1/8" = 1'-0"

SHEET NOTES

- A. REFER TO ARCHITECTURAL PLANS, ELEVATIONS, AND DETAILS FOR LOCATIONS AND MOUNTING HEIGHTS OF ALL ELECTRICAL DEVICES PRIOR TO COMMENCING INSTALLATION.
- B. EXISTING TO REMAIN, "EX" ON THIS PLAN REFERS TO THE STATUS OF BASIC ELECTRICAL DEVICES. THERE MAY BE SOME WORK REQUIRED IN THESE SPACES INVOLVING BACK-FEEDING EXISTING CIRCUITS OR OTHER MODIFICATIONS. SEE ALL DOCUMENTS THAT MAKE UP THIS CONTRACT FOR THE TOTAL EXTENT OF WORK REQUIRED IN ALL SPACES.

KEYNOTES

1. TIE SMOKE DETECTOR WITHIN ELEVATOR LOBBY INTO THE ELEVATOR CONTROL SYSTEM.

WORKSHOP
WORKSHOP ARCHITECTS, INC.

201 E PITTSBURGH AVE #301
MILWAUKEE, WI 53204

WORKSHOP ARCHITECTS
201 E PITTSBURGH AVE #301
MILWAUKEE, WI 53204

K. SINGH & ASSOCIATES
3636 N. 124TH STREET
WAUWATOSA, WI 53222

SAIKI DESIGN
1110 S PARK STREET
MADISON, WI 53715

THORNTON TOMASETTI
330 E BUFFALO ST #603
MILWAUKEE, WI 53202

RING & DUCHATEAU
17400 W CAPITOL DRIVE
BROOKFIELD, WI 53045

RIPPE ASSOCIATES
10650 RED CIRCLE DR, STE. 100
MINNEAPOLIS, MN 55343

SHEN MILSON & WILKE
125 S. WACKER DRIVE, SUITE 1510
CHICAGO, IL 60606

ARCHITECT

CIVIL

LANDSCAPE


STRUCTURAL

MEP / FP

FOOD SERVICE

AV / IT

Board of Regents of the
University of Wisconsin
c/o UW System Administration





Project Location:
975 UNIVERSITY AVE
MADISON, WISCONSIN 53706


GRAINGER HALL DINING EXPANSION AND
RENOVATION
UNIVERSITY OF WISCONSIN - MADISON
MADISON, WISCONSIN 53706

Sheet Title:
FIRST FLOOR FIRE ALARM PLAN - AREA B

Revisions:			
No.	Date:	By:	Description:
1	8/5/2025	ADP/RSJ/BJP	

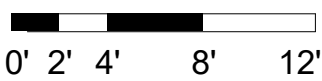
Graphic Scale	
UWSA Number	A-24-004
Volume Number	2
MSN Number	9950-2307
Issued For	BID DOCUMENTS
Date Issued	06/20/2025
Sheet Number	E231B

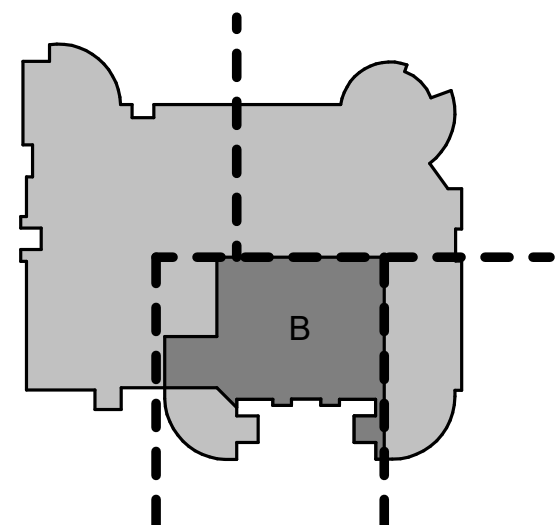

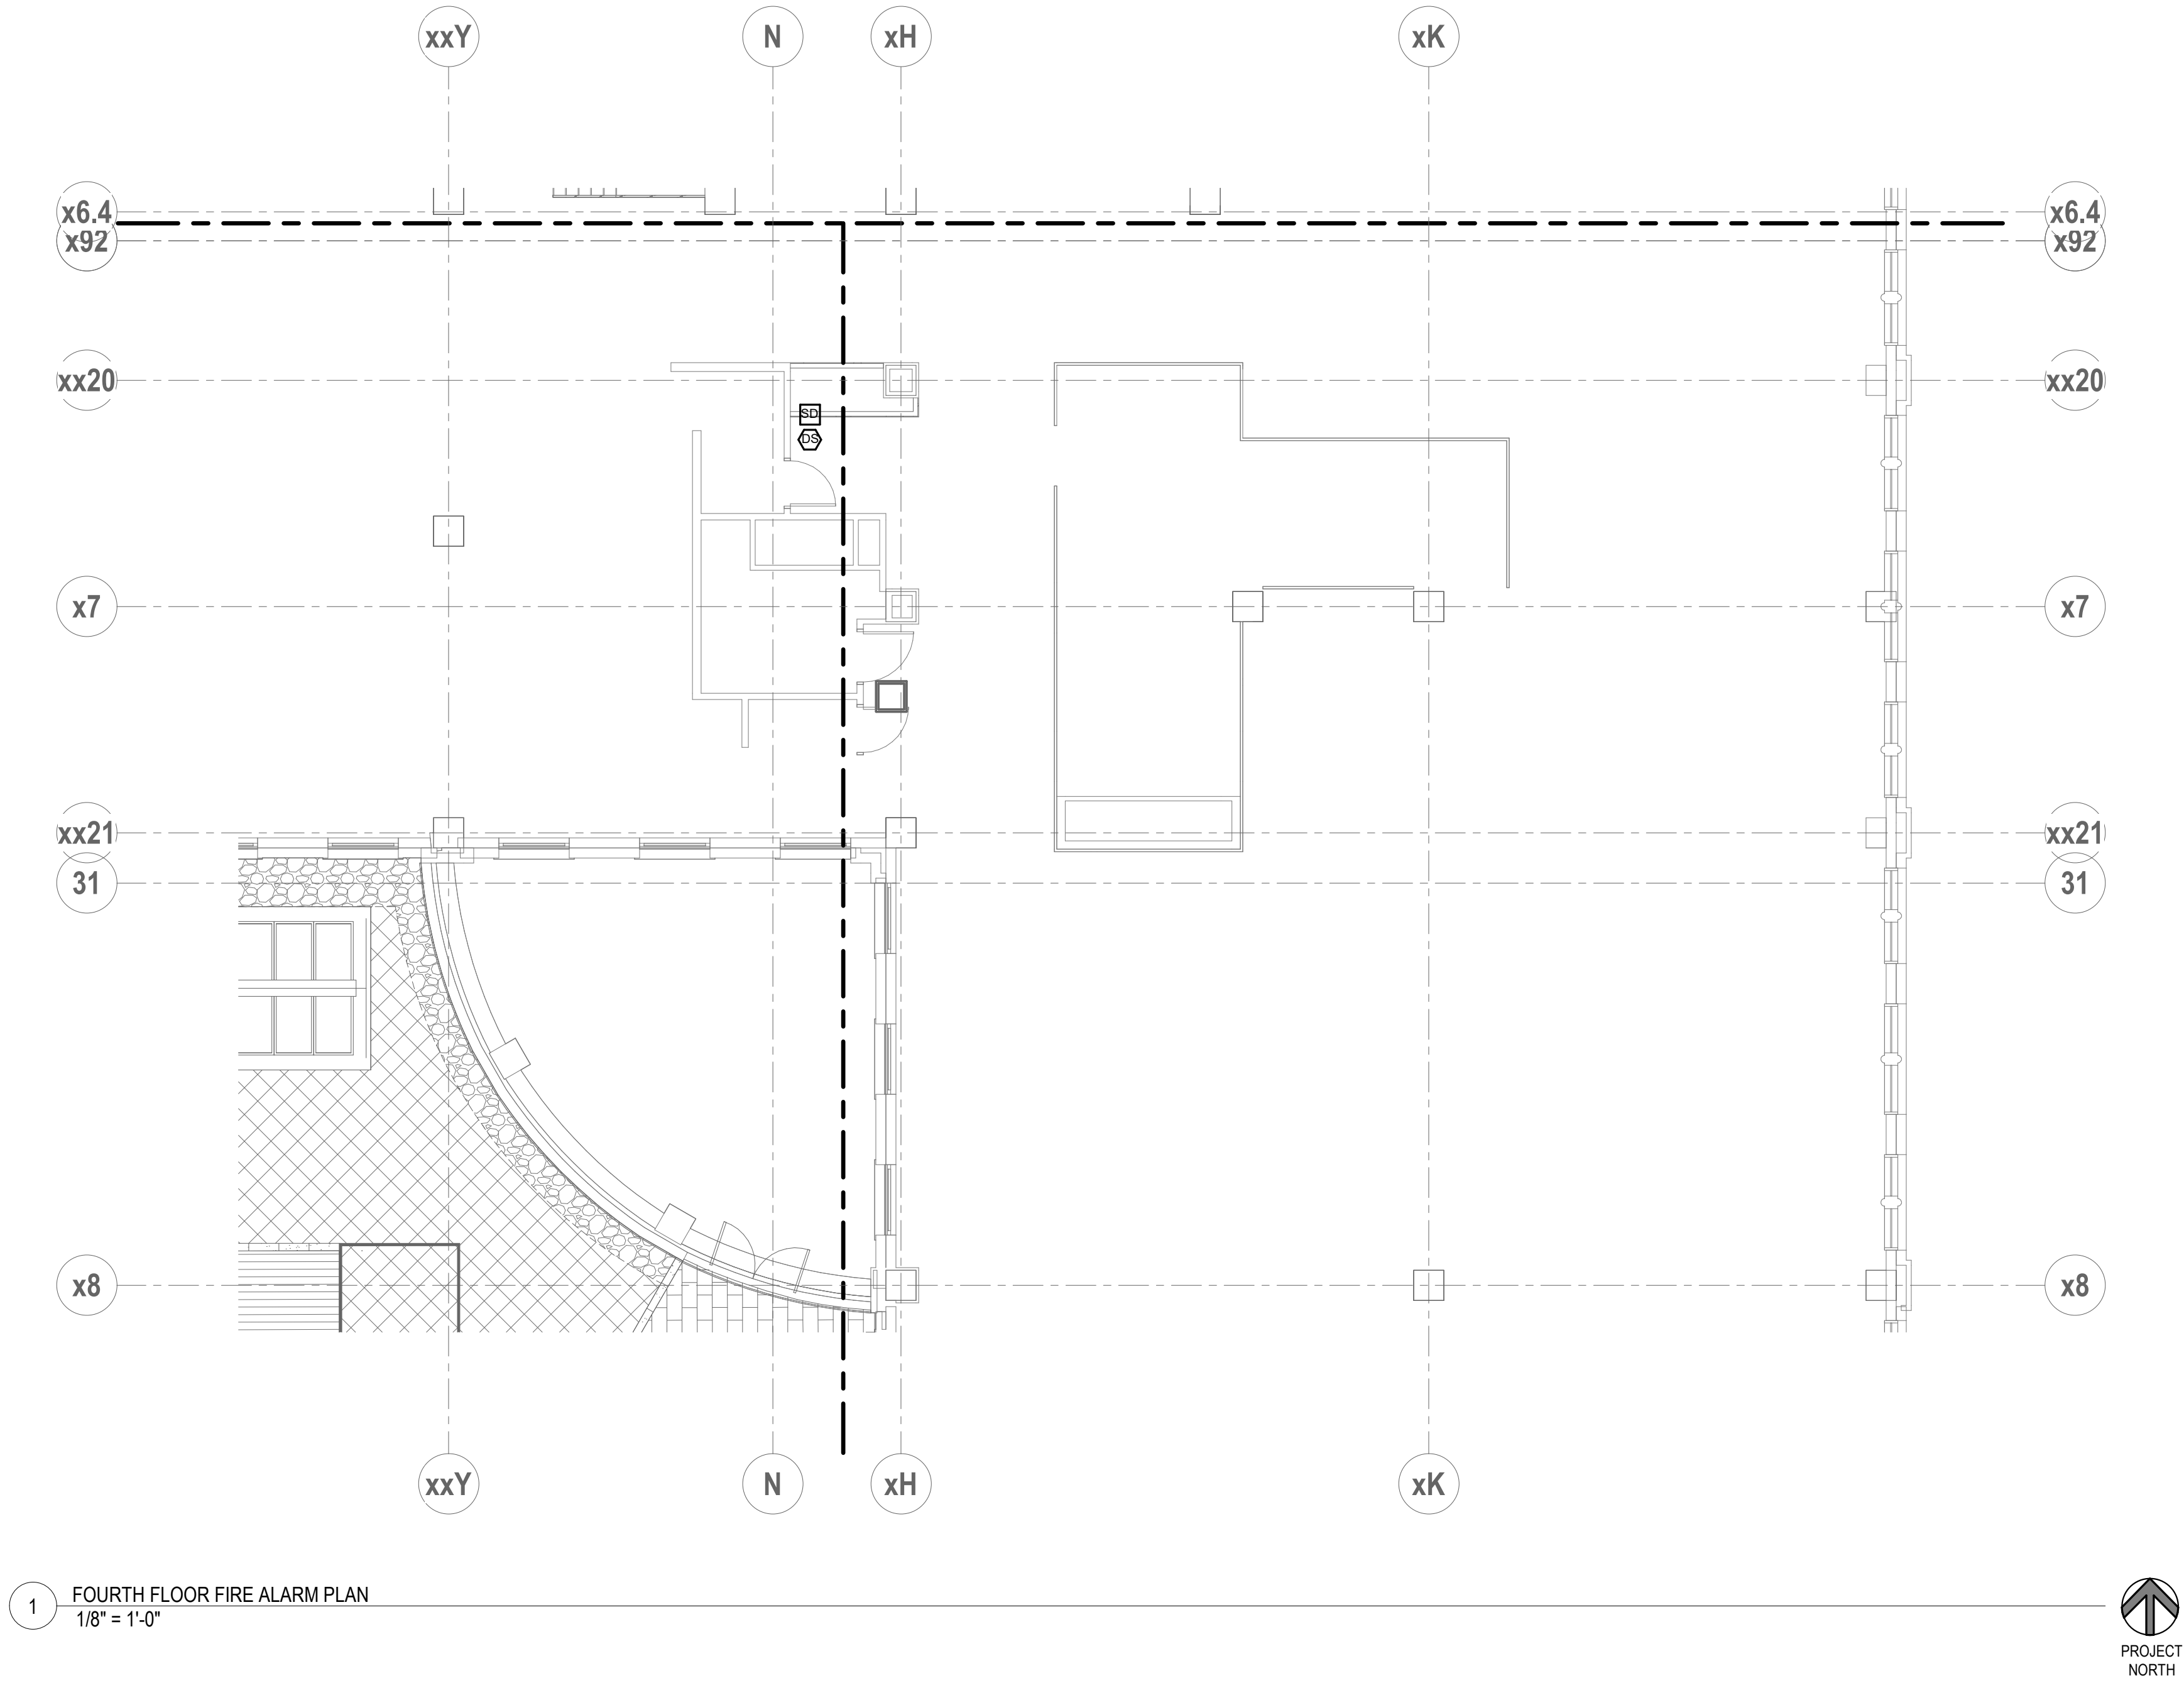

SHEET NOTES

- A. REFER TO ARCHITECTURAL PLANS, ELEVATIONS, AND DETAILS FOR LOCATIONS AND MOUNTING HEIGHTS OF ALL ELECTRICAL DEVICES PRIOR TO COMMENCING INSTALLATION.
- B. EXISTING TO REMAIN, "EX", ON THIS PLAN REFERS TO THE STATUS OF BASIC ELECTRICAL DEVICES. THERE MAY BE SOME WORK REQUIRED IN THESE SPACES INVOLVING BACK-FEEDING EXISTING CIRCUITS OR OTHER MODIFICATIONS. SEE ALL DOCUMENTS THAT MAKE UP THIS CONTRACT FOR THE TOTAL EXTENT OF WORK REQUIRED IN ALL SPACES.

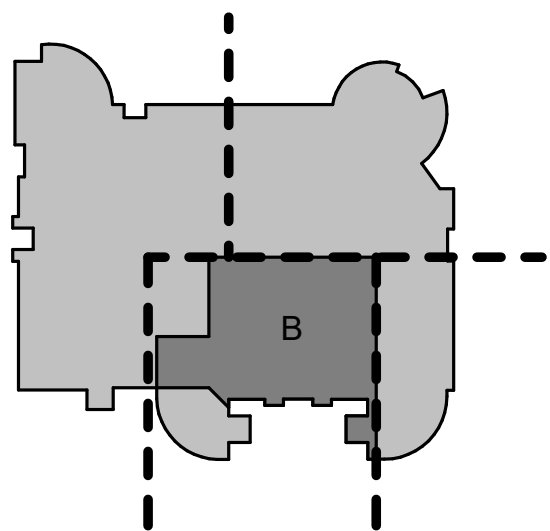

WORKSHOP ARCHITECTS, INC.

201 E PITTSBURGH AVE #301
MILWAUKEE, WI 53204

WORKSHOP ARCHITECTS
201 E PITTSBURGH AVE #301
MILWAUKEE, WI 53204

K. SINGH & ASSOCIATES
3636 N. 124TH STREET
WAUWATOSA, WI 53222

SAIKI DESIGN
1110 S PARK STREET
MADISON, WI 53715

THORNTON TOMASETTI
320 E BUFFALO ST #603
MILWAUKEE, WI 53202

RING & DUCHATEAU
17400 W CAPITOL DRIVE
BROOKFIELD, WI 53045

RIPPE ASSOCIATES
10660 RED CIRCLE DR, STE. 100
MINNEAPOLIS, MN 55343

SHEN MILSON & WILKE
125 S. WACKER DRIVE, SUITE 1510
CHICAGO, IL 60606

ARCHITECT
CIVIL
LANDSCAPE
STRUCTURAL
MEP / FP
FOOD SERVICE
AV / IT

Board of Regents of the
University of Wisconsin
c/o UW System Administration

Project Location:
975 UNIVERSITY AVE
MADISON, WISCONSIN 53706

GRAINGER HALL DINING EXPANSION AND
RENOVATION
UNIVERSITY OF WISCONSIN - MADISON
MADISON, WISCONSIN 53706

Sheet Title:
FOURTH FLOOR FIRE ALARM PLAN - AREA
B

Revisions:

No.	Date:	By:	Description:
1	8/5/2025	ADDERSDORF	

Graphic Scale
0' 2' 4' 8' 12'

UWSA Number
A-24-004


Volume Number
2

MSN Number
9950-2307

Issued For
BID DOCUMENTS

Date Issued
06/20/2025

Sheet Number
E234B

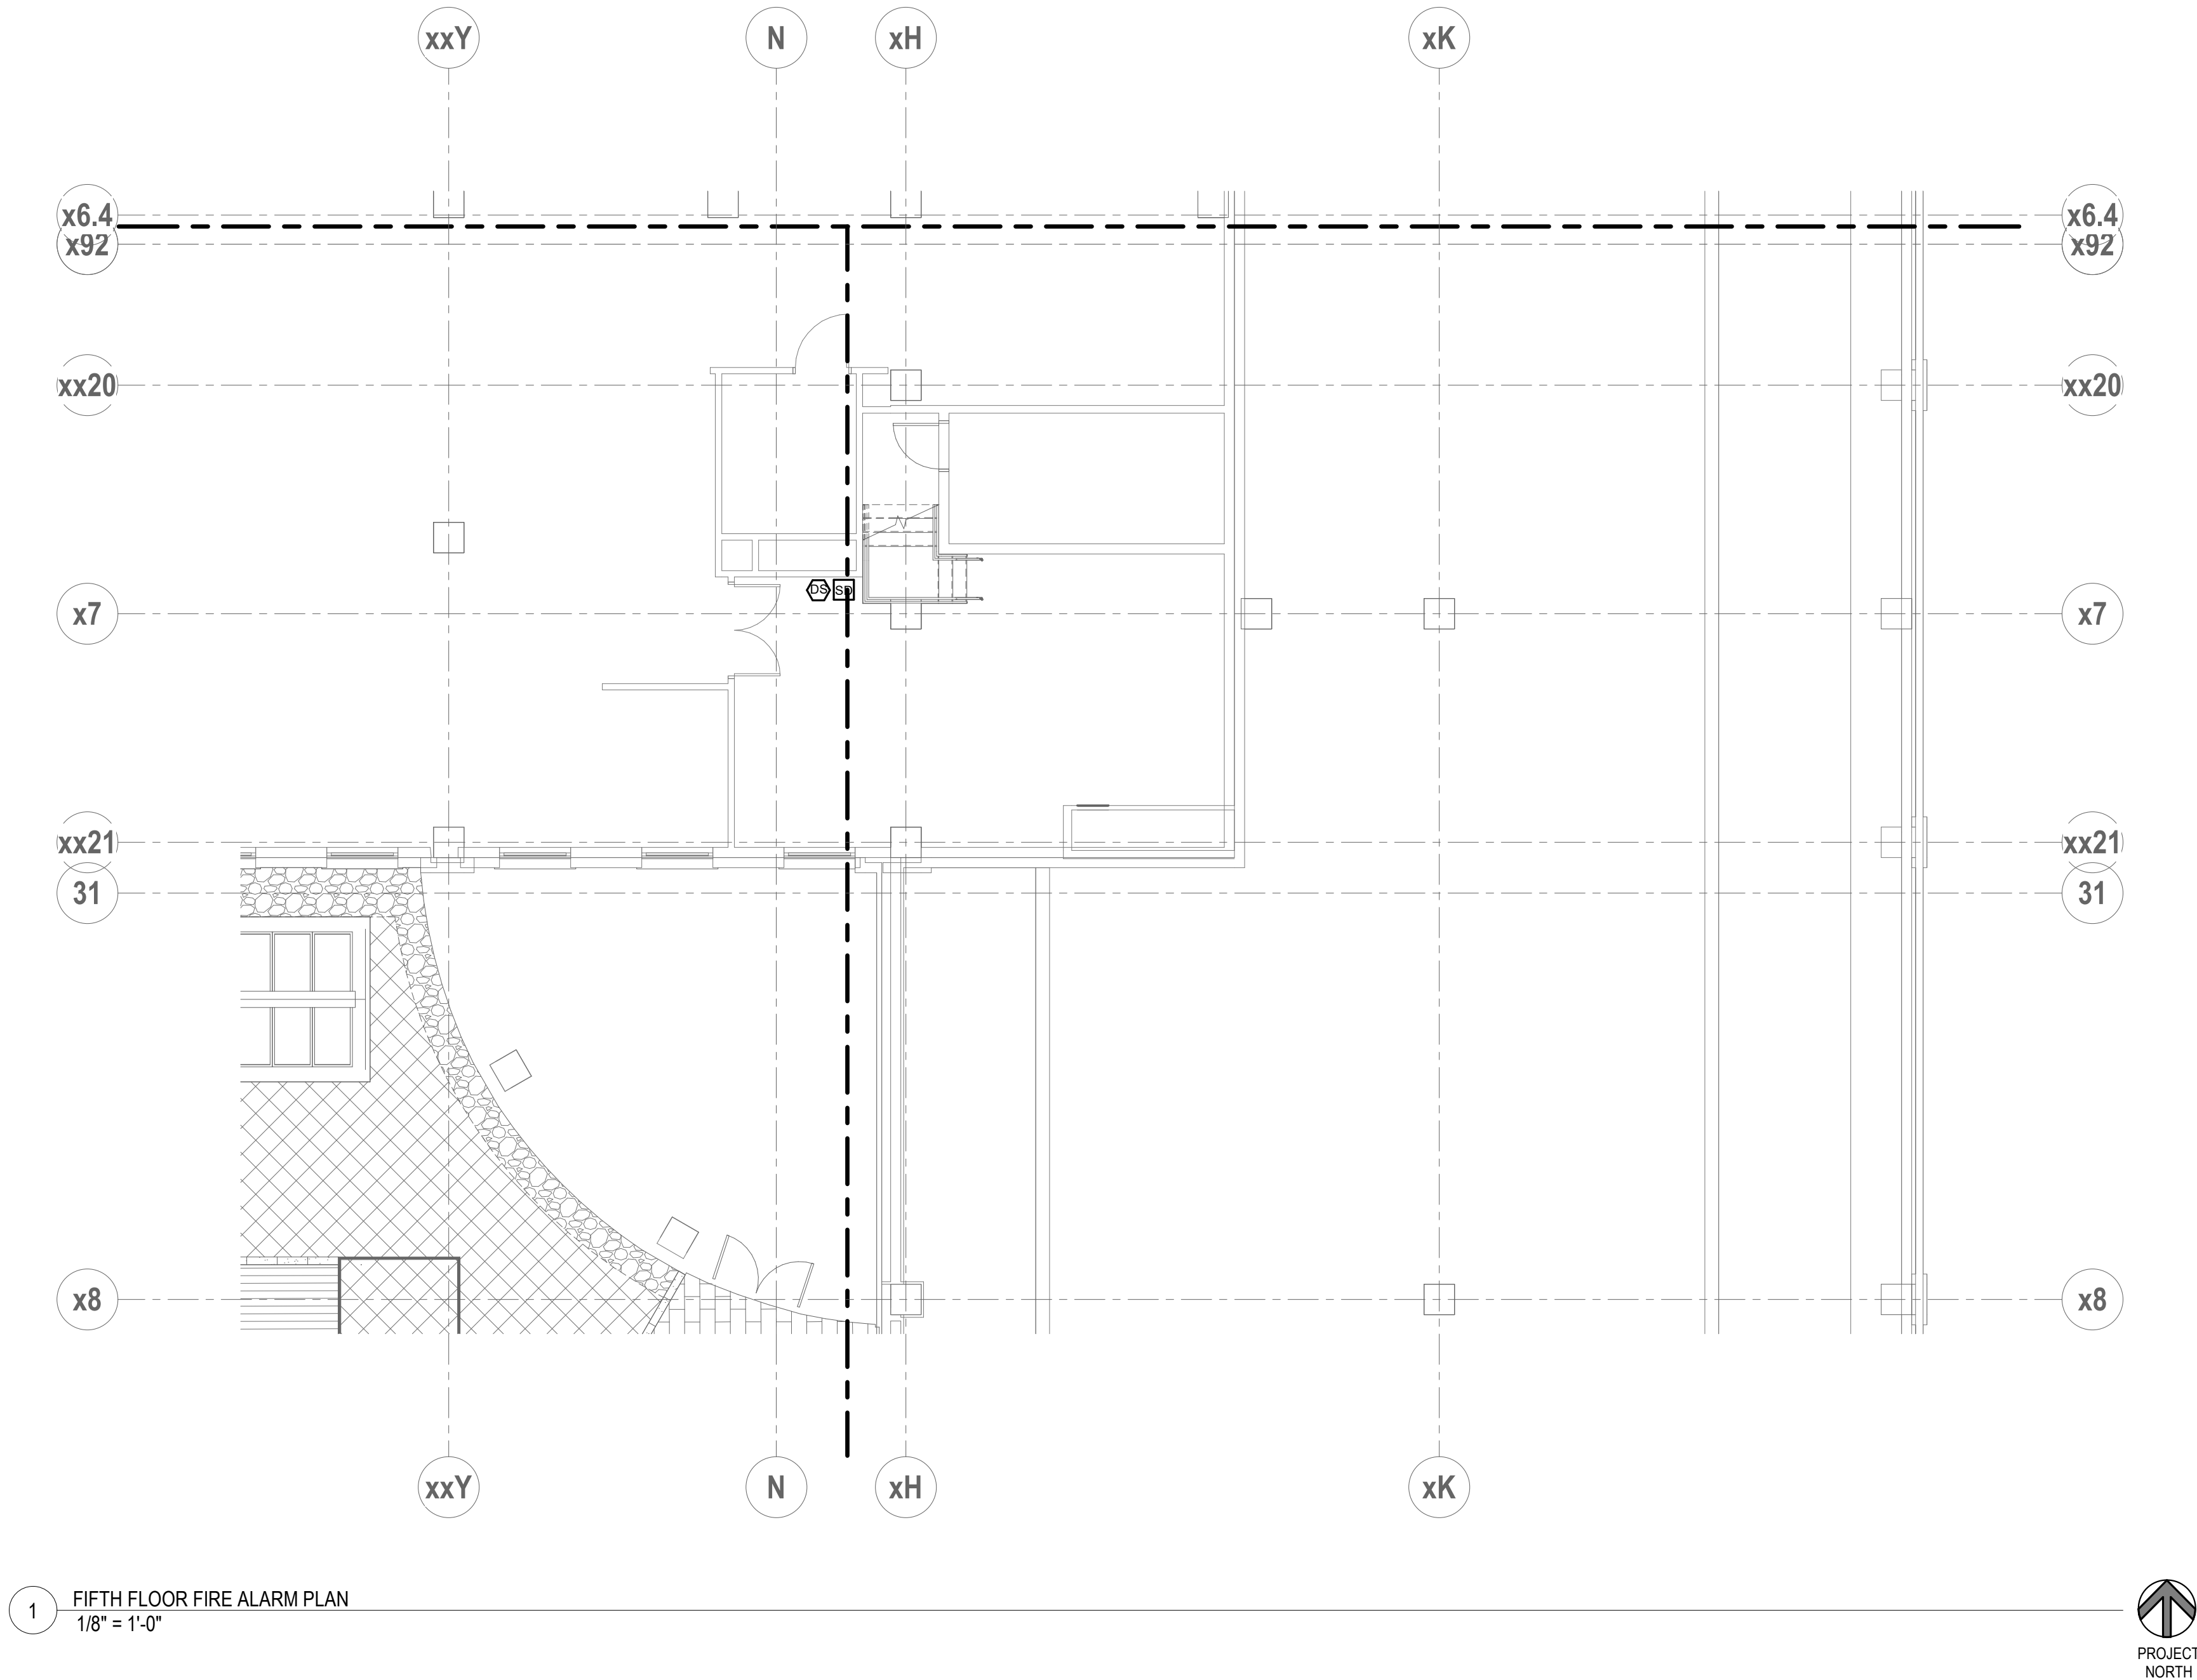

SHEET NOTES

- A. REFER TO ARCHITECTURAL PLANS, ELEVATIONS, AND DETAILS FOR LOCATIONS AND MOUNTING HEIGHTS OF ALL ELECTRICAL DEVICES PRIOR TO COMMENCING INSTALLATION.
- B. EXISTING TO REMAIN, "EX", ON THIS PLAN REFERS TO THE STATUS OF BASIC ELECTRICAL DEVICES. THERE MAY BE SOME WORK REQUIRED IN THESE SPACES INVOLVING BACK-FEEDING EXISTING CIRCUITS OR OTHER MODIFICATIONS. SEE ALL DOCUMENTS THAT MAKE UP THIS CONTRACT FOR THE TOTAL EXTENT OF WORK REQUIRED IN ALL SPACES.

WORKSHOP
WORKSHOP ARCHITECTS, INC.

201 E PITTSBURGH AVE #301
MILWAUKEE, WI 53204

WORKSHOP ARCHITECTS
201 E PITTSBURGH AVE #301
MILWAUKEE, WI 53204

K. SINGH & ASSOCIATES
3636 N. 124TH STREET
WAUWATOSA, WI 53222

SAIKI DESIGN
1110 S PARK STREET
MADISON, WI 53715

THORNTON TOMASETTI
320 E BUFFALO ST #603
MILWAUKEE, WI 53202

RING & DUCHATEAU
17400 W CAPITOL DRIVE
BROOKFIELD, WI 53045

RIFFE ASSOCIATES
10650 RED CIRCLE DR, STE. 100
MINNEAPOLIS, MN 55343

SHEN MILSOM & WILKE
125 S. WACKER DRIVE, SUITE 1510
CHICAGO, IL 60606

ARCHITECT

CIVIL

LANDSCAPE


STRUCTURAL

MEP / FP

FOOD SERVICE

AV / IT

Board of Regents of the
University of Wisconsin
c/o UW System Administration



Project Location:
975 UNIVERSITY AVE
MADISON, WISCONSIN 53706


GRAINGER HALL DINING EXPANSION AND
RENOVATION
UNIVERSITY OF WISCONSIN - MADISON
MADISON, WISCONSIN 53706

Sheet Title:
FIFTH FLOOR FIRE ALARM PLAN - AREA B

Revisions:

No.	Date:	By:	Description:
1	8/5/2025	ADDERSON/BJP	

Graphic
Scale



0' 2' 4' 8' 12'

UWSA
Number

A-24-004

Volume
Number

2

MSN
Number

9950-2307

Issued
For


BID DOCUMENTS

Date
Issued

06/20/2025

Sheet
Number

E235B

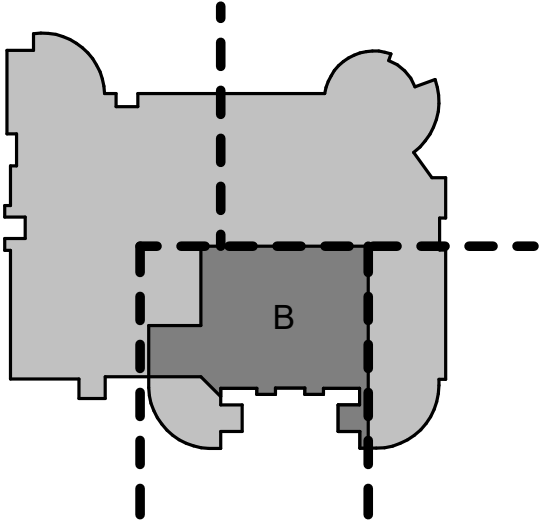

EQUIPMENT SCHEDULE - MECHANICAL																														
EQUIPMENT		LOCATION				LOAD		FED FROM		OCPD		FEEDER		MOTOR STARTER		DISCONNECT SWITCH		SCCR	CONNECTION		MTG HEIGHT	NOTES								
ID	DESCRIPTION	NAME	NO	VOLTAGE	PHASE	HP	FLA	KVA	PANEL	CIRCUIT	BRANCH	TYPE	SIZE	POLE	QTY	PHAS E	GRD	COND	FURN BY	INST BY	WIRE BY	LOC	TYPE	OPTIONS	FURN BY	INST BY	WIRE BY	LOC	OPTIONS	
MAHU-8 SERVICE	SERVICE LIGHTS	MECH.	P133	120	1	0	5	0.6	ELPB	CL.3	702	CB	20	1	1	#12	#12	3/4"												
MAHU-8-SF-1A	SUPPLY FAN ARRAY	MECH.	P133	480	3	25	34	28.3	EHPB	OH.7.9.11	702	CB	70	3	3	#4	#8	1-1/4"	MC	EC	EC	NU	VFDN	-	EC	EC	EC	NU	7	
MAHU-8-SF-1B	SUPPLY FAN ARRAY	MECH.	P133	480	3	25	34	28.3	EHPB	OH.13.15.17	702	CB	70	3	3	#4	#8	1-1/4"	MC	EC	EC	NU	VFDN	-	EC	EC	EC	NU	7	
MCP-1	STEAM CONDENSATE PUMP	MECH.	P133	208	3	0.5	2.4	0.9	LPC (EXISTING)	NL.13.15.17	N	CB	20	3	3	#12	#12	3/4"	MFR	MFR	EC	OU	MAN	-	EC	EC	EC	NU	7	
MCH-1	CABINET UNIT HEATER	VEST.	1500T	120	1	0.17	4.4	0.5	L1C (EXISTING)	NL.6.1	N	CB	20	1	1	#12	#12	3/4"	MFR	MFR	EC	OU	MAN	-	EC	EC	EC	NU	7	
MCH-2	CABINET UNIT HEATER	VEST.	1500S	120	1	0.17	4.4	0.5	L1C (EXISTING)	NL.6.3	N	CB	20	1	1	#12	#12	3/4"	MFR	MFR	EC	OU	MAN	-	EC	EC	EC	NU	7	
MD-1	DESTRATIFICATION FAN	WINTER GARDEN-2	1300A-2	277	1	0	0.2	0	HCC (EXISTING)	NH.5	N	CB	20	1	1	#12	#12	3/4"	MC	EC	EC	NU	MAN	-	EC	EC	EC	NU	7	
MD-2	DESTRATIFICATION FAN	WINTER GARDEN-2	1300A-2	277	1	0	0.2	0	HCC (EXISTING)	NH.5	N	CB	20	1	1	#12	#12	3/4"	MC	EC	EC	NU	MAN	-	EC	EC	EC	NU	7	
MD-3	DESTRATIFICATION FAN	WINTER GARDEN-2	1300A-2	277	1	0	0.2	0	HCC (EXISTING)	NH.5	N	CB	20	1	1	#12	#12	3/4"	MC	EC	EC	NU	MAN	-	EC	EC	EC	NU	7	
MD-4	DESTRATIFICATION FAN	WINTER GARDEN-2	1300A-2	277	1	0	0.2	0	HCC (EXISTING)	NH.5	N	CB	20	1	1	#12	#12	3/4"	MC	EC	EC	NU	MAN	-	EC	EC	EC	NU	7	
MD-5	DESTRATIFICATION FAN	WINTER GARDEN-2	1300A-2	277	1	0	0.2	0	HCC (EXISTING)	NH.5	N	CB	20	1	1	#12	#12	3/4"	MC	EC	EC	NU	MAN	-	EC	EC	EC	NU	7	
MD-6	DESTRATIFICATION FAN	WINTER GARDEN-2	1300A-2	277	1	0	0.2	0	HCC (EXISTING)	NH.5	N	CB	20	1	1	#12	#12	3/4"	MC	EC	EC	NU	MAN	-	EC	EC	EC	NU	7	
MD-7	DESTRATIFICATION FAN	WINTER GARDEN-2	1300A-2	277	1	0	0.2	0	HCC (EXISTING)	NH.5	N	CB	20	1	1	#12	#12	3/4"	MC	EC	EC	NU	MAN	-	EC	EC	EC	NU	7	
MEF-9	CENTRIFUGAL EXHAUST FAN EXISTING	ROOF	480	3	2.5	4.8	4		HSC	NH.7.9.11	N	CB	15	3	3	#12	#12	3/4"	MC	EC	EC	NU	VFDS	-	EC	EC	EC	NU	7	
MEF-10	CENTRIFUGAL EXHAUST FAN	ROOF	480	3	2.5	4.8	4		HSC	NH.7.9.11	N	CB	15	3	3	#12	#12	3/4"	MC	EC	EC	NU	VFDS	-	EC	EC	EC	NU	7	
MEF-17	CENTRIFUGAL EXHAUST FAN	ROOF	480	3	5	7.6	6.3		HSC	NH.8.10.12	N	CB	15	3	3	#12	#12	3/4"	MC	EC	EC	NU	VFDS	-	EC	EC	EC	NU	7	
MFCU-8	FAN COIL UNIT	MECH.	P133	120	1	0.53	0.9		LPC (EXISTING)	NL.9	702	CB	20	1	1	#12	#12	3/4"	MFR	MFR	EC	OU	MAN	-	EC	EC	EC	NU	7	
MPCP-15A	INLINE PUMP	MECH.	P133	208	3	1	4.6	1.7	LPC (EXISTING)	NL.13.5	N	CB	20	3	3	#12	#12	3/4"	MC	EC	EC	NU	MAN	-	EC	EC	EC	NU	7	
MPCP-15B	INLINE PUMP	MECH.	P133	208	3	1	4.6	1.7	LPC (EXISTING)	NL.7.9.11	N	CB	20	3	3	#12	#12	3/4"	MC	EC	EC	NU	MAN	-	EC	EC	EC	NU	7	
MRF-9	RETURN AIR FAN	MECH.	P133	480	3	7.5	11	9.1	EHPB	OH.13.5	702	CB	20	3	3	#8	#10	1"	MC	EC	EC	NU	VFDN	-	EC	EC	EC	NU	7	
MRF-9	RETURN AIR FAN	MECH.	P133	480	3	7.5	11	9.1	EHPB	OH.19.21.23	702	CB	20	3	3	#8	#10	1"	MC	EC	EC	NU	VFDN	-	EC	EC	EC	NU	7	
MTCP-2	TEMPERATURE CONTROL PANEL	MECH.	P133	120	1	0	4.2	0.5	ELPB	CL.1	702	CB	20	1	1	#12	#12	3/4"	-	-	-	-	-	-	-	EC	EC	NU	7	
MTCP-2	TEMPERATURE CONTROL PANEL	STORAGE	1225	120	1	0	4.2	0.5	1/1" R (EXISTING)	NL.35	N	CB	20	1	1	#12	#12	3/4"	-	-	-	-	-	-	-	EC	EC	EC	NU	7
MTCP-3	TEMPERATURE CONTROL PANEL	STORAGE	1297	120	1	0	4.2	0.5	1/1" R (EXISTING)	NL.37	N	CB	20	1	1	#12	#12	3/4"	-	-	-	-	-	-	-	EC	EC	EC	NU	7

KITCHEN EQUIPMENT SCHEDULE - TYPICAL

EQUIPMENT		LOCATION				LOAD		FED FROM		OCPD		FEEDER		MOTOR STARTER		DISCONNECT SWITCH		SCCR	CONNECTION		MTG HEIGHT	NOTES							
ID	DESCRIPTION	NAME	NO	VOLTAGE	PHASE	HP	FLA	KVA	PANEL	CIRCUIT	BRANCH	TYPE	SIZE	POLE	QTY	PHASE	GRD	COND	FURN BY	INST BY	WIRE BY	LOC	TYPE	OPTIONS	FURN BY	INST BY	WIRE BY	LOC	OPTIONS
K21	ICE DISPENSER W/SODA HEADS	RETAIL 1 - FOH	1464	120	1	0	3.5	0.4	LCP "A"	NL-3	N	CB	20	1	1	#12	#12	3/4"	-	-	-	-	-	-	-	-	-	-	-
K22	ICE MAKER	RETAIL 1 - FOH	1464	208	1	0	9.5	2	LCP "A"	NL-5.7	N	CB	20	2	2	#12	#12	3/4"	-	-	-	-	-	-	-	-	-	-	-
K23	SODA SYSTEM CARBONATOR	RETAIL 1 - FOH	1464	120	1	0	7.2	0.9	LCP "A"	NL-1	N	CB	20	1	1	#12	#12	3/4"	-	-	-	-	-	-	-	-	-	-	-
K28	REFRIGERATED DISPLAY CASE, SLIDE IN COUNTER	RETAIL 1 - FOH	1464	120	1	0	9.7	0.8	LCP "A"	NL-9	N	CB	20	1	1	#12	#12	3/4"	-	-	-	-	-	-	-	-	-	-	-
K29	P.O.S. SYSTEM	RETAIL 1 - FOH	1464	120	1	0	5	0.6	LCP "A"	NL-11	N	CB	20	1	1	#12	#12	3/4"	-	-	-	-	-	-	-	-	-	-	-
K31	UNDERCOUNTER REFRIGERATOR, 1-SEC.	RETAIL 1 - FOH	1464	120	1	0	2	0.2	LKLR	NL-7	N	CB	20	1	1	#12	#12	3/4"	-	-	-	-	-	-	-	-	-	-	-
K33	UNDERCOUNTER REFRIGERATOR, 1-SEC.	RETAIL 1 - FOH	1464	120	1	0	2	0.2	LKLR	NL-5	N	CB	20	1	1	#12	#12	3/4"	-	-	-	-	-	-	-	-	-	-	-
K34	DROP-IN COLD PAN, 4-WELL	RETAIL 1 - FOH	1464	120	1	0	5.9	0.5	LCP "A"	NL-2	N	CB	20	1	1	#12	#12	3/4"	-	-	-	-	-	-	-	-	-	-	-
K35	DROP-IN HOT PAN, 4-WELL	RETAIL 1 - FOH	1464	208	1	0	16	3.8	LCP "A"	NL-4.6	N	CB	25	2	2	#10	#10	3/4"	-	-	-	-	-	-	-	-	-	-	-
K36	TORTILLA WARMER GRILL	RETAIL 1 - FOH	1464	208	1	0	7.5	1.8	LCP "A"	NL-8.10	N	CB	20	2	2	#12	#12	3/4"	-	-	-	-	-	-	-	-	-	-	-
K37	HEATED HOLDING CABINET	RETAIL 1 - FOH	1464	120	1	0	16	1.9	LKLR	NL-9	N	CB	25	1	1	#10	#10	3/4"	-	-	-	-	-	-	-	-	-	-	-
K38	HEATED HOLDING CABINET	RETAIL 1 - FOH	1464	120	1	0	16	1.9	LKLR	NL-11	N	CB	25	1	1	#10	#10	3/4"	-	-	-	-	-	-	-	-	-	-	-
K39	EXHAUST HOOD (TYPE 1)	RETAIL 1 - FOH	1464	120	1	0	0.8	0.1	LKLR	NL-29	N	CB	20	1	1	#12	#12	3/4"	-	-	-	-	-	-	-	-	-	-	-
K40	UNDERCOUNTER REFRIGERATOR, 1-SEC.	RETAIL 1 - FOH	1464	120	1	0	2.3	0.3	LKLR	NL-3	N	CB	20	1	1	#12	#12	3/4"	-	-	-	-	-	-	-	-	-	-	-
K41A	VERTICAL BROTHER ELECTRIC	RETAIL 1 - FOH	1464	208	1	0	17.5	3.6	LKLR	NL-13.15	N	CB	25	2	2	#10	#10	3/4"	-	-	-	-	-	-	-	-	-	-	-
K42	FIRE PROTECTION SYSTEM	RETAIL 1 - FOH	1464	120	1	0	4.2	0.5	LKLR	NL-24	N	CB	20	1	1	#12	#12	3/4"	-	-	-	-	-	-	-	-	-	-	-
K43A	DEMAND CONTROL VENTILATION SYSTEM	RETAIL 1 - FOH	1464	120	1	0	4.2	0.5	LKLR	NL-22	N	CB	20	1	1	#12	#12	3/4"	-	-	-	-	-	-	-	-	-	-	-
K43B	VFD - EXHAUST	RETAIL 1 - FOH	1464	208	3	0	10.6	3.8	LKLR	NL-23.25.27	N	CB	20	3	3	#12	#12	3/4"	-	-	-	-	-	-	-	-	-	-	-
K44A	CONVECTION OVEN, 2-SEC. ELECTRIC	RETAIL 1 - FOH	1464	480	3	0	14	11	HKR	NH-13.5	N	CB	20	3	3	#12	#12	3/4"	-	-	-	-	-	-	-	-	-	-	-
K44B	CONVECTION OVEN, 2-SEC. ELECTRIC	RETAIL 1 - FOH	1464	480	3	0	14	11	HKR	NH-13.5	N	CB	20	3	3	#12	#12	3/4"	-	-	-	-	-	-	-	-	-	-	-
K45	COURTTOP GRIDDLE, ELECTRIC	RETAIL 1 - FOH	1464	480	3	0	19.5	10.8	HKR	NH-17.19.21	N	CB	25	3	3	#10	#10	3/4"	-	-	-	-	-	-	-	-	-	-	-
K46A	COURTTOP GRIDDLE, ELECTRIC	RETAIL 1 - FOH	1464	480	3	0	19.5	16.2	HKR	NH-18.20.22	N	CB	25	3	3	#10	#10	3/4"	-	-	-	-	-	-	-	-	-	-	-
K46B	COURTTOP GRIDDLE, ELECTRIC	RETAIL 1 - FOH	1464	480	3	0	19.5	10.8	HKR	NH-10.12.14	N	CB	25	3	3	#10	#10	3/4"	-	-	-	-	-	-	-	-	-	-	-
K47	UNDERCOUNTER WARMING CABINET	RETAIL 1 - FOH	1464	120	1	0	9	1.1	LKLR	NL-1	N	CB	20	1	1	#12	#12	3/4"	-	-	-	-	-	-	-	-	-	-	-
K48A	FRYER WILFITER, 2-SEC. & DUMP STATION, ELECTRIC	RETAIL 1 - FOH	1464	480	3	0	20	17	HKR	NH-25.27.29	N	CB	30	3	3	#10	#10	3/4"	-	-	-	-	-	-	-	-	-	-	-
K48B	FRYER WILFITER, 2-SEC. & DUMP STATION, ELECTRIC	RETAIL 1 - FOH	1464	120	1	0	5	0.6	LKLR	NL-9	N	CB	20	1	1	#12	#12	3/4"	-	-	-	-	-	-	-	-	-	-	-
K48C	FRYER WILFITER, 2-SEC. & DUMP STATION, ELECTRIC	RETAIL 1 - FOH	1464	480	3	0	20	17	HKR	NH-2.4.6	N	CB	30	3	3	#10	#10	3/4"	-	-	-	-	-	-	-	-	-	-	-
K49	AUTOMATIC LAVATORY	RETAIL 1 - FOH	1464	120	1	0	2	0.2	1/1" R (EXISTING)	NL-9	N	CB	20	1	1	#12	#12	3/4"	-	-	-	-	-	-	-	-	-	-	-
K49	AUTOMATIC LAVATORY	CATERING SUPPORT	1250A	120	1	0	2	0.2	1/1" R (EXISTING)	NL-19	N	CB	20	1	1	#12	#12	3/4"	-	-	-	-	-	-	-	-	-	-	-
K49	AUTOMATIC LAVATORY	RETAIL 1 - FOH	1464	120	1	0	2	0.2	LKLR	NL-41	N	CB	20	1	1	#12	#12	3/4"	-	-	-	-	-	-	-	-	-	-	-
K49	AUTOMATIC LAVATORY	RETAIL BOH	1464A	120	1	0	2	0.2	LKLR	NL-41	N	CB	20	1	1	#12	#12	3/4"	-	-	-	-	-	-	-	-	-	-	-
K49	AUTOMATIC LAVATORY	CATERING KITCHEN	1530	120	1	0	2	0.2	LKLC	NL-50	N	CB	20	1	1	#12	#12	3/4"	-	-	-	-	-	-	-	-	-	-	-
K49	AUTOMATIC LAVATORY	CATERING KITCHEN	1530	120	1	0	2	0.2	LKLC	NL-50	N	CB	20	1	1	#12	#12	3/4"	-	-	-	-	-	-	-	-	-	-	-
K49	AUTOMATIC LAVATORY	CATERING KITCHEN	1530	120	1	0	2	0.2	LKLC	NL-50	N	CB	20	1	1	#12	#12	3/4"	-	-	-	-	-	-	-	-	-	-	-
K49	AUTOMATIC LAVATORY	CATERING KITCHEN	1530	120	1	0	2	0.2	LKLC	NL-50	N	CB	20	1	1	#12	#12	3/4"	-	-	-	-	-	-	-	-	-	-	-
K49	AUTOMATIC LAVATORY	SERVICE KIOSK	3570	120	1	0	2	0.2	L3C (EXISTING)	NL-9	N	CB	20	1	1	#12	#12	3/4"	-	-	-	-	-	-	-	-	-	-	-
K52	REACH-IN FREEZER, 2-SEC.	RETAIL 1 - FOH	1464	120	1	0	9.4	1.1	LKLR	NL-20	N	CB	20	1	1	#12	#12	3/4"	-	-	-	-	-	-	-	-	-	-	-
K53	FOOD PICK-UP LOCKERS	CORRIDOR	1500L	120	1	0	10.8	1.3	LKLR	NL-18	N	CB	20	1	1	#12	#12	3/4"	-	-	-	-	-	-	-	-	-	-	-
K55	WALK-IN REFRIGERATOR	RETAIL BOH	1464A	120	1	0	16	1.9	LKLR	NL-16	N	CB	20	1	1	#12	#12	3/4"	-	-	-	-	-	-	-	-	-	-	-
K56	PACKED REFRIGRATION SYSTEM	MECH	1464	480	3	0	8.8	29	24.1	HPO (EXISTING)	NL-13.5	N	CB	35	3	3	#8	#10	1"	-	-	-	-	-	-	-	-	-	-
K57A	REFRIGERATED SYSTEM COIL	RETAIL BOH	1464A	120	1	0	1.8	0.2	LKLR	NL-14	N	CB	20	1	1	#12	#12	3/4"	-	-	-	-	-	-	-	-	-	-	-
K57B	REFRIGERATED SYSTEM COIL	RETAIL BOH	1464A	208	1	0	1.8	0.4	LKLR	NL-10.12	N	CB	20	2	2	#12	#12	3/4"	-	-	-	-	-	-	-	-	-	-	-
K57C	REFRIGERATED SYSTEM COIL	CATERING KITCHEN	1530	120	1	0	1.8	0.2	LKLC	NL-7	N	CB	20	1	1	#12	#12	3/4"	-	-	-	-	-	-	-	-	-	-	-
K57D	REFRIGERATED SYSTEM COIL	CATERING KITCHEN	1530	208	1	0	9.1	1.9	LKLC	NL-9.11	N	CB	20	2	2	#12	#12	3/4"	-	-	-	-	-	-	-	-	-	-	-
K58	DISPOSER	RETAIL BOH	1464A	208	3	0	6.6	2.4	LKLR	NL-2.4.6	N	CB	20	3	3	#12	#12	3/4"	-	-	-	-	-	-	-	-	-	-	-
K80	WASTE OIL COLLECTION SYSTEM	LOADING DOCK	1405	120	1	0	15	1.8	LKLC	NL-44	N	CB	20	1	1	#12	#12	3/4"	-	-	-	-	-	-	-	-	-	-	-
K81	FRESH OIL SYSTEM	LOADING DOCK	1405	120	1	0	15	1.8	LKLC	NL-46	N	CB	20	1	1	#12	#12	3/4"	-	-	-	-	-	-	-	-	-	-	-
K88	WALK-IN REFRIGERATOR/FREEZER COMPLEX	CATERING KITCHEN	1530	120	1	0	16	1.9	LKLC	NL-13	N	CB	20	1	1	#12	#12	3/4"	-	-	-	-	-	-	-	-	-	-	-
K89	WALK-IN REFRIGERATOR/FREEZER COMPLEX	CATERING KITCHEN	1530	120	1	0	16	1.9	LKLC	NL-15	N	CB	20	1	1	#12	#12	3/4"	-	-	-	-	-	-	-	-	-	-	-
K94	REACH-IN BLAST CHILLER	CATERING KITCHEN	1530	208	3	0	26.4	5.3	LKLC	NL-17.19.21	N	CB	35	3	3	#8	#10	3/4"	-	-	-	-	-	-	-	-	-	-	-
K95	EXHAUST HOOD (TYPE 1)	CATERING KITCHEN	1530	120	1	0	0.8	0.1	LKLC	NL-31	N	CB	20	1	1	#12	#12	3/4"	-	-	-	-	-	-	-	-	-	-	-
K97	FIRE PROTECTION SYSTEM	CATERING KITCHEN	1530	120	1	0	4.2	0.5	LKLC	NL-8	N	CB	20	1	1	#12	#12	3/4"	-	-	-	-	-	-	-	-	-	-	-
K98A	DEMAND CONTROL VENTILATION SYSTEM	CATERING KITCHEN	1530	120	1	0	4.2	0.5	LKLC	NL-33	N	CB	20	1	1	#12	#12	3/4"	-	-	-	-	-	-	-	-	-	-	-
K98B	EXHAUST	CATERING KITCHEN	1530	208	3	0	10.6	3.8	LKLC	NL-2.4.6	N	CB	20	3	3	#12	#12	3/4"	-	-	-	-	-	-	-	-	-	-	-
K99A	COMBI OVEN, 2-SEC. ELECTRIC	CATERING KITCHEN	1530	480	3	0	27	22.4	HKRC	NH-13.5	N	CB	35	3	3	#8	#10	3/4"	-	-	-	-	-	-	-	-	-	-	-
K99A	COMBI OVEN, 2-SEC. ELECTRIC	CATERING KITCHEN	1530	480	3	0	27	22.4	HKRC	NH-17.19.21	N	CB	35	3	3	#8	#10	3/4"	-	-	-	-	-	-	-	-	-	-	-
K99B	COMBI OVEN, 2-SEC. ELECTRIC	CATERING KITCHEN	1530	480	3	0	27	22.4	HKRC	NH-9.11.13	N	CB	35	3	3	#8	#10	3/4"	-	-	-	-	-	-	-	-	-	-	-
K99B	COMBI OVEN, 2-SEC. ELECTRIC	CATERING KITCHEN	1530	480	3	0	26.9	22.4	HKRC	NH-25.27.29	N	CB	35	3	3	#8	#10	3/4"	-	-	-	-	-	-	-	-	-	-	-
K103	INDUCTION RANGE W/CONVECTION OVEN	CATERING KITCHEN	1530	208	3	0	82.2	26.8	LKLC	NH-16.17	N	CB	35	3	3	#1	#12	1-1/2"	-	-	-	-	-	-</					

PANEL: 1/S (EXISTING)												
FED FROM: MAIN SIZE, TYPE: 100 A MAIN CB PANEL BUS AMPS: 100 AMPS PANEL TYPE:					PANEL LOCATION: STORAGE 1297 BRANCH: VOLTAGE: 120/208 1 Ø 3 W S.C.C.R: 10,000 AMPS... MOUNTING: SURFACE PANEL OPTIONS:							
CKT	LOAD DESCRIPTION		NOTE	OCPD	POLES	A	B	POLES	OCPD	NOTE	LOAD DESCRIPTION	CKT
NL1	RCPT RM 1290S, 1290A WORKSTATION			20 A	1	1.44						NL2
NL3	RCPT RM 1290D, 1290C OFFICE			20 A	1		1.44					NL4
NL5	RCPT RM 1290F, 1290E OFFICE			20 A	1	1.44						NL6
NL7	RCPT RM 1290G, 1290H OFFICE			20 A	1		1.44					NL8
NL9	RCPT RM 1250 PRIVATE DINING			20 A	1	1.26						NL10
NL11	RCPT PRIVATE CO-WORKING 1290			20 A	1		1.08					NL12
NL13	TPRT RM 1290 PRIVATE CO-WORKING			20 A	1	0						NL14
NL15	AVFPD-01 RM 1290 PRIVATE CO-WORKING			20 A	1							NL16
NL17	SCREENPROJECTOR RM 1290 PRIVATE...			20 A	1	1.5						NL18
NL19	RCPT RM 1250A CATERING SUPPORT			20 A	1		0.96					NL20
NL21	K165 - ROLL-IN REFRIGERATOR			20 A	1	1.07		0.23				NL22
NL23	K164 - UNDERCOUNTER REFRIGERATOR			20 A	1							NL24
NL25	K167 - MOBILE HEATED CABINET			20 A	1	1.4						NL26
NL27	RCPT RM 1290 PRIVATE CO-WORKING			20 A	1		0.36					NL28
NL29	AVFPD-02 RM 1290 PRIVATE DINING			20 A	1	1.5						NL30
NL31	AVAVIO-03 RM 1290 PRIVATE DINING			20 A	1		0.18					NL32
NL33	Equipment STORAGE/SUPPORT 1250B			20 A	1	1.5						NL34
NL35	SCREENPROJECTOR RM 1250 PRIVATE...			20 A	1		1.5					NL36
NL37	Equipment STORAGE 1297			20 A	1	0.5						NL38
NL39												NL40
NL41												NL42
Total Load:						11.608 kVA	8.19 kVA					
Total Amps:						107.2 A	78.8 A					
LOAD CLASSIFICATION			CONNECTED LOAD		N.E.C. DEMAND LOAD			PANEL TOTALS				
Equipment			10.798 kVA		10.798 kVA			CONNECTED LOAD: 19.798 kVA N.E.C. DEMAND LOAD: 19.798 kVA CONNECTED CURRENT: 95.2 A N.E.C. DEMAND CURRENT: 95.2 A				
RCPT			9 kVA		9 kVA							
NOTES:												

PANEL: EH5 (EXISTING)																
FED FROM:					PANEL LOCATION:											
MAIN SIZE, TYPE: 100 A MAIN CB					BRANCH:											
PANEL BUS AMPS: 100 AMPS					VOLTAGE: 480Y/277 3 Ø 4 W											
PANEL TYPE:					S.C.C.R: 14,000 AMPS...											
					MOUNTING: SURFACE											
					PANEL OPTIONS:											
CKT	LOAD DESCRIPTION	NOTE	OCPD	POLES	A	B	C	POLES	OCPD	NOTE	LOAD DESCRIPTION	CKT				
OH:1	MEF-10		15 A	3	1.33	1.33						OH:2				
OH:5							1.33					OH:4				
OH:7												OH:6				
OH:9								1.33				OH:8				
OH:11												OH:10				
OH:13												OH:12				
OH:15												OH:14				
OH:17												OH:16				
OH:19												OH:18				
OH:21												OH:20				
OH:23												OH:22				
OH:25												OH:24				
OH:27												OH:26				
OH:29												OH:28				
OH:31												OH:30				
OH:33												OH:32				
OH:35												OH:34				
OH:37												OH:36				
OH:39												OH:38				
OH:41												OH:40				
												OH:42				
					Total Load:	1.33 kVA	1.33 kVA	1.33 kVA								
					Total Amps:	4.8 A	4.8 A	4.8 A								
LOAD CLASSIFICATION					CONNECTED LOAD				N.E.C. DEMAND LOAD				PANEL TOTALS			
Equipment					3.991 kVA				3.991 kVA							
													CONNECTED LOAD: 3.991 kVA			
													N.E.C. DEMAND LOAD: 3.991 kVA			
													CONNECTED CURRENT: 4.8 A			
													N.E.C. DEMAND CURRENT: 4.8 A			
NOTES:																

PANEL: H5C													
FED FROM:					PANEL LOCATION:								
MAIN SIZE, TYPE: 100 A MAIN CB					BRANCH:								
PANEL BUS AMPS: 100 AMPS					VOLTAGE: 480Y/277 3 Ø 4 W								
PANEL TYPE:					S.C.C.R: 35,000 AMPS...								
					MOUNTING: SURFACE								
					PANEL OPTIONS:								
CKT	LOAD DESCRIPTION		NOTE	OCPD	POLES	A	B	C	POLES	OCPD	NOTE	LOAD DESCRIPTION	CKT
NH:1													NH:2
NH:3													NH:4
NH:5													NH:6
NH:7													NH:8
NH:9	MEF-9			15 A	3	1.33	2.11						NH:10
NH:11													NH:12
NH:13									3	15 A		MEF-17	NH:14
NH:15													NH:16
NH:17													NH:18
NH:19													NH:20
NH:21													NH:22
NH:23													NH:24
NH:25													NH:26
NH:27													NH:28
NH:29													NH:30
NH:31													NH:32
NH:33													NH:34
NH:35													NH:36
NH:37													NH:38
NH:39													NH:40
NH:41													NH:42
Total Load:						3.436 kVA	3.436 kVA	3.44 kVA					
Total Amps:						12.4 A	12.4 A	12.4 A					
LOAD CLASSIFICATION				CONNECTED LOAD			N.E.C. DEMAND LOAD			PANEL TOTALS			
Equipment				10.309 kVA			10.309 kVA			CONNECTED LOAD: 10.309 kVA			
										N.E.C. DEMAND LOAD: 10.309 kVA			
										CONNECTED CURRENT: 12.4 A			
										N.E.C. DEMAND CURRENT: 12.4 A			
NOTES:													

PANEL: L3C (EXISTING)												
FED FROM: MAIN SIZE, TYPE: 225 A MAIN CB PANEL BUS AMPS: 150 AMPS PANEL TYPE:					PANEL LOCATION: ELECTRICAL 3446 BRANCH: VOLTAGE: 208Y/120 3 Ø 4 W S.C.C.R: 10,000 AMPS... MOUNTING: SURFACE PANEL OPTIONS:							
CKT	LOAD DESCRIPTION	NOTE	OCPD	POLES	A	B	C	POLES	OCPD	NOTE	LOAD DESCRIPTION	CKT
NL1	RCPT ROOF TERRACE		20 A	1	0.54							NL2
NL3	RCPT ROOF TERRACE		20 A	1		0.54			0.54			NL4
NL5	RCPT ROOF TERRACE		20 A	1								NL6
NL7	RCPT		20 A	1	0.36							NL8
NL9	RCPT SERVICE KIOSK 3570		20 A	1		1.37						NL10
NL11	RCPT SERVICE KIOSK 3570		20 A	1			0.53					NL12
NL13	RCPT SERVICE KIOSK 3570		20 A	1	1.92							NL14
NL15	Equipment SERVICE KIOSK 3570		40 A	2		3.1						NL16
NL17								3.1				NL18
NL19	LITES		20 A	1	0.13							NL20
NL21	Equipment		20 A	1		0.5						NL22
NL23	CUH-25		20 A	1			0.7					NL24
NL25	MCUH-26		20 A	1	0							NL26
NL27												NL28
NL29												NL30
NL31												NL32
NL33												NL34
NL35												NL36
NL37												NL38
NL39												NL40
NL41												NL42
NL43												NL44
NL45												NL46
NL47												NL48
NL49												NL50
NL51												NL52
NL53												NL54
NL55												NL56
NL57												NL58
NL59												NL60
NL61												NL62
NL63												NL64
NL65												NL66
NL67												NL68
NL69												NL70
NL71												NL72
NL73												NL74
NL75												NL76
NL77												NL78
NL79												NL80
NL81												NL82
NL83												NL84
Total Load:					2.953 kVA	5.508 kVA	4.86 kVA					
Total Amps:					24.6 A	48.3 A	43 A					
LOAD CLASSIFICATION		CONNECTED LOAD		N.E.C. DEMAND LOAD		PANEL TOTALS						
LITES		0.133 kVA		0.167 kVA		CONNECTED LOAD: 13.325 kVA						
Equipment		7.636 kVA		7.636 kVA		N.E.C. DEMAND LOAD: 13.359 kVA						
RCPT		5.556 kVA		5.556 kVA		CONNECTED CURRENT: 37 A						
						N.E.C. DEMAND CURRENT: 37.1 A						
NOTES:												

GPC INVITATION TO BID (Rev 04/2024)
THE BOARD OF REGENTS OF THE UNIVERSITY OF WISCONSIN SYSTEM

GRAINGER HALL DINING EXPANSION AND RENOVATION
UNIVERSITIES OF WISCONSIN – MADISON
MADISON, WISCONSIN

UW- Madison Project No. 9950-2307 / UWSA Project No. A-24-004

BID OPENING for MEP BIDDERS: 2:00 P.M., August 19, 2025.

BID OPENING for GENERAL PRIME CONTRACTOR BIDDERS: 2:00 P.M., September 4, 2025.

OWNER: The Board of Regents of the Universities of Wisconsin System hereinafter termed the Owner.

NOTICE: All potential bidders must be certified by DOA prior to submitting bids on UW-Managed construction projects. All bids received from contractors who are not certified will be rejected. Contractor certification applications and instructions for completing the form may be obtained from the DOA Website DFD Contractor Certification page: <https://doa.wi.gov/Pages/DoingBusiness/ContractorCertification.aspx> .

This project is being let using a single prime bidding and contracting process. the Owner will publicly bid the applicable mechanical, electrical, plumbing, and fire protection (MEP) divisions of work **first**. Within five (5) days of the MEP bid opening, the Owner will identify a lowest, qualified, responsible, certified bidder in each applicable MEP division of work. These successful MEP bids must be included in all general prime contractor bids received. The owner will enter into a single contract with the lowest, qualified, responsible, certified general prime contractor and this general prime contractor shall enter into subcontracts with the successful MEP bidders. If a project does not include any mechanical, electrical, plumbing, or fire protection divisions of work, the Owner will bid one bid package for all work to general prime contractors.

The Universities of Wisconsin System Administration (UWSA) will ONLY be accepting construction bidding documents as follows:

- **PDF scanned file of all required bid documents, including bid and bid bond forms with an either original wet signatures or digital electronic signatures emailed to UWSA Bid Submissions at uwsabids submissions@wisconsin.edu.** If submitting documents with electronic signatures, further information and requirements are in the following bullets.
- Include Project Name, Project Number, Project Location, Category of Work being bid on, Bid Date, and the Name and Address of Bidder within email submission.
- For documents that require a seal, please darken these scans for better visibility.
- For bids including a cashier's/certified check, please scan front and back of check and include with submission.
- Bidders may submit PDFs of bonds and powers of attorney containing e-signatures, e-corporate seals, and e-notaries affixed to each document in accordance with the Surety's obligations. **Telephone numbers are required for all electronic signatories** for oral verification as needed. Wisconsin law permits the use of remote online notarization if it is performed **using technology providers that have been approved by the Department of Financial Institutions (DFI)**. If a remote online notarization is used, it is the responsibility of the contractor and its Surety to ensure that the technology provider has been approved by DFI.
- Bidders may submit bid forms containing electronic signatures, but those signatures must be obtained using approved software in order to be accepted. **DocuSign software and Adobe Digital Signature software are approved for e-signatures** for submission of bids. Use of any other e-signature software will require additional verification and the bidder must obtain approval at least three (3) business days prior to submission of bids. Please contact Lindsay.woznick@wisconsin.edu first regarding any proposed electronic signature software.

UWSA will NO LONGER accept bids via third party delivery (UPS, FEDEX, or DHL) or bids being dropped off in person.

BID FORM – GENERAL PRIME CONTRACTOR (GPC) (Rev 04/2024)
THE BOARD OF REGENTS OF THE UNIVERSITY OF WISCONSIN SYSTEM
s.16.855 Wis. Stats.

**GRAINGER HALL DINING EXPANSION AND RENOVATION
UNIVERSITY OF WISCONSIN - MADISON
MADISON, WISCONSIN**

UW- Madison Project No. 9950-2307 / UWSA Project No. A-24-004

General Prime Contractor (GPC) Bid Opening: 2:00 P.M., September 4, 2025.

To: Universities of Wisconsin System Administration (UWSA)

We _____
(a joint venture)
(a corporation)
(a partnership)
(an individual)
(Cross out inapplicable)

Of _____
Street City State Zip

hereby agree to execute a contract with the Board of Regents of the Universities of Wisconsin System (the Owner) and a subcontract with all successful MEP Bidders identified by the Owner and listed in this bid, and to furnish satisfactory separate 100% Performance Bond and 100% Payment Bond in the amount specified no later than ten (10) days of the contract offer, and to provide all labor and material required for the construction of the project designated above, for the prices hereinafter set forth, in strict accordance with the Contract Documents prepared by **Workshop Architects, 201 E. Pittsburgh Ave., Suite 301, Milwaukee, Wisconsin, 53204** for the Owner and dated **June 20, 2025**.

Contact Instructions:
(For use by Owner to offer contract to the successful bidders)

Contact name: _____

Title: _____

Telephone Number: _____

Email address: _____

IMPORTANT: BEFORE SUBMITTING YOUR BID, PLEASE VERIFY THAT:

441. You have been **certified by DOA as a qualified and responsible bidder** for the amount of your bid within the
- 45 division(s) of work being bid.
462. You have **entered all Bid amounts in numeric characters** (Example: \$9,999);
473. You have **acknowledged receipt of all addenda**;
484. You have **signed the Bid Form**
495. You have **included a valid Bid Guarantee** for not less than 10% of the value of the bid as either:
 - 50 a) a Bid Bond signed by the contractor and surety and with a Power of Attorney attached, **or**
 - 51 b) a Cashier's Check or Bank Check pursuant to Wis stats. s. 779.14(1m)(c)2.b. and 779.14(1s). A Company or
 - 52 Personal Check will not be accepted.
 - 53
 - 54

MEP INVITATION TO BID (Rev 04/2024)

THE BOARD OF REGENTS OF THE UNIVERSITIES OF WISCONSIN SYSTEM

GRAINGER HALL DINING EXPANSION AND RENOVATION
UNIVERSITIES OF WISCONSIN - MADISON
MADISON, WISCONSIN

UW-Madison Project No. 9950-2307 / UWSA Project No. A-24-004

BID OPENING for MEP BIDDERS: 2:00 P.M., August 19, 2025.

BID OPENING for GENERAL PRIME CONTRACTOR BIDDERS: 2:00 P.M., September 4, 2025.

OWNER: The Board of Regents of the Universities of Wisconsin System, hereinafter termed the Owner.

NOTICE: All potential bidders must be certified by DOA prior to submitting bids on UW-Managed construction projects. All bids received from contractors who are not certified will be rejected. Contractor certification applications and instructions for completing the form may be obtained from the DOA Website DFD Contractor Certification page: <https://doa.wi.gov/Pages/DoingBusiness/ContractorCertification.aspx>.

This project is being let using a single prime bidding and contracting process. the Owner will publicly bid the applicable mechanical, electrical, plumbing, and fire protection (MEP) divisions of work **first**. Within five (5) days of the MEP bid opening, the Owner will identify a lowest, qualified, responsible, certified bidder in each applicable MEP division of work. These successful MEP bids must be included in all general prime contractor bids received. No later than five (5) days after the Owner identifies the successful MEP bids, the Owner will publicly open general prime contractor bids. **General prime contractor bids that do not include the successful MEP bids will be rejected.** The owner will enter into a single contract with the lowest, qualified, responsible, certified general prime contractor and this general prime contractor shall enter into subcontracts with the successful MEP bidders.

The Universities of Wisconsin System Administration (UWSA) will ONLY be accepting construction bidding documents as follows:

- **PDF scanned file of all required bid documents, including bid and bid bond forms with an either original wet signatures or digital electronic signatures emailed to UWSA Bid Submissions at uwsabidsubmissions@wisconsin.edu. If submitting documents with electronic signatures, further information and requirements are in the following bullets.**
- Include Project Name, Project Number, Project Location, Category of Work being bid on, Bid Date, and the Name and Address of Bidder within email submission.
- For documents that require a seal, please darken these scans for better visibility.
- For bids including a cashier's/certified check, please scan front and back of check and include with submission.
- Bidders may submit PDFs of bonds and powers of attorney containing e-signatures, e-corporate seals, and e-notaries affixed to each document in accordance with the Surety's obligations. **Telephone numbers are required for all electronic signatories** for oral verification as needed. Wisconsin law permits the use of remote online notarization if it is performed **using technology providers that have been approved by the Department of Financial Institutions (DFI)**. If a remote online notarization is used, it is the responsibility of the contractor and its Surety to ensure that the technology provider has been approved by DFI.
- Bidders may submit bid forms containing electronic signatures, but those signatures must be obtained using approved software in order to be accepted. **DocuSign software and Adobe Digital Signature software are approved for e-signatures** for submission of bids. Use of any other e-signature software will require additional verification and the bidder must obtain approval at least three (3) business days prior to submission of bids. Please contact Lindsay.woznick@wisconsin.edu first regarding any proposed electronic signature software.

UWSA will NO LONGER accept bids via third party delivery (UPS, FEDEX, or DHL) or bids being dropped off in person at 780 Regent Street.

SECTION 23 07 00
HVAC INSULATION
BASED ON DFD MASTER SPECIFICATION DATED 3/27/2024

PART 1 - GENERAL

SCOPE

This section includes insulation specifications for heating, ventilating and air conditioning piping, ductwork and equipment. Included are the following topics:

PART 1 - GENERAL

- Scope
- Related Work
- Reference
- Reference Standards
- Quality Assurance
- Description
- Definitions
- Shop Drawings
- Operation and Maintenance Data
- Environmental Requirements

PART 2 - PRODUCTS

- Materials
- Insulation Types
- Adhesives, Mastics, Sealants, and Reinforcing Materials
- Jackets
- Insulation Inserts and Pipe Shields
- Expansion Joint and Valve Insulation Blankets
- Accessories

PART 3 - EXECUTION

- Examination
- Installation
- Protective Jacket Installation
- Piping, Valve and Fitting Insulation
- Piping Protective Jackets
- Removable Insulation Blankets
- Pipe Insulation Schedule
- Duct Insulation
- Ductwork Protective Coverings
- Duct Insulation Schedule
- Equipment Insulation
- Equipment Insulation Schedule
- Construction Verification Items

RELATED WORK

Section 01 91 01 or 01 91 02 – Commissioning Process

Section 23 05 00 - Common Work Results for HVAC

Section 23 08 00 - Commissioning of HVAC

Section	23 21 13	-	Hydronic	Piping
Section	23 22 13	-	Steam and Condensate	Heating

Section 23 83 16 - Radiant-Heating Hydronic Piping

Section 23 05 29 - Hangers and Supports for HVAC Piping and Equipment

Section 23 31 00 - HVAC Ducts and Casings

REFERENCE

Applicable provisions of Division 1 govern work under this section.

REFERENCE STANDARDS

ASTM B209	Aluminum and Aluminum Alloy Sheet and Plate
ASTM C165	Test Method for Compressive Properties of Thermal Insulations
ASTM C177	Heat Flux and Thermal Transmission Properties
ASTM C195	Mineral Fiber Thermal Insulation Cement
ASTM C240	Cellular Glass Insulation Block
ASTM C302	Density of Preformed Pipe Insulation
ASTM C272	Water Absorption of Core Materials for Sandwich Constructions

UWSA Project No.: A-24-004_9950-2307

23 07 00-1

ADDENDUM 1

1	ASTM C303	Density of Preformed Block Insulation
2	ASTM C355	Test Methods for Test for Water Vapor Transmission of Thick Materials
3	ASTM C449	Mineral Fiber Hydraulic Setting Thermal Insulation Cement
4	ASTM C518	Heat Flux and Thermal Transmission Properties
5	ASTM C533	Calcium Silicate Block and Pipe Thermal Insulation
6	ASTM C534	Preformed Flexible Elastomeric Thermal Insulation
7	ASTM C547	Mineral Fiber Preformed Pipe Insulation
8	ASTM C552	Cellular Glass Block and Pipe Thermal Insulation
9	ASTM C553	Mineral Fiber Blanket and Felt Insulation
10	ASTM C578	Preformed, Block Type Cellular Polystyrene Thermal Insulation
11	ASTM C591	Unfaced Preformed Rigid Cellular Polyisocyanurate Thermal Insulation
12	ASTM C610	Expanded Perlite Block and Thermal Pipe Insulation
13	ASTM C612	Mineral Fiber Block and Board Thermal Insulation
14	ASTM C921	Properties of Jacketing Materials for Thermal Insulation
15	ASTM C1136	Flexible Low Permeance Vapor Retarders for Thermal Insulation
16	ASTM C1728	Standard for Aerogel Insulation
17	ASTM D412	Standard Test Methods for Vulcanized Rubber and Thermoplastic Elastomers-Tension
18	ASTM D1000	Methods for Pressure-Sensitive Adhesive-Coated Tapes Used for Electrical and Electronic Applications
19		
20	ASTM D1621	Standard Test Method for Compressive Properties Of Rigid Cellular Plastics
21	ASTM D1622	Standard Test Method for Apparent Density of Rigid Cellular Plastics
22	ASTM D1940	Method of Test for Porosity of Rigid Cellular Plastics
23	ASTM D2126	Method for Response of Rigid Cellular Plastics to Thermal and Humid Aging
24	ASTM D2240	Standard Test Method for Rubber Property—Durometer Hardness
25	ASTM D5590	Test Method for Determining the Resistance of Coatings to Fungal Defacement
26	ASTM E84	Surface Burning Characteristics of Building Materials
27	ASTM E814	Standard Test Method for Fire Tests of Penetration Firestop Systems
28	ASTM E2336	Standard Test Methods for Fire Resistive Grease Duct Enclosure Systems
29	MICA	National Commercial & Industrial Insulation Standards
30	NFPA 225	Surface Burning Characteristics of Building Materials
31	UL 723	Surface Burning Characteristics of Building Materials

QUALITY ASSURANCE

Refer to division 1, General Conditions, Equals and Substitutions

Label all insulating products delivered to the construction site with the manufacturer's name and description of materials.

Insulation systems shall be applied by experienced contractors. Within the past five (5) years, the contractor shall be able to document the successful completion of a minimum of three (3) projects of at least 50% of the size and similar scope of the work specified in this section.

Fluid-applied ductwork insulation is a roofing product that shall be applied only by qualified contractors. Contractor shall be recognized by the manufacturer of the Polyurea 2-part liquid membrane system as an "approved" or "authorized" applicator. Only manufacturer recognized, qualified and authorized Contractor's whose labor and material are fully covered, without exception, by the manufacturer's warranty, as required by this section, will be allowed to perform the work. Manufacturer must submit letterhead document verifying the Contractor as an authorized applicator of their product and able to receive the specified warranty.

DESCRIPTION

Furnish and install all insulating materials and accessories as specified or as required for a complete installation. The following types of insulation are specified in this section:

- Pipe Insulation
- Duct Insulation
- Equipment Insulation

Install all insulation in accordance with the latest edition of MICA (Midwest Insulation Contractors Association) Standard and manufacturer's installation instructions. Exceptions to these standards will only be accepted where specifically modified in these specifications, or where prior written approval has been obtained from the Owner's Project Representative.

DEFINITIONS

Concealed: shafts, furred spaces, space above finished ceilings, utility tunnels and crawl spaces. All other areas, including walk-through tunnels, shall be considered as exposed.

SHOP DRAWINGS

Refer to division 1, General Conditions, Submittals.

Submit a schedule of all insulating materials to be used on the project, including adhesives, fastening methods, fitting materials along with material safety data sheets and intended use of each material. Include manufacturer's technical data sheets indicating density, thermal characteristics, jacket type, and manufacturer's installation instructions. Include copies of the MICA plates that are applicable to this project.

OPERATION AND MAINTENANCE DATA

All operations and maintenance data shall comply with the submission and content requirements specified under section GENERAL REQUIREMENTS.

In addition to the general content specified under GENERAL REQUIREMENTS supply the following additional documentation:

ENVIRONMENTAL REQUIREMENTS

Do not store insulation materials on grade or where they are at risk of becoming wet. Do not install insulation products that have been exposed to water.

Protect installed insulation work with plastic sheeting to prevent water damage.

PART 2 - PRODUCTS

MATERIALS

Manufacturers: Armacell, CertainTeed, Manson, Childers, Dow, Extol, Fibrex, Halstead, Foster, Imcoa, ITW, Johns Manville, Knauf Insulation, Owens-Corning, Pittsburgh Corning, VentureTape or approved equal.

Materials or accessories containing asbestos will not be accepted.

Use composite insulation systems (insulation, jackets, sealants, mastics, and adhesives) that have a flame spread rating of 25 or less and smoke developed rating of 50 or less, with the following exceptions:

Pipe insulation which is not located in an air plenum may have a flame spread rating not over 25 and a smoke developed rating no higher than 450 when tested in accordance with UL 723 and ASTM E84.

INSULATION TYPES

Insulating materials shall be fire retardant, moisture and mildew resistant, and vermin proof. Insulation shall be suitable to receive jackets, adhesives and coatings as indicated.

FLEXIBLE FIBERGLASS INSULATION:

Minimum nominal density of 0.75 lbs. per cu. ft., and thermal conductivity of not more than 0.30 at 75 degrees F mean temperature, rated for maximum service temperature of 250 degrees F.

RIGID FIBERGLASS INSULATION:

Minimum nominal density of 3 lbs. per cu. ft., and thermal conductivity of not more than 0.23 at 75 degrees F mean temperature, 0.25 at 125 degrees F, 0.27 at 150 degrees F, 0.29 at 200 degrees F, 0.32 at 250 degrees F, minimum compressive strength of 25 PSF at 10% deformation, rated for maximum service temperature of 450 degrees F.

SEMI-RIGID FIBERGLASS INSULATION:

Minimum nominal density of 3 lbs. per cu. ft., thermal conductivity of not more than 0.28 at 75 degrees F mean temperature, minimum compressive strength of 25 PSF at 10% deformation, rated for service temperature range of 0 degrees F to 450 degrees F. Insulation fibers perpendicular to jacket and scored for wrapping cylindrical surfaces.

CALCIUM SILICATE INSULATION:

Rigid hydrous calcium silicate, ASTM C533, Type I, minimum dry density of 12.5 lbs. per cu. ft., thermal conductivity of not more than 0.44 at 300 degrees F mean temperature, maximum water absorption of 90% by volume, minimum compressive strength 140 psi at 5% deformation, rated for service temperature range of 0 degrees F to 1,200 degrees F. Material to be visually coded or marked to indicate it is asbestos free.

1
2 **HIGH TEMPERATURE CALCIUM SILICATE INSULATION:**

3 Rigid hydrous calcium silicate, ASTM C533, Type II, minimum dry density of 12.5 lbs. per cu. ft., thermal
4 conductivity of not more than 0.44 at 300 degrees F mean temperature, maximum water absorption of 90%
5 by volume, minimum compressive strength 140 psi at 5% deformation, rated for service temperature range
6 of 0 degrees F to 1,800 degrees F. Material to be visually coded or marked to indicate it is asbestos free.
7

8 **ELASTOMERIC INSULATION:**

9 Flexible closed cell, minimum nominal density of 5.5 lbs. per cu. ft., thermal conductivity of not more than
10 0.28 at 75 degrees F mean temperature, minimum compressive strength of 4.5 psi at 25% deformation,
11 maximum water vapor permeability of 0.08 perm inch, maximum water absorption of 6% by weight, rated
12 for service temperature range of -20 degrees F to 220 degrees F on piping and 180 degrees F where adhered
13 to equipment.
14

15 **POLYOLEFIN INSULATION:**

16 Flexible closed cell, minimum nominal density of 1.5 lbs. per cu. ft., thermal conductivity of not more than
17 0.25 at 75 degrees F mean temperature, minimum compressive strength of 5 psi at 25% deformation,
18 maximum water vapor permeability of 0.0 perm inch, maximum water absorption of 0% by weight and
19 volume, rated for service temperature range of -165 degrees F to 210 degrees F.
20

21 **PHENOLIC INSULATION:**

22 Rigid closed cell, minimum nominal density of 2.2 lbs. per cu. ft., thermal conductivity of not more than 0.13
23 at 75 degrees F mean temperature, minimum compressive strength of 31 psi parallel and 18 psi perpendicular,
24 maximum water vapor permeability 0.117 perm inch, maximum water absorption of 0.5% by volume, rated
25 for service temperature range of -290 degrees F to 250 degrees F.
26

27 **EXTRUDED POLYSTYRENE INSULATION:**

28 Rigid closed cell, minimum nominal density of 1.6 lbs. per cu. ft., thermal conductivity of not more than 0.26
29 at 75 degrees F mean temperature, minimum compressive strength of 20 psi, maximum water vapor
30 permeability of 1.5 perm inch, maximum water absorption of 0.5 % by volume (ASTM C272), rated for
31 service temperature range of -290 degrees F to 165 degrees F.
32

33 **POLYISOCYANURATE INSULATION:**

34 Rigid closed cell polyisocyanurate, minimum nominal density of 2.0 lbs. per cu. ft., thermal conductivity of
35 not more than 0.19 at 75 degrees F mean temperature aged 180 days, minimum compressive strength of 24
36 psi parallel and 13 psi perpendicular, maximum water vapor permeability of 4 perm inch, maximum water
37 absorption of 2% by volume, rated for service temperature range of -290 degrees F to 300 degrees F.
38

39 **CELLULAR GLASS INSULATION:**

40 Rigid closed cell, minimum nominal density of 7.5 lbs. per cu. ft., thermal conductivity of not more than 0.28
41 at 50 degrees F mean temperature, 0.29 at 75 degrees F mean temperature, 0.38 at 200 degrees F mean
42 temperature, minimum compressive strength of 90 psi, maximum water vapor permeability of 0.0 perm inch,
43 maximum water absorption of 0.2% by volume, rated for service temperature range of -450 degrees F to 900
44 degrees F.
45

46 **MINERAL WOOL INSULATION:**

47 Rigid preformed mineral wool, minimum nominal density of 8 lbs. per cu. ft., thermal conductivity of not
48 more than 0.24 at 75 degrees F mean temperature, 0.30 at 200 degrees F, 0.38 at 300 degrees F, minimum
49 compressive strength of 3 psi, maximum wicking of 1%, maximum water adsorption of 1% by volume, rated
50 for service temperature range of -120 degrees F to 1200 degrees F.
51

52 Pipe insulation shall be pre-formed in two (2) half cylinder sections. Cut V-groove sheet insulation is not
53 acceptable. Provide three (3) stainless steel bands for each section of insulation.
54

55 **AEROGEL INSULATION:**

56 Flexible sheet with a minimum nominal density of 11 lbs. per cu. ft., thermal conductivity of not more than
57 0.146 at 100 degrees F mean temperature, 0.19 at 200 degrees F, 0.22 at 250 degrees F, material shall be
58 hydrophobic, and rated for service temperature range of -40 degrees F to 1200 degrees F.
59

60 **FIREPROOFING INSULATION:**

61 Mineral wool with nominal density of 8 lbs. per cu. ft., flame spread index of 25, fuel contribution index of
62 0, and smoke developed index of 0, thermal conductivity of not more than 0.23 at 75 degrees F mean
63 temperature, rated for service temperature range of -120 degrees F to 1200 degrees F. Use rigid or semi-rigid
64 board for duct insulations.

Foil-scrim-polyethylene vapor retarding jacket, factory applied to insulation, maximum permeance of .02 perms.

FIRE RATED INSULATION:

Noncombustible, non-asbestos, non-ceramic fiber, high temperature blanket or board fireproofing insulation, constructed of calcium silicate or calcium/magnesium/silica amorphous wool with 2-hour ASTM E814 "F" and "T" fire ratings, UL or equivalent third party listed, labeled and specifically evaluated for such purpose in accordance with ASTM E2336. Foil-scrim-polyethylene fiberglass reinforced factory applied jacket.

FLUID-APPLIED DUCTWORK INSULATION (FDI):

Pre-approved Manufacturers: Technical Roofing Solutions, Inc.; Volatile Free Inc.; BASF Corp.; Gaco Western Inc. or equal. (Manufacturers must be approved prior to bid opening.)

Coatings shall be U.L. Listed to retain existing system UL ratings when applied as specified in this project.

Silicone enhanced water-borne single component waterproofing elastomeric coating with excellent strength and weathering characteristics.

Final finish coating color shall match existing fluid applied ductwork insulation color or as indicated by A/E.

Performance Values:

PHYSICAL PROPERTY	ASTM TEST METHOD	TYPICAL VALUE
Tensile Strength	D 412	225 psi
Elongation	D 412	200%
Shore A Hardness (inst-5 sec.)	D 2240	65Shore A
Tack-Free Time		10 to 30 Seconds
Service Temperature		-40°F to 300°F
Application Temperature		40°F to 150°F
Tear Resistance	D 264 Die C	65 Pli
Spread of Flame	ASTM E-84	<75 (Smoke<450)

Approved Spray Polyurethane Foam (SPF) used for thermal insulation.

Performance Values:

PHYSICAL PROPERTY	ASTM TEST METHOD	TYPICAL VALUE
Density (nominal)	ASTM D-1622	2.5 pcf
Compressive Strength (min) (parallel to rise)	ASTM D-1621	40 psi
K Factor (Initial)	ASTM C-177	0.15 btu.in/ft2.hr. °F
Closed Cell Content	ASTM D-1940	90%
Dimensional Stability (aged 28 days, % volume change)	ASTM D-2126	<2.5 @ 158°F/98% RH
Moisture (Perm/Inch)	ASTM C-355	0.8
Spread of Flame* (2 inch thick sample)	ASTM E-84	<75 (Smoke<450)

Final coating shall be a silicone enhanced water-borne elastomeric compatible, fire retardant coating (Flame spread <25 Smoke <50).

Water-Based Epoxy Primer: A two-component, water-based, multi-purpose, easy spreading epoxy primer.

1 Urethane, high build mastic for applications where high performance, all temperature flexibility, and strength
2 is required.

3
4 Urethane-based, low solids, fast drying, penetrating, rust and general-purpose primer.

5
6 Highly concentrated, low-sudsing biodegradable cleaner used to remove grease and grime.

7
8 Hydrocarbon modified, moisture-cured, urethane coating for use over asphalt products and as a basecoat
9 /primer for silicone enhanced water-borne elastomeric coating.

10
11 Other products required by coating manufacturer.

12
13 Fluid-Applied Ductwork Insulation Guarantee:

14 *State of Wisconsin Guarantee:* Provide written guarantee warranting installation required under contract, to
15 be watertight and free from defects in materials or workmanship for period, as stipulated in guarantee form.
16 *A copy of the required guarantee form is appended hereto.*

17
18 Liquid Coating Manufacturer's Warranty:

19 Provide written manufacturer's (NDL) no-dollar-limit warranty covering installation required under contract,
20 to be watertight and free from defects in materials and workmanship of the silicone enhanced water-borne
21 elastomeric coating and other system components supplied by the manufacturer for a period of fifteen (15)
22 years from date of installation.

23
24 Completed project requires installation inspection and approval by the manufacture of the silicone enhanced
25 water-borne elastomeric coating.

26
27 Note: Warranty may not contain clause(s) voiding warranty due to contractor solvency, improper
28 workmanship, contractor error, or contractor failure to follow manufacturer specification(s) and
29 requirements to obtain the warranty requested by this project.

30
31 (Contractors Performance-Payment Bond is only required to apply to this trade section during the
32 construction period and the first year of the guarantee period. Said Bond shall not apply to any extended
33 guarantee period beyond the first year. Such extended guarantees are limited to the applicable Contractor
34 and manufacturer as herein specified.)

35 36 **ADHESIVES, MASTIC, SEALANTS, AND REINFORCING MATERIALS**

37 Products shall be compatible with surfaces and materials on which they are applied and shall be suitable for
38 use at operating temperatures of systems to which they are applied.

39 **FIBERGLASS INSULATION ADHESIVE:**

40 Must comply with ASTM C916, Type II: Foster 85-60, Childers CP-127, Duro Dyne SSG.

41 42 **VAPOR RETARDING MASTIC:**

43 For below ambient equipment/piping use a water based mastic with a water vapor permeance of less than
44 0.04 perms at 40 mils dry film thickness per ASTM E 96: Childers CP-34, Foster 30-65 Vapor-Fas, , Knauf
45 Insulation, KI-900 or KI-905, Vimasco 749.

46
47
48 For below ambient equipment/piping use water based, anti-fungal mastic that meets ASTM D 5590 with a 0
49 growth rating (AF) and a water vapor permeance that is less than 0.013 perms at 43 mils dry film thickness
50 per ASTM E 96 Procedure B: Foster 30-80AF Vapor Safe Mastic or equal.

51
52 Anti-fungal mastic to be used in the following locations;

- 53 • Exterior locations
- 54 • Parking ramps
- 55 • Swimming pool equipment rooms
- 56 • Chemical storage and hazardous waste storage rooms
- 57 • Wet wells
- 58 • Sanitary pumping stations
- 59 • Food service/kitchen areas
- 60 • Walk-in coolers/freezers
- 61 • Locker/shower rooms
- 62 • Greenhouses
- 63 • Meter Pits

WEATHER BARRIER BREATHER MASTIC:

For above ambient equipment/piping use water based mastic with a permeance greater than 1.0 perms at 1/16" dry film thickness per ASTM E96. Foster 46-50 Weatherite, Childers Vi-Cryl CP-10/CP-11, Vimasco WC-5, Knauf Insulation KI-700 or KI-705.

LAGGING ADHESIVE / COATINGS:

For all indoors applications used in conjunction with canvas/glass cloth: Foster 30-36, Childers CP-50A MV1, Vimasco 713.

For all indoor applications used in conjunction with canvas/glass cloth: the coating must be anti-fungal and shall meet ASTM D 5590 with 0 growth rating (AF): Foster 30-36 AF Seal Fas, Childers CP-137 AF Chil-Seal.

Anti-fungal adhesive/coating to be used in the following locations;

- Exterior locations
- Parking ramps
- Swimming pool equipment rooms
- Chemical storage and hazardous waste storage rooms
- Wet wells
- Sanitary pumping stations
- Food service/kitchen areas
- Walk-in coolers/freezers
- Locker/shower rooms
- Greenhouses
- Meter Pits

REINFORCING MESH:

Use Foster 42-24 Mast A Fab, Childers Chil Glas #10 or Pittsburgh Corning PC 79.

METAL JACKETING SEALANT FOR ALL ALUMINUM JACKETING:

Metal jacketing sealants to be non-shrinking and permanently flexible.

Use Foster 95-44 Elastolar, Childers CP-76 Chil-Byl, Pittsburgh Corning 727.

For Polystyrene use Foster 30-45N, or Childers CP-70.

INSULATION JOINT SEALANT:

Joint sealants to be non-shrinking and permanently flexible.

Used on all below ambient piping to prevent moisture ingress.

For Cellular Glass, Polyisocyanurate, Phenolic use Foster 95-44 Elastolar, Childers CP-70 Chil-Byl, Pittsburgh Corning CW Sealant.

For Polystyrene use Foster 30-45N, Childers CP-70.

For Elastomeric use Armaflex 520 or equal.

JACKETS

PVC FITTING COVERS AND JACKETS (PFJ):

White PVC film, gloss finish one side, semi-gloss other side, FS LP-535D, Composition A, Type II, Grade GU. Ultraviolet inhibited indoor/outdoor grade to be used where exposed to high humidity, ultraviolet radiation, in kitchens or food processing areas or installed outdoors. Jacket thickness to be minimum .02" indoors/.03" outdoors for piping 12" and smaller, .03" indoors/.04" outdoors for piping 15" and larger.

ALL SERVICE JACKETS (ASJ):

Heavy duty, fire retardant material with polymer coated white kraft reinforced foil vapor retarder jacket, factory applied to insulation with a self-sealing pressure sensitive adhesive lap, maximum permeance of .02 perms and minimum beach puncture resistance of 50 units.

FOIL SCRIM KRAFT ALL SERVICE JACKETS (FSK):

Glass fiber reinforced foil kraft laminate, factory applied to insulation. Maximum permeance of .02 perms and minimum beach puncture resistance of 25 units.

PROTECTIVE METAL JACKETS (PMJ):

0.016 inch thick aluminum or 0.010 inch thick stainless steel with safety edge for indoor HVAC installations. 0.024 inch thick aluminum or 0.016 inch thick stainless steel with safety edge for Central Plant and Utility installations.

1 SELF-ADHERING JACKETS (SAJ):

2 5-ply, self-adhering multiple laminated waterproofing material with reflective aluminum foil, high density
3 polymer films and cold weather acrylic adhesive providing zero (0.0) permance. Minimum 6 mils material
4 thickness, 25lb puncture resistance when tested in accordance with ASTM D1000 and flame spread/smoke
5 developed rating of 10/20 when tested in accordance with UL 723.

6
7 Vapor retarding tape shall be specifically designed and manufactured for use with the self-adhering jacket
8 specified above. Tape shall be provided by the same manufacturer that provides jacketing. Vapor retarding
9 tapes used with self-adhering jackets shall have a maximum permance of 0.0 perms.

10
11 FABRIC REINFORCED MASTIC JACKETS (FMJ):

12 Glass fiber reinforcing fabric imbedded in weather barrier mastic as per manufacturer's recommended
13 procedure for 2 coat application.

14
15 VAPOR RETARDING JACKETS (VRJ):

16 3 ply composite vapor retarding jacket material with a maximum permance of 0.0 perms. Material shall not
17 support the growth of mold or mildew. Polyguard Zeroperm or equivalent.

18
19 Vapor retarding tape shall be specifically designed and manufactured for use with the vapor retarding jacket
20 specified above. Tape shall be provided by the same manufacturer that provides jacketing. Vapor retarding
21 tapes used with vapor retarding jackets shall have a maximum permance of 0.0 perms.

22
23 **INSULATION INSERTS AND PIPE SHIELDS**

24 Manufacturers: B-Line, Pipe Shields, Value Engineered Products.

25
26 Construct inserts with calcium silicate or polyisocyanurate (service temperatures below 300 degrees F only),
27 minimum 140 psi compressive strength. Piping 12" and larger, supplement with high density 600 psi
28 structural calcium silicate insert. Provide galvanized steel shield. Insert and shield to be minimum 180 degree
29 coverage on bottom supported piping and full 360 degree coverage on clamped piping. On roller mounted
30 piping and piping designed to slide on support, provide additional load distribution steel plate.

31
32 Where contractor proposes shop/site fabricated inserts and shields, submit schedule of materials, thicknesses,
33 gauges and lengths for each pipe size to demonstrate equivalency to pre-engineered/premanufactured product
34 described above. On low temperature systems, high density rigid polyisocyanurate may be substituted for
35 calcium silicate provided insert and shield length and shield gauge are increased to compensate for lower
36 insulation compressive strength.

37
38 Precompressed 20# density molded fiberglass blocks, Hamfab or equal, of the same thickness as adjacent
39 insulation may be substituted for calcium silicate inserts with one 1"x6" block for piping through 2-1/2" and
40 three 1"x6" blocks for piping through 4". Submit shield schedule to demonstrate equivalency to pre-
41 engineered/premanufactured product described above.

42
43 Wood blocks will not be accepted.

44
45 **EXPANSION JOINT AND VALVE INSULATION BLANKETS**

46
47 Manufacturers: Advance Thermal Corporation, TANI Division B.D. Schiffler, Sprinkman and Sons. Site
48 fabricated blankets are not acceptable.

49
50 Blanket shall be 16.5 ounces per square yard PTFE (polytetrafluoroethylene) designed for wet and dry steam
51 applications to 600°F. Jacket shall have coated fabric on both exterior and interior. Wire mesh interior is not
52 acceptable.

53
54 The Blankets shall be installed to shed water and have a 3-inch wide cinchable rain flap on each end.

55
56 All seams shall be sewn twice with double locked stitching. One seam shall be sewn with 3-ply Nomex and
57 the other with 3-ply stainless steel. Hog rings and staples shall not be used.

58
59 The insulation shall be a 2-inch thick, compressed "E" glass fiber with no chemical binders, held in place
60 with 12 gauge stainless quilt pins which do not puncture the inner surface of the blanket.

61
62 Blankets shall be designed to allow access to the expansion and ball joints packing cylinder plungers for
63 repacking without removing the blanket.

Removable expansion joint blanket shall be constructed to allow the pipe and rigid insulation to expand/contract with the pipe. Blanket shall have a close fit without sagging or gaps.

Blanket shall allow for normal operation of the valve or joint without removing the cover.

Valve blankets shall come in two pieces and cover the valve yoke (if applicable).

Blankets shall have D-ring, hook and loop or buckle securing straps. Pins and wire or spring and ring securement is not acceptable.

Blankets shall have a stainless steel identifying plaque on the exterior identifying equipment information.

ACCESSORIES

All products shall be compatible with surfaces and materials on which they are applied and be suitable for use at operating temperatures of the systems to which they are applied.

Adhesives, sealants, and protective finishes shall be as recommended by insulation manufacturer for applications specified.

Insulation bands to be 3/4 inch wide, constructed of stainless steel. Minimum thickness to be 0.010 inch for stainless steel.

Tack fasteners to be stainless steel ring grooved shank tacks.

Staples to be clinch style.

Insulating cement to be ANSI/ASTM C195, hydraulic setting mineral wool.

Finishing cement to be ASTM C449.

Fibrous glass or canvas fabric reinforcing used with lagging adhesive shall have a minimum untreated weight of 6 oz./sq. yd.

Fungicidal water base duct liner coating (Foster 40-20 or equal) to be compatible with vapor retarding coating. This product must be EPA registered to be used inside HVAC ducts. Coating must comply with ASTM D 5590 with 0 growth rating.

PART 3 - EXECUTION

EXAMINATION

Verify that all piping, equipment, and ductwork are tested and approved prior to installing insulation. Do not insulate systems until testing and inspection procedures are completed.

Verify that all surfaces are clean, dry and without foreign material before applying insulation materials.

INSTALLATION

All materials shall be installed by skilled labor regularly engaged in this type of work. All materials shall be installed in strict accordance with manufacturer's recommendations, building codes, and industry standards. Do not install products when the ambient temperature or conditions are not consistent with the manufacturer's recommendations. Surfaces to be insulated must be clean and dry.

Locate insulation and cover seams in the least visible location. All surface finishes shall be extended in such a manner as to protect all raw edges, ends and surfaces of insulation.

Install insulation with smooth and even surfaces. Poorly fitted joints or use of filler in voids will not be accepted. Provide neatly beveled and coated terminations at all nameplates, uninsulated fittings, or at other locations where insulation terminates.

Install fabric reinforcing without wrinkles. Overlap seams a minimum of 2 inches.

Use full length material (as delivered from manufacturer) wherever possible. Scrap piecing of insulation or pieces cut undersize and stretched to fit will not be accepted.

1 All pipe and duct insulation shall be continuous through walls, ceiling or floor openings and through sleeves
2 except where firestop or firesafing materials are required. Vapor retarding jacket shall be maintained
3 continuous through all penetrations.

4
5 Provide a continuous unbroken moisture vapor retarding jacket on insulation applied to systems noted below.
6 Attachments to cold surfaces shall be insulated and vapor sealed to prevent condensation.

7
8 Provide a complete vapor retarding jacket for insulation on the following systems:

- 9 • Cold Water Make-Up
- 10 • Chilled Water
- 11 • Insulated Duct
- 12 • Equipment, ductwork or piping with a surface temperature below 65 degrees F

13 14 **PROTECTIVE JACKET INSTALLATION**

15 **PVC FITTING COVERS AND JACKETS (PFJ):**

16 Lap seams and joints a minimum of 2 inches and continuously seal PVC with welding solvent recommended
17 by jacket manufacturer. Secure PVC fittings with welding solvent on seams and joints. Lap slip joint ends 4"
18 without fasteners where required to absorb expansion and contraction. For sections where vapor retarding
19 jacket is not required, and jacket requires routine removal, tack fasteners may be used. For systems requiring
20 a vapor retarding jacket, apply a 1-1/2" band of mastic over ends, throat, seams and penetrations.

21 22 **ALL SERVICE JACKETS (ASJ) and FOIL SCRIM KRAFT JACKETS (FSK):**

23 Install according to manufacturer's recommendations using factory supplied lap seals and butt strip seals. In
24 addition to factory adhesive, secure lap seals and tape with clinch type staples.

25 26 **PROTECTIVE METAL JACKET (PMJ):**

27 Lap seams a minimum of 2 inches. Secure with metal bands for end to end joints, and rivets or sheet metal
28 screws for longitudinal joints. Rivets, screws, and bands to be constructed of the same material as the jacket.
29 For piping with VRJ jacket provide metal bands at 12" centers, rivets and screws cannot be used. Locate
30 longitudinal seams on the side (3:00 O'clock) for exterior applications. Seal laps with 1/8" bead of metal
31 jacketing sealant to prevent water entry.

32 33 **SELF-ADHERING JACKETS (SAJ):**

34 Install according to manufacturer's recommendations. Cut allowing minimum 4" overlap on ends and 6" on
35 longitudinal joints. Align parallel to surface. Remove release paper and press flat to surface to avoid wrinkles.
36 Rub entire surface with plastic squeegee for full adhesion and sealing at joint overlaps. On exterior
37 applications, provide a bead of compatible caulk along exposed edges.

38
39 Piping with self-adhering (SAJ) jackets shall have elbows, fittings, valves and butt joints wrapped with 2
40 layers of vapor retarding tape. Piping with a PVC jacket (PFJ) installed over the self-adhering (SAJ) jacket
41 may be provided with a single, lapped layer of vapor retarding tape for elbows, fittings and valves under the
42 PVC jacket. Vapor retarding tape shall be compatible with the jacket material used.

43 44 **FABRIC REINFORCED MASTIC JACKETS (FMJ):**

45 Glass fiber fabric shall be fitted without wrinkles. Glass fiber fabric shall be sized immediately upon
46 application with lagging adhesive and shall be capable of drying within 6 hrs. Apply adhesive and coating in
47 accordance with manufacturer's recommendations. All seams shall overlap not less than 2".

48 49 **VAPOR RETARDING JACKETS (VRJ):**

50 Piping with vapor retarding jackets (VRJ) shall have elbows, fittings, valves and butt joints wrapped with 2
51 layers of vapor retarding tape. For piping without a (PFJ) jacket, wrap jacket with 1" wide vapor retarding
52 tape at 12" centers with a 25% overlap. Piping with a PVC jacket (PFJ) installed over the vapor retarding
53 jackets (VRJ) may be provided with a single, lapped layer of vapor retarding tape for elbows, fittings and
54 valves under the PVC jacket. Vapor retarding tape shall be compatible with the jacket material used.

55 56 **PIPING, VALVE, AND FITTING INSULATION**

57 **GENERAL:**

58 Install insulation with butt joints and longitudinal seams closed tightly. Provide minimum 2" lap on jacket
59 seams and 3" tape on butt joints, firmly cemented with lap adhesive unless otherwise noted. Additionally,
60 secure with clinch style staples along seams and butt joints.

61
62 On systems requiring a vapor retarding jacket, seal off all raw ends of insulation and butt joints with vapor
63 retarding mastic at intervals of not more than 20 feet on piping to create a vapor dam. Also provide a vapor
64 dam on each side of valves, unions, and tees. Coat staples, longitudinal and transverse seams with vapor

retarding mastic and on systems requiring vapor retarding jacket, coat insulated elbows, fittings, and valves with vapor retarding mastic.

Install insulation continuous through pipe hangers and supports with hangers and supports on the exterior of insulation. Where a vapor retarding jacket is not required or where roller hangers are not being used, hangers and supports may be attached directly to piping with insulation completely covering hanger or support and jacket sealed at support rod penetration. Where riser clamps are required to be attached directly to piping requiring vapor retarding jacket, extend insulation and vapor retarding jacketing/coating around riser clamp.

Where insulated piping is installed on hangers and supports, the insulation shall be installed continuous through the hangers and supports. High density inserts shall be provided as required to prevent the weight of the piping from crushing the insulation. Pipe shields are required at all support locations. The insulation shall not be notched or cut to accommodate the supporting channels.

Fully insulate all reheat coil piping, fittings and valves (except for unions) up to coil connection to prevent condensation when coil is inactive during cooling season. Provide a vapor proof seal between the pipe insulation and the insulated coil casing.

INSULATION INSERTS AND PIPE SHIELDS:

Provide pipe shields at all hanger and support locations. Rigid insulation inserts shall be installed between the pipe and the insulation shields. Quantity and placement of inserts shall be according to the manufacturer's installation instructions; however, the inserts shall be no less than 12" in length. Inserts shall be of equal thickness to the adjacent insulation and shall be vapor sealed as required for system.

Provide insulation inserts and pipe shields at all hanger and support locations. Inserts may be omitted on 3/4" and smaller copper piping provided 12" long 22 gauge pipe shields are used.

FITTINGS AND VALVES:

Fittings, valves, unions, flanges, couplings and specialties may be insulated with factory molded or built up insulation of the same thickness as adjoining insulation. Where the ambient temperature exceeds 150 degrees F, cover insulation with fabric reinforcing and mastic. Where the ambient temperatures do not exceed 150 degrees, furnish and install PVC fitting covers.

MINERAL FIBER:

Secure each 3' section with three metal bands snip off excess and turn ends over into insulation to prevent exposed sharp edges. Stagger joints where more than one layer is used.

Blanket or batt sheet is NOT allow on valves or at fittings. Fittings shall be insulated with pre-formed sections or field fabricated gored pieces. Gore segments shall be stapled together.

Where multiple layers of insulation are used filament tape is allowed to secure the inner layer of insulation only in pits and accessible areas. In steam box conduit and other inaccessible areas the inner AND outer layer of insulation shall be secured with bands, wire and/or tape are not allowed without written Owner's representative approval.

AEROGEL INSULATION:

Secure each 3' or larger sections with stainless steel bands evenly spaced at 12" and at ends. For elbows use 16 gauge stainless steel or annealed copper tie wires evenly spaced. Twist wire ends, snip off excess and turn ends over into insulation. Stagger joints where more than one layer is used.

ELASTOMERIC AND POLYOLEFIN:

Where practical, slip insulation on piping during pipe installation when pipe ends are open. Miter cut fittings allowing sufficient length to prevent stretching. Completely seal seams and joints for vapor tight installation. For elastomeric insulation, apply full bed of adhesive to both surfaces. For polyolefin, seal factory pregglued seams with roller and field seams and joints with full bed of hot melt polyolefin glue to both surfaces. Cover elastomeric insulation on systems operating below 40 degrees F with vapor retarding mastic.

EXTRUDED POLYSTYRENE AND POLYISOCYANURATE:

Fittings, valves, unions, flanges, couplings and specialties shall be insulated with factory molded insulation of the same thickness as adjoining insulation. Secure insulation sections with two wraps of nylon filament tape 9"-12" on center. On single insulation layer systems and on the outer layer of double insulation layer systems, apply a 1/16" thick bead of joint sealant rated for system operating temperatures to the outer edge of all longitudinal and butt insulation joints. For piping service below 20°F, use two layers of insulation with inner and outer butt and longitudinal joints staggered and offset 90 degrees. Where two layers of insulation

are used, do not use sealant on the inner layer or adhere the inner layer to the outer layer. Apply vapor stop bead of joint sealant between pipe and insulation on both sides of valves, expansion/contraction joints, flanges, thermometers/gauges, attached vent and drain lines. Insulate attached non-circulated lines, control lines, vents, etc. for a minimum distance of 6" from pipe. Cover insulation with a protective jacket as specified below. Do not penetrate protective covering or insulation with mechanical fasteners.

PIPING PROTECTIVE JACKETS

In addition to the jackets specified in the pipe insulation schedule below the following protective jackets are required:

Provide a protective PVC jacket (PFJ) for the following insulated piping:

- Chilled water piping and valves in walk-thru tunnels and valve pits
- Exposed piping in kitchens
- Piping exposed in finished locations
- Exterior refrigeration piping.

Provide a protective PVC (PFJ) or Fabric Reinforced Mastic (FMJ) jacket for the following insulated piping:

- All piping within mechanical rooms.

Provide a protective metal (PMJ) or self-adhering (SAJ) jacket for the following insulated piping:

- Exterior installed refrigeration piping.

Provide a protective metal jacket (PMJ) for the following insulated piping:

- Steam and condensate piping and fittings located in walk-thru tunnels and steam pits.

Provide a protective covering of 2 coats of vapor retarding mastic with fibrous glass or canvas fabric reinforcing (FMJ) for the following insulated piping:

Provide a protective self-adhering (SAJ) jacket for the following insulated piping:

REMOVABLE INSULATION BLANKETS: (EXPANSION SLIP JOINT AND VALVES 2-1/2" AND LARGER)

Provide removable reusable insulated cover on new and existing expansion slip joints, ball joints and valves.

Install blankets to be field removable without tools.

Blankets shall be installed to allow the normal expansion and contraction associated with these systems, without crushing or damaging the blanket.

Expansion Joint blankets shall extend over the adjacent rigid insulation to allow for pipe expansion.

Blankets shall be installed without sagging or gaps.

Blankets shall be installed to shed water.

Steam system will not be allowed to start up until removable jackets are installed.

PIPE INSULATION SCHEDULE:

Provide insulation on new and existing remodeled piping system as indicated in the following schedule:

SERVICE	INSULATION	JACKET	INSULATION THICKNESS BY PIPE SIZE				
			< 1"	1" to < 1-1/2"	1-1/2" to < 4"	4" to < 8"	8" and Larger
Heating Hot Water	Rigid Fiberglass	ASJ	1.5"	1.5"	2"	2"	2"
Chilled Water	Polyisocyanurate / Polystyrene	VRJ or SAJ	1.5"	1.5"	1.5"	1.5"	1.5"
Process Chilled Water	Polyisocyanurate / Polystyrene	VRJ or SAJ	1.5"	1.5"	1.5"	1.5"	1.5"

Cooling Coil Condensate Drain	Rigid Fiberglass	ASJ	0.5"	0.5"	1"	1"	1"
Low Pressure Steam	Rigid Fiberglass	ASJ	2.5"	2.5"	2.5"	3"	3"
In Conduits	Mineral Wool	None	2.5"	2.5"	2.5"	3"	3"
Low Pressure Cond.	Rigid Fiberglass	ASJ	1.5"	1.5"	2"	2"	2"
In Conduits	Mineral Wool	None	1.5"	1.5"	2"	2"	2"
Cond. Pump Disch. In conduits	Mineral Wool	None	1.5"	1.5"	2"	2"	2"

Insulation on all steam distribution systems shall be installed in multiple layers not exceeding 3" in thickness.

The following piping and fittings are not to be insulated:

- Hot water piping inside radiation or cabinet heater enclosures
- Steam Traps
- Piping unions for systems not requiring a vapor retarding Jacket

For systems with fluid temperatures 65° F or less, furnish and install removable elastomeric insulation covers, plugs or caps for all mechanical equipment and devices that require access by balancing contractors or service and maintenance personnel. Examples include but are not limited to: flow sensing devices, circuit setters, manual ball valve air vents, drain valves, blowdown valves, pressure/temperature test plugs, grease fittings, pump bearing caps, equipment labels, etc. Covers shall be tight fitting to ensure a complete vapor retarding barrier.

DUCT INSULATION

GENERAL:

Secure flexible blanket duct insulation on sides and bottom of ductwork over 24" wide with weld pins. Space fasteners 18" on center or less as required to prevent sagging. Compress insulation no more than 25%.

Secure rigid board insulation to ductwork with weld pins. Apply insulation with joints firmly butted together and placed as close as possible to the equipment surface. Pins shall be located a maximum of 3" from each edge and spaced no greater than 12" on center.

Install weld pins without damage to the interior galvanized surface of the duct. Clip pins back to washer and cover penetrations with tape of same material as jacket. Firmly butt seams and joints and cover with 4" tape of same material as jacket. Seal tape with plastic applicator and secure with staples. All joints, seams, edges and penetrations to be fully vapor sealed with vapor retarding mastic.

Stop and point insulation around access doors and damper operators to allow operation without disturbing insulation or jacket material.

External supply duct insulation is not required where ductwork contains continuous 1" acoustical liner. Provide 4" overlap of external insulation over ends of acoustically lined sections.

Where insulated ductwork is supported by trapeze hangers, the insulation shall be installed continuous through the hangers. Drop the supporting channels required to facilitate the installation of the insulation. Where rigid board or flexible insulation is specified, install high density inserts to prevent the weight of the ductwork from crushing the insulation.

Where insulated low temperature (below 45°F) ductwork is supported by steel metal straps or wire ropes that are secured directly to the duct, the straps or ropes shall be completely covered with insulation and sealed to provide a complete vapor retarding barrier.

Where insulated duct risers are supported by steel channels secured directly to the duct, extend the insulation and vapor retarding jacketing to encapsulate the support channels.

Where ductwork exposed to the weather is insulated with any product other than fluid-applied ductwork insulation, the top surface of the insulation shall be sloped a minimum of 1/2" per foot to eliminate ponding and create positive drainage off insulation.

Tapered Insulation shall be ASTM C1289, Type II, Class 1, Grade 2; rigid board polyisocyanurate insulation with felt or fibrous mat facing on both sides, factory tapered to 1/2" per foot slope. Tapered insulation board

shall have a start thickness at the perimeter of 1/2". Tapered insulation board shall be mechanically fastened to ductwork. Tapered insulation applied to rectangular ductwork less than or equal to 24" in width may be sloped from one side. Tapered insulation applied to rectangular ductwork greater than 24" in width shall be sloped in two directions with the high point at the centerline of the duct.

PLENUMS FOR SLOT DIFFUSERS:

All slot/linear diffuser plenums shall be externally insulated.

BREECHING:

Fasten insulation over weld pins and secure with washers. Space fasteners not less than 3" from edge or corner and 12" on center longitudinally and 9" on center in the transverse direction. Clip pins back to washer and cover penetrations with tape of same material as jacket. Firmly butt seams and joints and cover with 4" tape of same material as jacket. Seal tape with plastic applicator and secure with staples.

GREASE DUCTS:

Strictly adhere to manufacturer's installation instructions and rating requirements for application of fire-stop insulation. Cover all exhaust ducts serving Type I kitchen hoods with fire-stop insulation from a point prior to penetration of ceiling, wall, floor or concealment through building to termination at outside of building. Extend fire-stop insulation through roof curbs.

FLUID-APPLIED DUCTWORK INSULATION (FDI):

Proceed with work only when weather conditions comply with Manufacturer recommendations and other current published data and MSDS information. Do not exceed temperature limitations recommended by coating manufacturer.

The top of ducts insulated with fluid-applied ductwork insulation shall be sloped using tapered insulation prior to applying fluid-applied insulation. Tapered Insulation shall be ASTM C1289, Type II, Class 1, Grade 2; rigid board polyisocyanurate insulation with felt or fibrous mat facing on both sides, factory tapered to 1/2" per foot slope. Tapered insulation board shall have a start thickness at the perimeter of 1/2". Tapered insulation board shall be mechanically fastened to ductwork. Tapered insulation applied to rectangular ductwork less than or equal to 24" in width may be sloped from one side. Tapered insulation applied to rectangular ductwork greater than 24" in width shall be sloped in two directions with the high point at the centerline of the duct.

Air intake vents, blowers, air conditioning units and evaporative coolers shall be disconnected or otherwise modified to prevent fumes from entering the building or from contaminating the substrate surface with condensate water.

Coordinate scheduling with the Owner in order to relocate or protect vehicles, building occupants and building contents from damage during construction operations.

Existing materials designated to remain, which are damaged or defaced as a result of the work shall be replaced at Contractor's expense to like new condition.

Install all rooftop mounted equipment in a watertight manner and repair any damage to sheet metal or other components related to connection and protection of the system.

Prevent materials from entering and clogging roof drains and conductors. Remove roof drain plugs when no work is taking place or when rain is forecast.

Protection of surfaces:

Take every precaution to prevent water leakage or debris falling into the building interior, or other such occurrences. Contractor is responsible for any damage to the building interior, or contents, during application.

Provide special protection or avoid heavy traffic on completed work or roof surfaces. Temporary walkways and work platforms shall be provided as necessary.

Wall surfaces shall be protected with tarpaulins or other suitable cover to prevent damage, staining or discoloration that might result from operations. Windows, doorways, docks, walkways, etc. may require special protection measures.

Protect building and adjacent area and property within the area from over spray.

Caution:

Installation of primers, polyurethane foam or coatings shall not interfere with the proper function of: Manual Volume Dampers, Turning Vanes, Fire Dampers, Smoke Dampers and Combination Fire/Smoke Dampers, Control Dampers, Smoke Detectors, Access Doors, Duct Pressure Relief Doors, Flashings, Duct Flexible Connections, Sound Attenuators, Hoods for Intake and Exhaust, Louvers, Air Blenders and Air Flow Stations.

Installation of Spray Polyurethane Foam (SPF) Insulation:

When required, install approved polyurethane foam to an average thickness as specified in the duct insulation schedule (1" minimum required) and terminated neatly at designated places.

Mask areas where coating is to be terminated to prevent surface contamination with foam over spray.

Foam spray application shall be limited to that which can be completed to full foam thickness in one day. All exposed foam tie-in end laps and side laps must be primed at the end of each workday.

The completed foam surface shall be smooth to orange peel texture; popcorn texture is not acceptable.

The completed foam surface shall be free of pinholes and/or "glass windows" caused by improper equipment calibration or climatic conditions. The SPF shall not have any soft or spongy areas or areas with hard or brittle strings of improperly proportioned material

Eliminate areas of ponding using approved polyurethane foam to create positive drainage.

Remove protective masking at terminations.

Apply protective coating to foam surface on the same day as polyurethane foam is installed.

The foam shall not be left exposed or uncoated for more than 4 hours. If coating application is delayed beyond that time, consult manufacturer for primer recommendations.

Installation of Coating System:

Do not apply coating when moisture is present on the substrate.

Wind barriers shall be used if wind conditions could affect the quality of the material being applied.

Coating must cover all surfaces completely. An extra pass of coating material may be required at all edges and penetrations.

Base coat(s) and primer(s) shall be allowed to cure before proceeding with subsequent applications.

All coating and primers shall be coated within recommended time period. If application is delayed beyond that time, consult Manufacturer for primer recommendations.

Application Thickness:

15 Year NDL System

Average Application Thickness: Topcoat Average thickness shall be 36 Average TDM (Total Dry Mills), (3.75 gallons per 100 sq. ft. minimum application recommended.)

Application rates must be checked periodically to assure proper coating thickness. This may be done by checking dry film thickness.

Contractor to estimate coating requirements based on actual experience and needs to figure losses due to applicator experience, surface texture, wind, waste, and other factors increasing estimated gallons required.

The total dry mil thickness of all coatings, as well as the total dry mil thickness of the topcoat(s) shall meet the minimums required by Manufacturer.

Application of approved silicone enhanced water-borne elastomeric coating:

Spray apply the approved coating to achieve the required TDM. The polyurea shall completely cover the SPF including all termination, penetrations, expansion joint covers, parapets and flashings. Spray pattern shall overlap the previous pass to insure complete coverage.

To assure complete coverage with approved silicone enhanced water-borne elastomeric coating, applicator needs to figure losses due to over-spray, surface texture and wind and increase the gallons as needed to meet specifications.

Pay special attention to overspray, which can texture or discolor adjoining finished sections. Wind direction should conduct overspray away from finished surfaces.

Spray Equipment:

This product must be applied with plural component spray equipment. The proportioning pump should be a positive displacement type set up in a 1:1 ratio, capable of maintaining dynamic pressure of 1,500 psi and fluid temperatures of 150° F during the maximum output of the proportioner. Fluid spray hoses should be of the dual heated type with temperature controls capable of maintaining 150° F fluid temperatures the full length to the spray gun. The heated hose assembly must be insulated and be high-pressure type with designed working pressure to handle the maximum pressure delivered by the proportioner. The inside lining of the hose assembly must be of a material that is unaffected by the coating or solvents used for cleanup. Contact Manufacturer for specific instructions and spray equipment recommendations.

The silicone enhanced water-borne elastomeric shall not be left exposed or uncoated for more than 4 hours. If fire retardant coating application is delayed beyond that time, consult manufacturer for primer recommendations.

Entire application shall receive a final coat of compatible, fire retardant coating (Flame spread <25 Smoke <50). Minimum thickness shall be no less than that tested for Spread of Flame rating (ASTM E-84 /UL-723).

Refasten all mechanical equipment and remount other rooftop equipment as necessary.

DUCTWORK PROTECTIVE COVERINGS:

In addition to the jackets specified in the duct insulation schedule below the following protective coverings are required:

Provide a protective covering of 2 coats of indoor/outdoor vapor retarding mastic with fibrous glass or canvas fabric covering (FMJ) or self-adhering jacket (SAJ) meeting 25/50 Flame Spread/Smoke Rating for the following ductwork:

- Ductwork within 8' of floor, catwalks and mezzanines in mechanical rooms

Provide a protective self-adhering jacket (SAJ) for the following insulated ductwork:

DUCT INSULATION SCHEDULE:

Provide duct insulation on new and existing remodeled ductwork in the following schedule:

SERVICE	INSULATION TYPE	JACKET	THICKNESS
<i>Exhaust ductwork - Moisture Laden Air</i>	<i>Flexible Fiberglass</i>	<i>FSK</i>	<i>2"</i>
Outside air ducts	Rigid Fiberglass	FSK	2"
<i>Slot diffuser plenums</i>	<i>Flexible Fiberglass</i>	<i>FSK</i>	<i>1.5"</i>
Exposed supply ducts*	Rigid Fiberglass	FSK	2"
Concealed supply ducts	Flexible Fiberglass	FSK	1.5"
All Ducts located in unconditioned Attics/Shfts***	Flexible Fiberglass	FSK	3"
Exhaust and relief ducts downstream of motorized backdraft dampers	Rigid Fiberglass	FSK	2"
All ducts exposed to weather	Ext. Polystyrene or Fluid-Applied**	SAJ	3"

Grease ducts serving Type I Kitchen hoods	Fire-Stop	See Spec.	As Req'd. for Specified Hourly Rating
Louver blank-off panels ****	Ext. Polystyrene	SAJ	4"

* Exposed supply branch ducts located in the space they are serving do not require insulation. Exposed supply main ducts running through spaces they serve shall be insulated as exposed supply ducts scheduled above.

** No jacket is required for Fluid-Applied ductwork insulation. The two part Fluid-Applied system serves as insulation and protective jacket.

*** Outside air ductwork between the isolation damper and the outside air intake does not require insulation where it is in an unheated attic.

**** Insulating value of any louver or curb blank off panel needs to meet the building envelope insulating value required by current building code.

EQUIPMENT INSULATION

GENERAL:

Do not insulate over equipment access manholes, fittings, nameplates or ASME stamps. Bevel and seal insulation at these locations.

PROTECTIVE JACKETS:

Provide a protective metal jacket (PMJ) for the following:

- Generator exhaust pipe (that is not concealed in a shaft) and muffler.

SEMI-RIGID FIBERGLASS:

Apply insulation to equipment shells using weld pins, bonding adhesive, banded and wired in place. Fill all joints, seams and depressions with insulating cement to a smooth, even surface. Cover with reinforcing fabric and 2 coats of mastic (FMJ). Use vapor retarding mastic on systems requiring a vapor retarding barrier.

ELASTOMERIC/POLYOLEFIN:

Apply full cover coat of adhesive to surface to be insulated, insulation and edge butt joints. Place insulation with edge joints firmly butted pressing to surface for full adhesion. Seal seams and joints vapor tight.

REMOVABLE COVERS:

Provide insulated easily removable galvanized steel metal boxes for routine service access on the following equipment:

Provide insulated easily removable elastomeric insulation sections for the following equipment:

EQUIPMENT INSULATION SCHEDULE:

Provide equipment insulation as follows:

EQUIPMENT	INSULATION TYPE	JACKET	THICKNESS
Reheat coil casing in exposed supply ducts	Rigid Fiberglass	FSK	2"
Reheat coil casing in concealed supply ducts	Flexible Fiberglass	FSK	1-1/2"
Process Chilled Water Air separators	Elastomeric/Polyolefin	None	1"
Process Chilled Water Pumps	Elastomeric/Polyolefin	None	1"
Heat exchangers	Semi-Rigid Fiberglass	ASJ/PMJ	2"
Condensate receivers (unless otherwise noted)	Semi-Rigid Fiberglass	ASJ/PMJ	2"
Air Handling Unit Casings or attached component sections not factory insulated**	Rigid Fiberglass	ASJ	2"

* Condenser shell only needs to be insulated when condenser is city, lake, or river water cooled or when "free cooling" is used.

1
2 ** The thickness and type of insulation provided for non-factory fabricated transitions or component
3 sections shall be consistent with the sections constructed at the factory.
4

5 *** Protective metal jacket (PMJ) is only required in exposed locations.
6

7 **CONSTRUCTION VERIFICATION ITEMS**

8 Contractor is responsible for utilizing the construction verification checklists supplied under specification
9 Section 23 08 00 in accordance with the procedures defined for construction verification in Section 01 91 01
10 or 01 91 02.
11

12
13 END OF SECTION
14

SECTION 23 33 00
AIR DUCT ACCESSORIES
BASED ON DFD MASTER SPECIFICATION DATED 09/13/2024

PART 1 - GENERAL

SCOPE

This section includes accessories used in the installation of duct systems. Included are the following topics:

PART 1 - GENERAL

- Scope
- Related Work
- Reference
- Reference Standards
- Quality Assurance
- Shop Drawings
- Operation and Maintenance Data

PART 2 - PRODUCTS

- Manual Volume Dampers
- Turning Vanes
- Fire Dampers
- Combination Fire/Smoke Dampers*
- Control Dampers
- Smoke Detectors
- Access Doors
- Flexible Duct
- Flashings
- Duct Flexible Connections
- Sound Attenuators
- Louvers
- Air Blenders
- Air Flow Stations

PART 3 - EXECUTION

- Manual Volume Dampers
- Turning Vanes
- Fire Dampers
- Combination Fire/Smoke Dampers*
- Control Dampers
- Smoke Detectors
- Access Doors
- Flexible Duct
- Flashings
- Duct Flexible Connections
- Sound Attenuators
- Louvers
- Air Blenders
- Air Flow Stations
- Construction Verification

RELATED WORK

Section 23 05 29 – Hanger and Supports for HVAC Piping and Equipment
Section 23 05 48 – Vibration and Seismic Controls for HVAC Piping and Equipment
Section 23 08 00 – Commissioning of HVAC
Section 23 31 00 – HVAC Ducts and Casings

REFERENCE

Applicable provisions of Division 1 govern work under this Section.

REFERENCE STANDARDS

NFPA 90A	Standard for Installation of Air Conditioning and Ventilating Systems
SMACNA	HVAC Duct Construction Standards - Metal and Flexible, 4th Edition, 2020
UL 214	
UL 555 (6 th edition)	Standard for Fire Dampers and Ceiling Dampers
UL 555S (4 th edition)	Leakage Rated Dampers for Use in Smoke Control Systems

1
2 **QUALITY ASSURANCE**

3 Refer to division 1, General Conditions, Equals and Substitutions
4

5 **SHOP DRAWINGS**

6 Refer to division 1, General Conditions, Submittals.
7

8 Submit for all accessories and include dimensions, capacities, ratings, installation instructions, and
9 appropriate identification.

10
11 Include certified test data on dynamic insertion loss, self-noise power levels, and aerodynamic performance
12 of sound attenuators.

13
14 Submit manufacturer's color charts where finish color is specified to be selected by the Architect/Engineer.
15

16 **OPERATION AND MAINTENANCE DATA**

17 All operations and maintenance data shall comply with the submission and content requirements specified
18 under section GENERAL REQUIREMENTS.
19

20
21 **PART 2 - PRODUCTS**
22
23

24 **MANUAL VOLUME DAMPERS**

25 Manufacturers: Ruskin, Vent Products, Air Balance, or approved equal.
26

27 Dampers must be constructed in accordance with SMACNA Fig. 7-4, Fig. 7-5, and notes relating to these
28 figures, except as modified below.
29

30 Reinforce all blades to prevent vibration, flutter, or other noise. Construct dampers in multiple sections with
31 mullions where width is over 48 inches. Use rivets or tack welds to secure individual components; sheet
32 metal screws will not be accepted. Provide operators with locking devices and damper position indicators
33 for each damper; use an elevated platform on insulated ducts. Provide end bearings or bushings for all volume
34 damper rods penetrating ductwork constructed to a 3" w.c. pressure class or above.
35

36 **TURNING VANES**

37 Manufacturers: Aero Dyne, Anemostat, Barber-Colman, Hart & Cooley, or approved equal.
38

39 Construct turning vanes and runners for square elbows in accordance with SMACNA Fig. 4-3 and Fig. 4-4
40 except use only airfoil type vanes. Construct turning vanes for short radius elbows and elbows where one
41 dimension changes in the turn in accordance with SMACNA Chart 4-1 and Fig. 4-10.
42

43 **FIRE DAMPERS**

44 Manufacturers: Air Balance, Advanced Air, American Warming and Ventilating, Greenheck, Phillips-Aire,
45 Prefco, Ruskin, Safe-Air or approved equal.
46

47 **STATIC FIRE DAMPERS**

48 Static fire damper assemblies must be UL 555 (6th edition) listed and labeled for static applications (where
49 air systems do not operate during a fire) and meet requirements of NFPA 90A. Damper must be type B
50 curtain type with blades out of the air stream; dampers with blades in the air stream will not be accepted.
51 Damper fire rating to be compatible with the rating of the building assembly in which the damper is used.
52

53 **DYNAMIC FIRE DAMPERS**

54
55 Dynamic fire damper assemblies must be UL 555 (6th edition) listed and labeled for dynamic applications
56 (where air systems operate during a fire) and meet requirements of NFPA 90A. Dampers must be type B
57 curtain type with curtain 100% out of air stream. Dampers larger than 30" by 30" or with velocity rating
58 requirements of 3000 fpm or higher, may be multiblade type with blades located in the airstream. Velocity
59 ratings and static pressure ratings as indicated on the drawings. Damper fire rating to be compatible with the
60 rating of the building assembly in which the damper is used.
61

62 **COMBINATION FIRE/SMOKE DAMPERS**

63 *Manufacturers: Ruskin, Johnson Controls, Air Balance, Advanced Air, American Warming and*
64 *Ventilating, Greenheck, Safe-Air, Phillips-Aire, Prefco, or approved equal.*

1
2 **Combination fire/smoke damper :**

3 **Combination fire/smoke damper assemblies to be UL 555(6th edition) and UL 555S(4th edition) listed and**
4 **labeled, and have a fire rating compatible with the rating of the building assembly in which the damper is**
5 **used, and be leakage rated at no higher than Class II under UL 555S.**

6
7 **Provide high temperature stainless steel option for moisture laden exhaust air ductwork systems.**
8

9 **Operation:**

10 **Provide factory installed electrically operated dampers with linkage arranged so that the damper is closed**
11 **on loss of power. For electric actuation, provide electric operated dampers with linkage and UL listed**
12 **operators arranged so that the damper is closed on a loss of power. Where electric actuation is controlled**
13 **by the DDC system use 0-10 VDC inputs, with stall protection, and with and zero and span adjustments**
14 **for modulating or 24 VAC for two-position control. Where electric actuation is controlled by the fire alarm**
15 **system, use 120 VAC actuators. All electric actuators will be provided with overload protection to prevent**
16 **motor from damage when stall condition is encountered. Locate all operators out of the air stream unless**
17 **large damper size will not allow. Provide form "C" end switches to indicate damper position.**
18

19 **CONTROL DAMPERS**

20 Control dampers are specified in section 23 09 14.

21
22 **SMOKE DETECTORS**

23 Smoke detectors are furnished and installed by the Electrical Contractor.
24

25 **ACCESS DOORS**

26 **General:**

27 Access doors to be designed and constructed for the pressure class of the duct in which the door is to be
28 installed. Doors in exposed areas shall be hinged type with cam sash lock. Hinges shall be aluminum or steel
29 full length continuous piano type. Doors in concealed spaces shall be secured in place with cam sash
30 latches. For both hinged and non-hinged doors provide sufficient number of camp sash latches to provide
31 air tight seal when door is closed. Do not use hinged doors in concealed spaces if this will restrict access. Use
32 minimum 1" deep 24 gauge galvanized steel double wall access doors with minimum 24 gauge galvanized
33 steel frames. For non-galvanized ductwork, use minimum 1" deep double wall access door with frame that
34 shall use materials of construction identical to adjacent ductwork. Provide double neoprene gasket that shall
35 provide seals from the frame to the door and frame to the duct. When access doors are installed in insulated
36 ductwork or equipment provide insulated doors with insulation equivalent to what is provided for adjacent
37 ductwork or equipment. Access doors constructed with sheet metal screw fasteners will not be accepted.
38

39 **Kitchen Exhaust Ducts:**

40 Use insulated, 1-1/2 hour UL 1978 listed and labeled access doors in kitchen exhaust ducts.
41

42 **FLEXIBLE DUCT**

43 Manufacturers: Anco Products, Clevaflex, Thermaflex, Flexmaster or approved equal.
44

45 Factory fabricated, UL 181 listed as a class 1 duct, and having a flame spread of 25 or less and a smoke
46 developed rating of 50 or under in accordance with NFPA 90A.
47

48 Suitable for pressures and temperatures involved but not less than a 180°F service temperature and ±2 inch
49 pressure class, depending on the application.
50

51 Duct to be composed of polyester film, aluminum laminate or woven and coated fiberglass fabric bonded
52 permanently to corrosion resistant coated steel wire helix. Two-ply, laminated, and corrugated aluminum
53 construction may also be used.
54

55 Where duct is specified to be insulated, provide a minimum 1 inch fiberglass insulation blanket with
56 maximum thermal conductance of 0.23 K (75 degrees F.) and vapor barrier jacket of polyethylene or
57 metalized reinforced film laminate. Maximum perm rating of vapor barrier jacket to be 0.1 perm.
58

59 **FLASHINGS**

60
61 Provide flashing to completely weatherproof connection of ductwork to louvers. Flashing to be constructed
62 of material similar to louver material.
63

64 Flashing and counterflashing for roof curbs will be provided by others.

Flashing and curbs for duct and pipe penetrations of roof assemblies to be in accordance with details.

DUCT FLEXIBLE CONNECTIONS

Material to be fire retardant, be UL 214 listed, and meet the requirements of NFPA 90A.

Connections to be a minimum of 3 inches wide, crimped into metal edging strip, and air tight. Connections to have adequate flexibility and width to allow for thermal expansion/contraction, vibration of connected equipment, and other movement.

General Applications:

Use coated glass fiber fabric for all applications. Material for inside applications other than corrosive environments, fume exhaust, or kitchen exhaust to be double coated with neoprene, air and water tight, suitable for temperatures between -10°F and 200°F, and have a nominal weight of 30 ounces per square yard.

Outdoor Applications:

Material used for outdoor applications other than corrosive environments, fume exhaust, or kitchen exhaust to be double coated with Hypalon, air and water tight, suitable for temperatures between -10°F and 250°F, and have a nominal weight of 26 ounces per square yard.

Corrosive Environments:

For corrosive environments or fume exhaust applications indoors or outdoors, use a material coated with Teflon that is air and water tight, suitable for temperatures between -20°F and 500°F, and has a nominal weight of 14 ounces per square yard.

SOUND ATTENUATORS

Manufacturers: Industrial Acoustics Company, Environmental Elements Corporation, Semco, Dynasonics, United McGill, Price, VAW, Vibro Acoustics or approved equal.

Construct of a 22 gauge galvanized steel outer casing, and 26 gauge galvanized, perforated steel inner liner. Seams and joints of outer casing to be air tight.

Fill annular space between outer casing and inner liner with acoustic fill that is inert, inorganic, and of a density sufficient to obtain the specified acoustic performance. Material must meet requirements of NFPA 90A with a flame spread index of 25 or less and smoke developed rating of 50 or less.

Acoustical and aerodynamic performance is indicated on schedules on the drawings.

LOUVERS

Louvers Provided by GPC:

Louvers are specified in the architectural section of these specifications.

AIR BLENDERS

Manufacturers: R-M Products, or approved equal.

Construct units of not less than .08 inch aluminum of all welded construction. Units to be completely fixed devices capable of providing mixed air temperatures within 6°F of the theoretical values.

AIR FLOW STATIONS

Air flow stations are specified in section 23 09 14.

PART 3 - EXECUTION

MANUAL VOLUME DAMPERS

Install manual volume dampers in each branch duct and for each grille, register, or diffuser as far away from the outlet as possible while still maintaining accessibility to the damper. Install so there is no flutter or vibration of the damper blade(s).

TURNING VANES

Install turning vanes in all rectangular, mitered elbows in accordance with SMACNA standards and/or manufacturer's recommendations.

Install double wall, airfoil, 2 inch radius vanes in ducts with vane runner length 18" or greater and air velocity less than 2000 fpm. Install double wall, airfoil, 4-1/2 inch radius vanes in ducts with vane runner length 18" or greater and air velocity 2000 fpm or greater.

If duct size changes in a mitered elbow, use single wall type vanes with a trailing edge extension. If duct size changes in a radius elbow or if short radius elbows must be used, install sheetmetal turning vanes in accordance with SMACNA Chart 4-1 and Figure 4-10.

FIRE DAMPERS

Install dampers in strict accordance with manufacturer's installation instructions. Install damper sleeves with retaining angles on both sides of rated partition. Connections of ductwork to fire damper assemblies to be as specified on the installation instructions. Where it is necessary to set dampers out from the rated wall, install a sleeve extension encased in two hour rated fire proofing insulation. Install an access door at each fire damper, located to permit resetting the damper replacing the fusible link.

Manually test each fire damper for proper operation by removing the fusible link. Repair or replace any fire damper that does not close completely. Re-install fusible link after test.

The A/E must coordinate the location of all fire dampers, smoke dampers and combination fire smoke dampers. All dampers must be installed in accessible locations and access to these dampers must be coordinated. The dampers must have adequate access to allow for servicing and testing of the dampers.

COMBINATION FIRE/SMOKE DAMPERS

Combination Fire/Smoke Damper Installation;

Install combination fire/smoke dampers in locations indicated on the drawings in accordance with the manufacturer's instructions. Install an access door adjacent to each damper for inspection and cleaning.

Coordinate damper linkage with operators so the dampers are closed when the air system is not operating.

CONTROL DAMPERS

Install dampers in locations indicated on the drawings, as detailed, and according to the manufacturer's instructions. Install blank-off plates or transitions where required for proper mixing of airstreams in mixing plenums. Provide adequate operating clearance and access to the operator. Install an access door adjacent to each control damper for inspection and maintenance.

SMOKE DETECTORS

Installation and wiring of detectors will be by the Electrical Contractor. Install an access door at each detector location.

When detectors are to be installed within air handling systems, show the intended location on the mechanical drawings and coordinate with the electrical consultant. It is very difficult to properly identify the correct location of detectors on the electrical drawings.

ACCESS DOORS

Install access doors where specified, indicated on the drawings, and in locations where maintenance, service, cleaning or inspection is required. Examples include, but are not limited to motorized dampers, fire and smoke dampers, smoke detectors, fan bearings, heating and cooling coils, filters, valves, and control devices needing periodic maintenance.

Size and numbers of duct access doors to be sufficient to perform the intended service. Minimum access door size shall be 8 x 8 inch size for hand access, 18 x 18 inch size for shoulder access, or other size as indicated. Install access doors on both inlet and outlet sides of reheat coils as well as other duct mounted coils.

Label fire, smoke and combination fire smoke dampers on the exterior surface of ductwork directly adjacent to access doors using a minimum of 0.5 inch height lettering reading, "SMOKE DAMPER" or "FIRE DAMPER". Smoke and combination fire smoke dampers shall also include a second line listing the individual damper tag. The tags must be coordinated with the mechanical schedules. Utilize stencils or

1 manufactured labels. All other forms of identification are unacceptable. All labels shall be clearly visible
2 from the ceiling access point.

3 **FLEXIBLE DUCT**

4 Flexible duct may only be used for final connections of air inlets and outlets at diffuser, register, and grille
5 locations. Where flexible duct is used, it shall be the minimum length required to make the final connections,
6 but no greater than 5 feet in length, and have no more than one (1) 90 degree bend.

7
8
9 Secure inner jacket of flexible duct in place with stainless steel metal band clamp. Secure insulation vapor
10 barrier jacket in place with steel or nylon draw band. Sheetmetal screws and/or duct tape will not be accepted.

11 Flexible duct used to compensate for misalignment of main duct or branch duct will not be accepted.

12
13 Individual sections of flexible ductwork shall be of one piece construction. Splicing of short sections will
14 not be accepted.

15 Flexible ductwork used as transfer duct shall be sized for a maximum velocity of 300 fpm.

16 Penetration of any partition, wall, or floor with flexible duct will not be accepted.

17 **FLASHINGS**

18 Flashing for roof curbs, equipment supports or rails located on roof, will be installed by others.

19 **DUCT FLEXIBLE CONNECTIONS**

20 Install at all duct connections to rotating or vibrating equipment, including air handling units (unless unit is
21 internally isolated), fans, or other motorized equipment in accordance with SMACNA Figure 7-8. Install
22 thrust restraints to prevent excess strain on duct flexible connections at fan inlets and outlets; see Related
23 Work.

24 For applications in corrosive environments or fume exhaust systems, use a double layer of the Teflon[®] coated
25 fabric when making the connector.

26 **SOUND ATTENUATORS**

27 Install sound attenuators in locations indicated on the drawings. Where modular installation is required,
28 install units in a galvanized steel frame equipped with gaskets or seals between modules to prevent bypass of
29 air.

30 **HOODS FOR INTAKE AND EXHAUST**

31 Install in locations indicated on the drawings, coordinating the roof opening location with the General Prime
32 Contractor. Curbs are covered in Section 23 05 29.

33 **LOUVERS**

34 Louvers are furnished and installed by others.

35 Furnish louvers to the General Prime Contractor for mounting in exterior walls. Connect outside air intake
36 duct to the louver, sealing all connections air and water tight.

37 Provide bird screen on inside of active louver area where none is provided with louvers. Where louvers are
38 equipped with inside birdscreen, remove screen at all locations where duct connections are not made.

39 Install insulated metal panel on unused portion of louver. Panels must be sealed weathertight to louver
40 assembly with flashing as required for proper drainage to outside of building. Paint outside surface of panel
41 to match louver prior to installation. Where ductwork is visible through louver when viewed from outside
42 the building, paint inside of duct to match louver color.

43 **AIR BLENDERS**

44 Install air mixing devices where indicated on the drawings and in strict accordance with manufacturer's
45 recommendations.

46 **AIR FLOW STATIONS**

47 Install where indicated on the drawings and/or as scheduled and in accordance with manufacturer's
48 recommendations.

1 Provide access doors upstream and downstream of all duct mounted air flow stations of the size necessary
2 for maintenance purposes. Minimum access door size shall be 8 x 8 inch size for hand access, 18 x 18 inch
3 size for shoulder access, or other size as indicated on the drawings.
4

5 **CONSTRUCTION VERIFICATION**

6 Contractor is responsible for utilizing the construction verification checklists supplied under specification
7 Section 23 08 00 in accordance with the procedures defined for construction verification in Section 01 91 01
8 or 01 91 02.
9

10 **END OF SECTION**